



TAFLA T.1.G.8

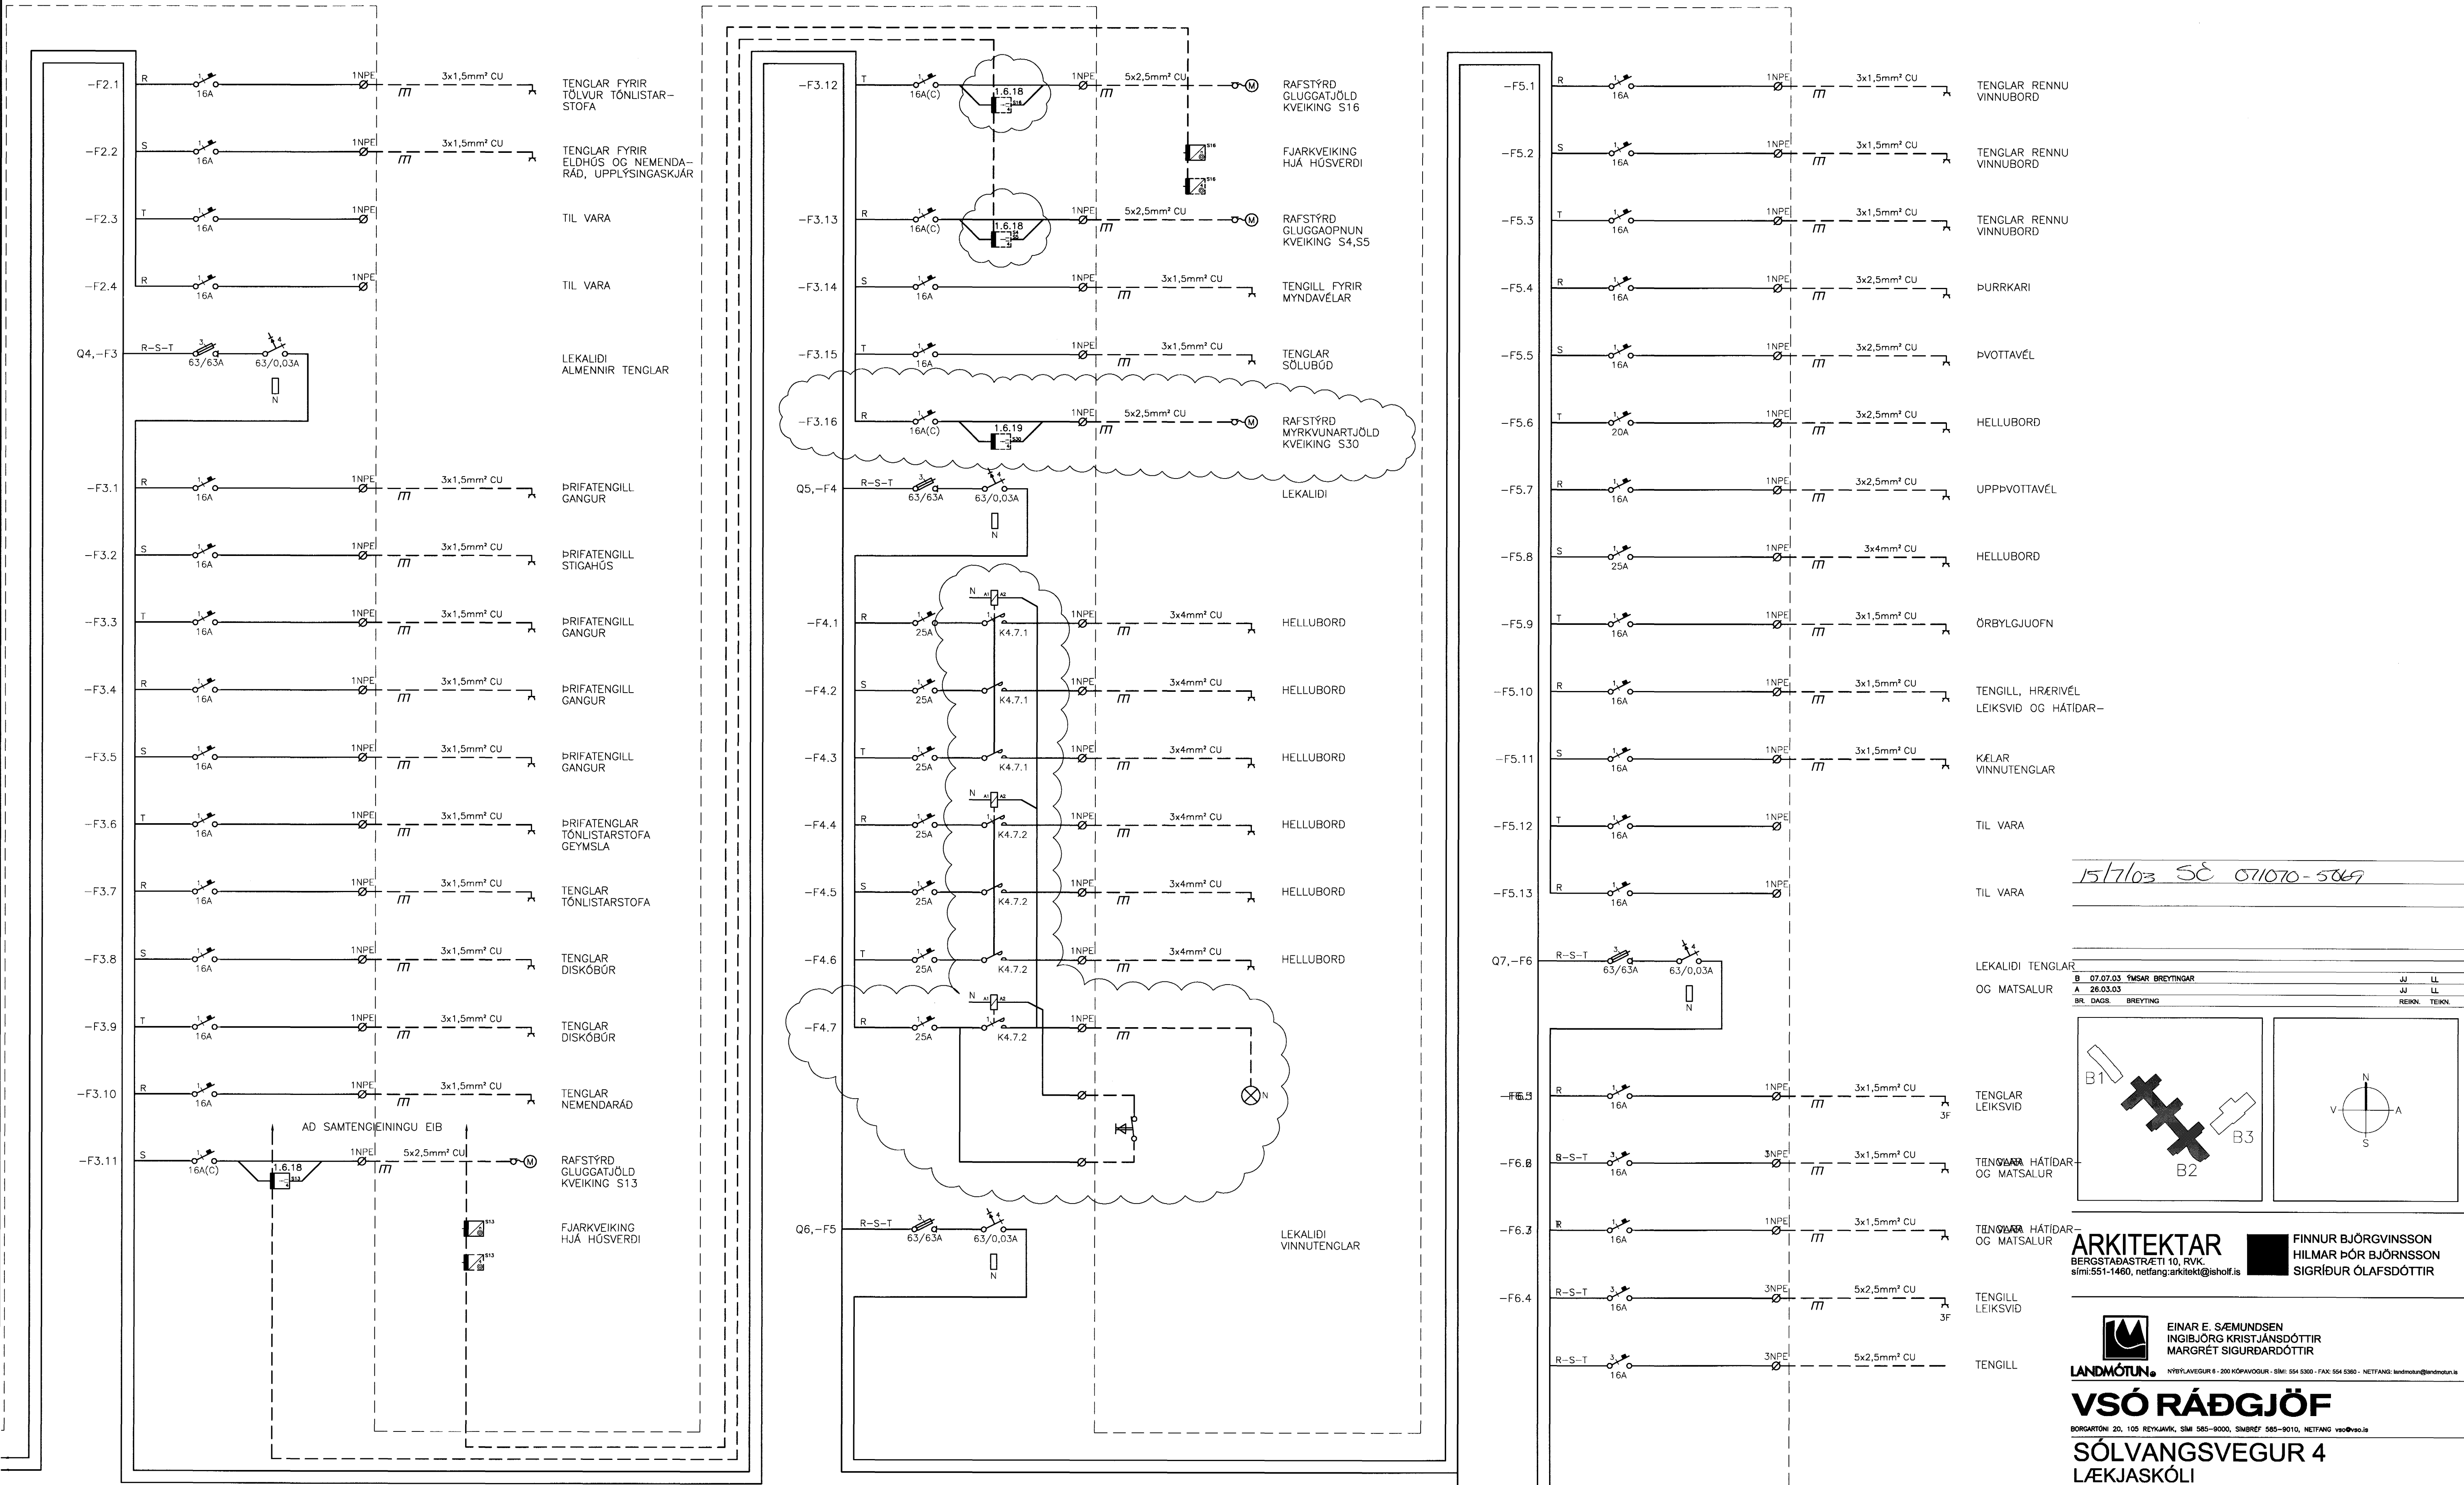

15/7/03 SE 071070-5069

B	07.07.03	ÞUSAR BREYTINGAR	JJ	LL
A	26.03.03		JJ	LL
BR.	DAGS.	BREYTING	REKNI.	TEIKN.

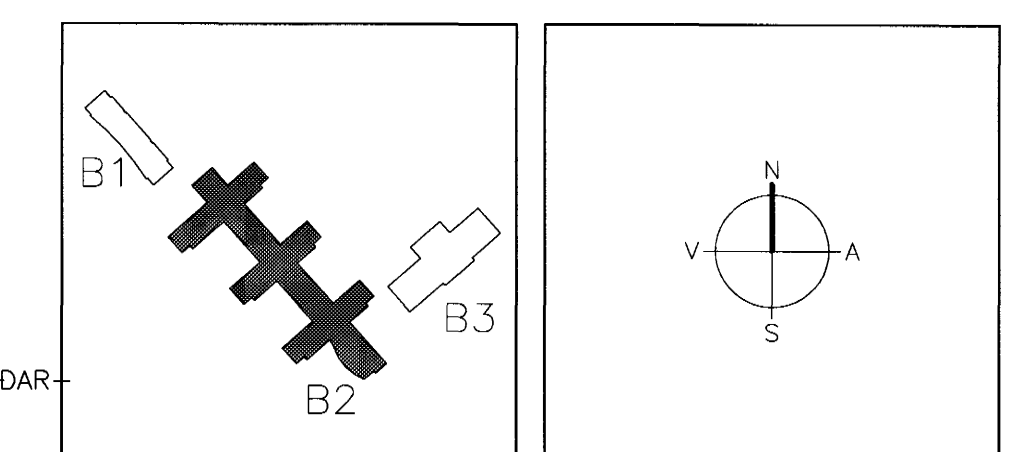

ARKITEKTAR
BERGSTADASTRÆTI 10, RVK
Sími: 551-1460, netfang:arkitekt@ishoff.is

FINNUR BJÖRGVINSSON
HILMAR ÞÓR BJÖRNSSON
SIGRÍÐUR ÓLAFSDÓTTIR

LANDMÓTUN. HÝRILAVESUR 4 - 200 KÓPAVOGUR. Sími: 554 5300 - FAX: 554 5360 - NETFANG: landmotun@landmotun.is

VSÓ RÁÐGJÖF
BORGARTÚNI 20, 105 REYKJAVÍK. Sími: 585-9000, Símréfi: 585-9010, NETFANG: vs@vs.is

SÓLVANGSVEGUR 4
LÆKJASKÓLI

RAFORKUMRKI EINLÍNUNYND GREINATAFLA 1. HÆÐ T.1.G.8	HANUD/TEIKN. ATH. <i>SA</i> SAMÞYKKT KT. <i>SA</i> REYKJAVÍK 11.06.2002	JJ/005 110656-7789
KVARDI VERKNI. 00258	TEIKN. NR. B2-R1-VE1-009	BR. B

SJÁ TEIKN. B2-R1-VE1-008