



TAFLA T.1.G.10

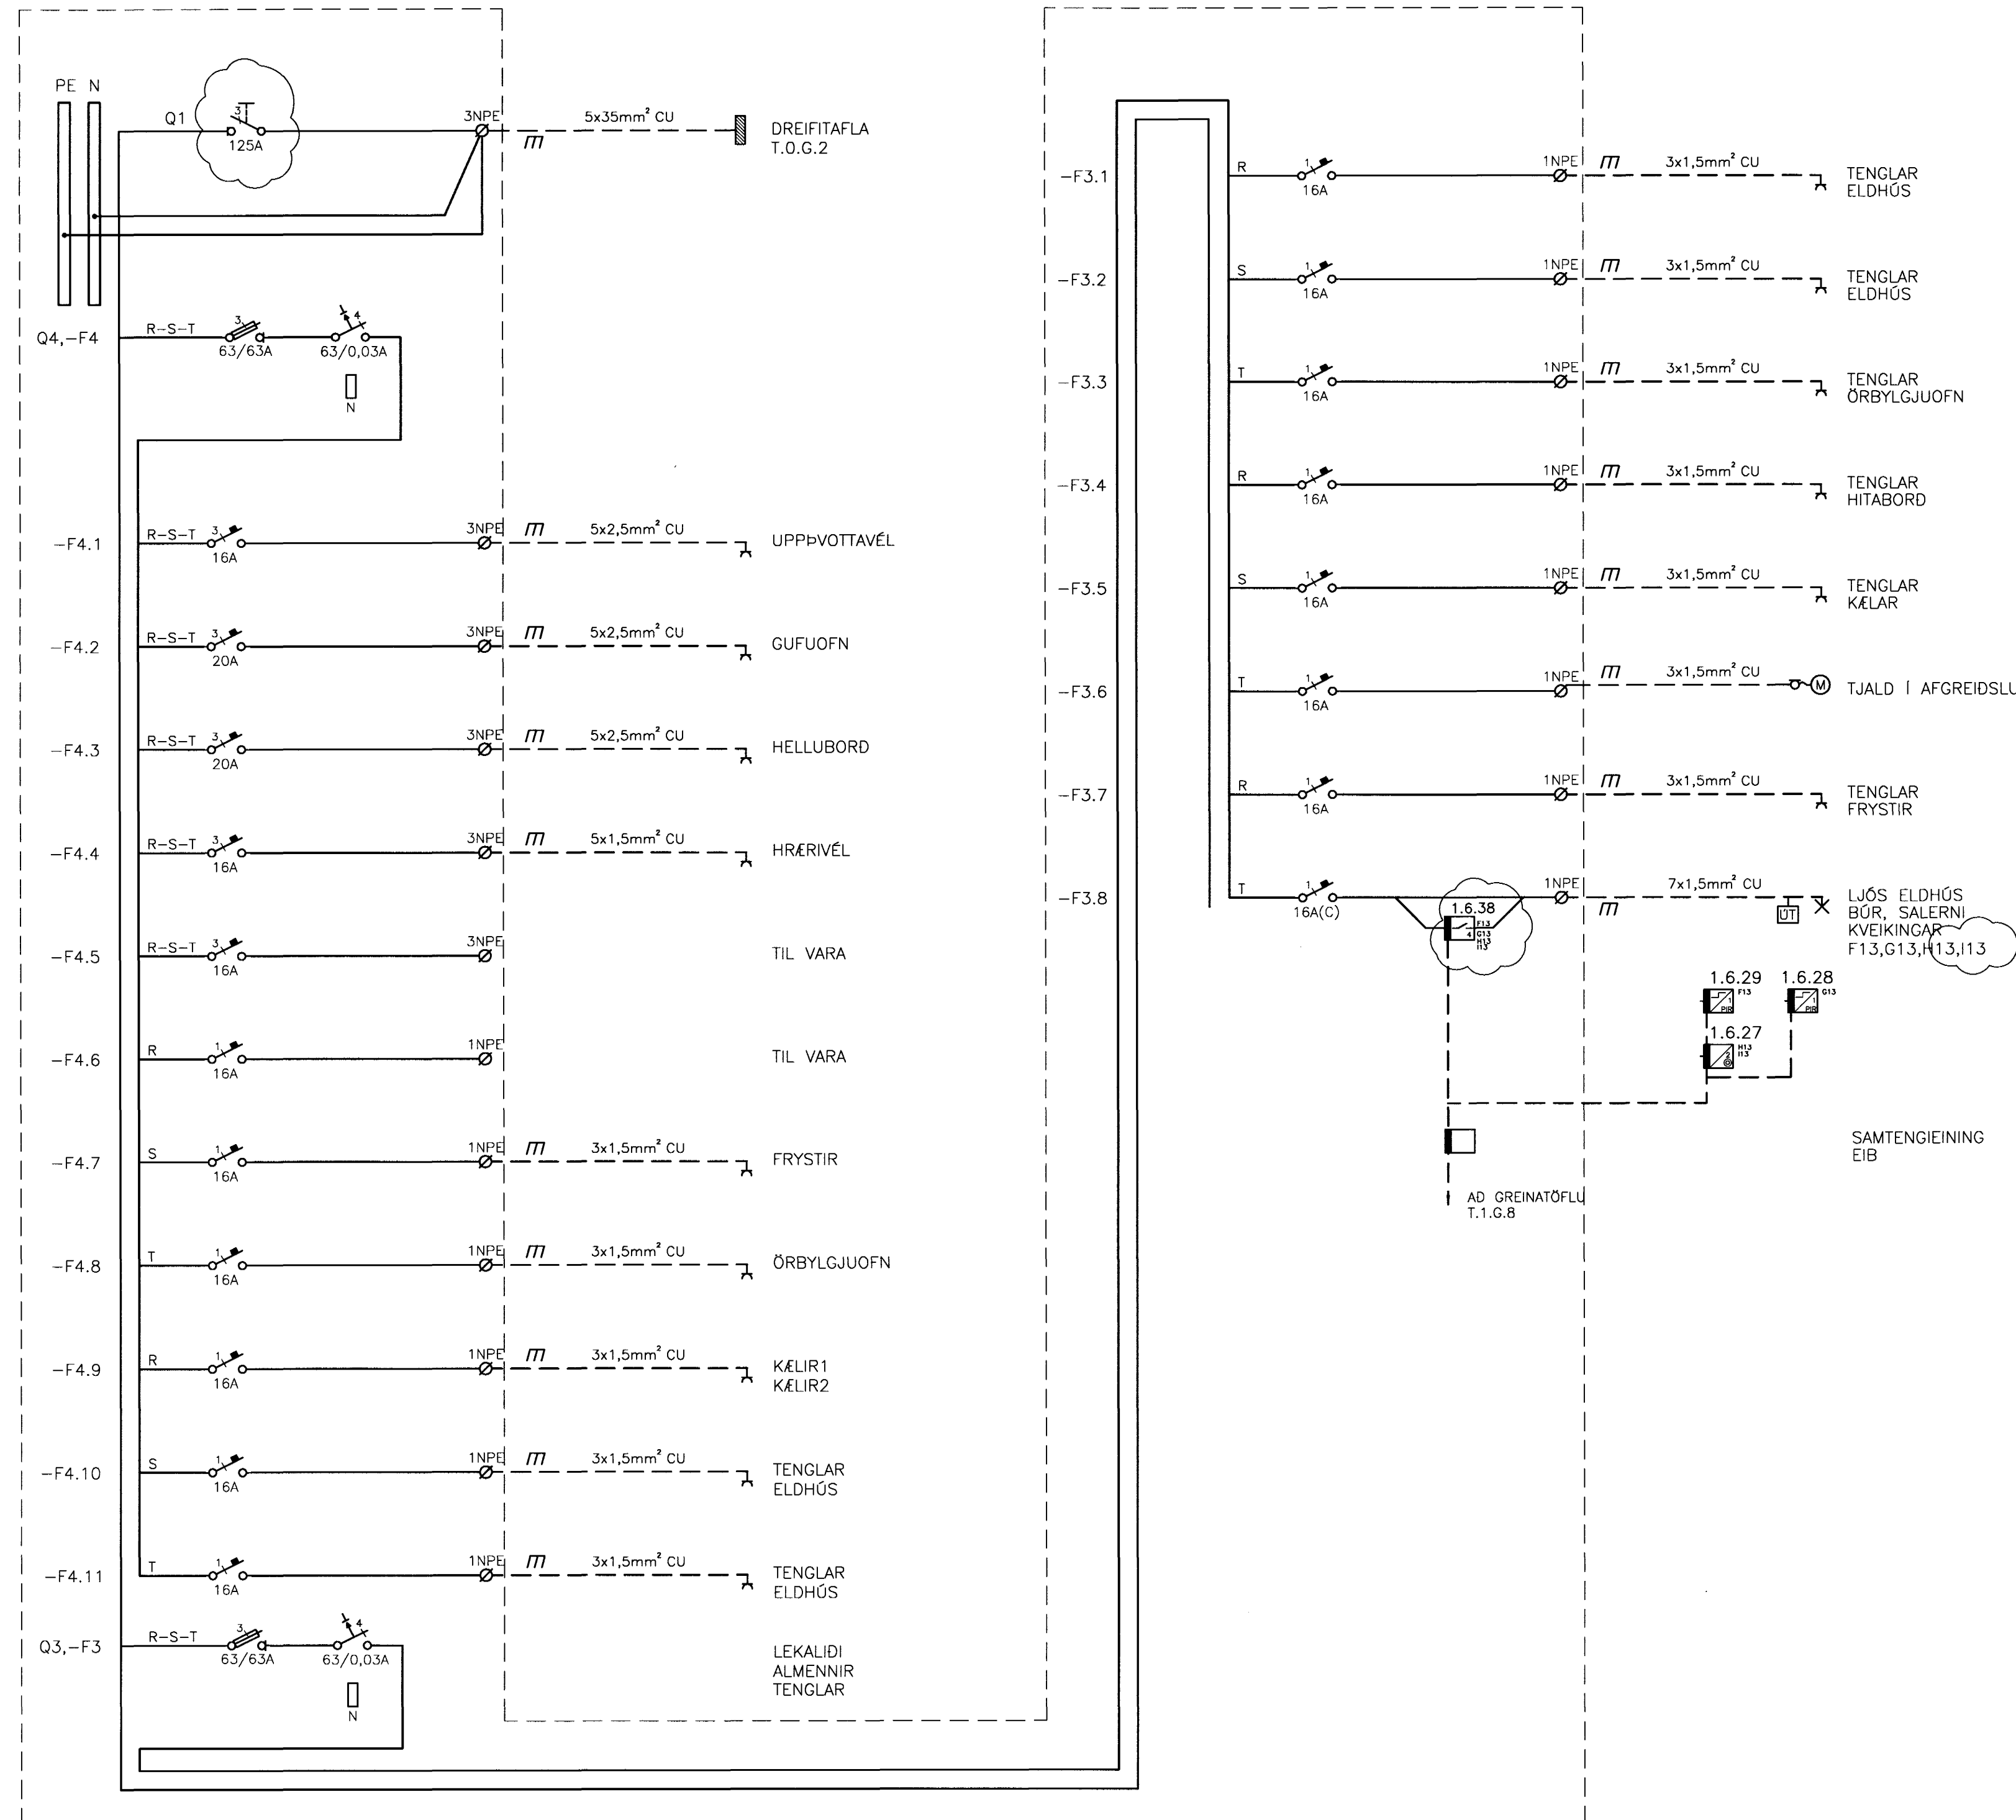

15/7/03 SC 071070-5069

B	07.07.03	ÞMSAR BREYTINGAR	JJ	LL
A	26.03.03		JJ	LL
BR.	DAGS.	BREYTING	REIKN.	TEIKN.

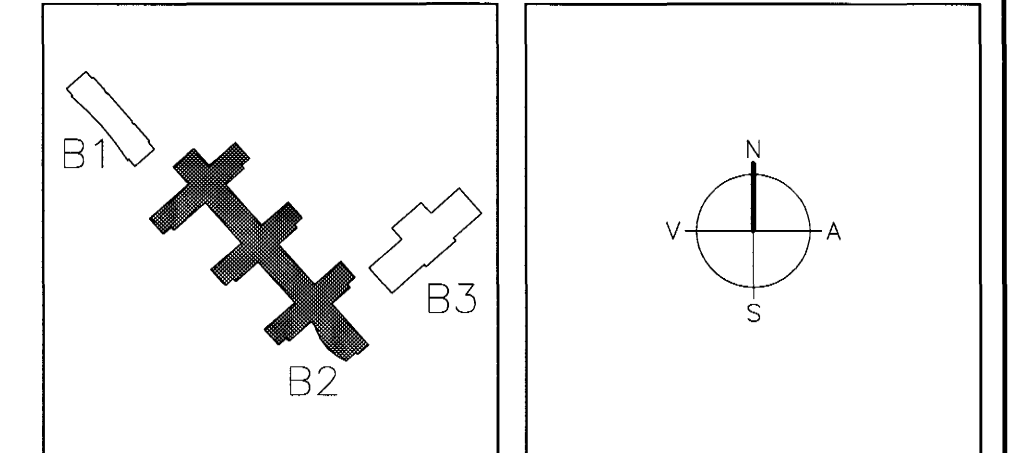

ARKITEKTAR
 BERGSTADASTRÆTI 10, RVK.
 sími: 551-1460, netfang: arkitekti@isholf.is

FINNUR BJÖRGVINSSON
HILMAR ÞÓR BJÖRNSSON
SIGRÍÐUR ÓLAFSDÓTTIR

LANDMÖTUN.
 HVERFANGUR 6-200 KÓPAVOGUR - Sími: 554 5300 - FAX: 554 5300 - NETFANG: landmur@landmur.is

EINAR E. SÆMUNDSEN
INGIBJÖRG KRISTJÁNSDÓTTIR
MARGRÉT SIGURDARDÓTTIR

VSÓ RÁÐGJÖF
 BORGARTÚNI 20, 105 REYKJAVÍK, Sími: 585-9000, Símbref: 585-9010, Netfang: vs@vs.is

SÓLVANGSVEGUR 4
LÆKJARSKÓLI

RAFORKUMIRKI	HANNA/TEIKN.	JJ/LL
EINLÍNUMYND	ATH. <i>ES</i>	
GREINATAFLA 1. HÉÐ	SAMÞYKKT <i>SH</i>	
T.1.G.10	KT.	110856-7789
KVARDI	REYKJAVÍK	15.05.2002
VERKNR.	TEIKN. NR.	BR.

00258 B2-R1-VE1-011 B