



TAFLA T.2.G.4

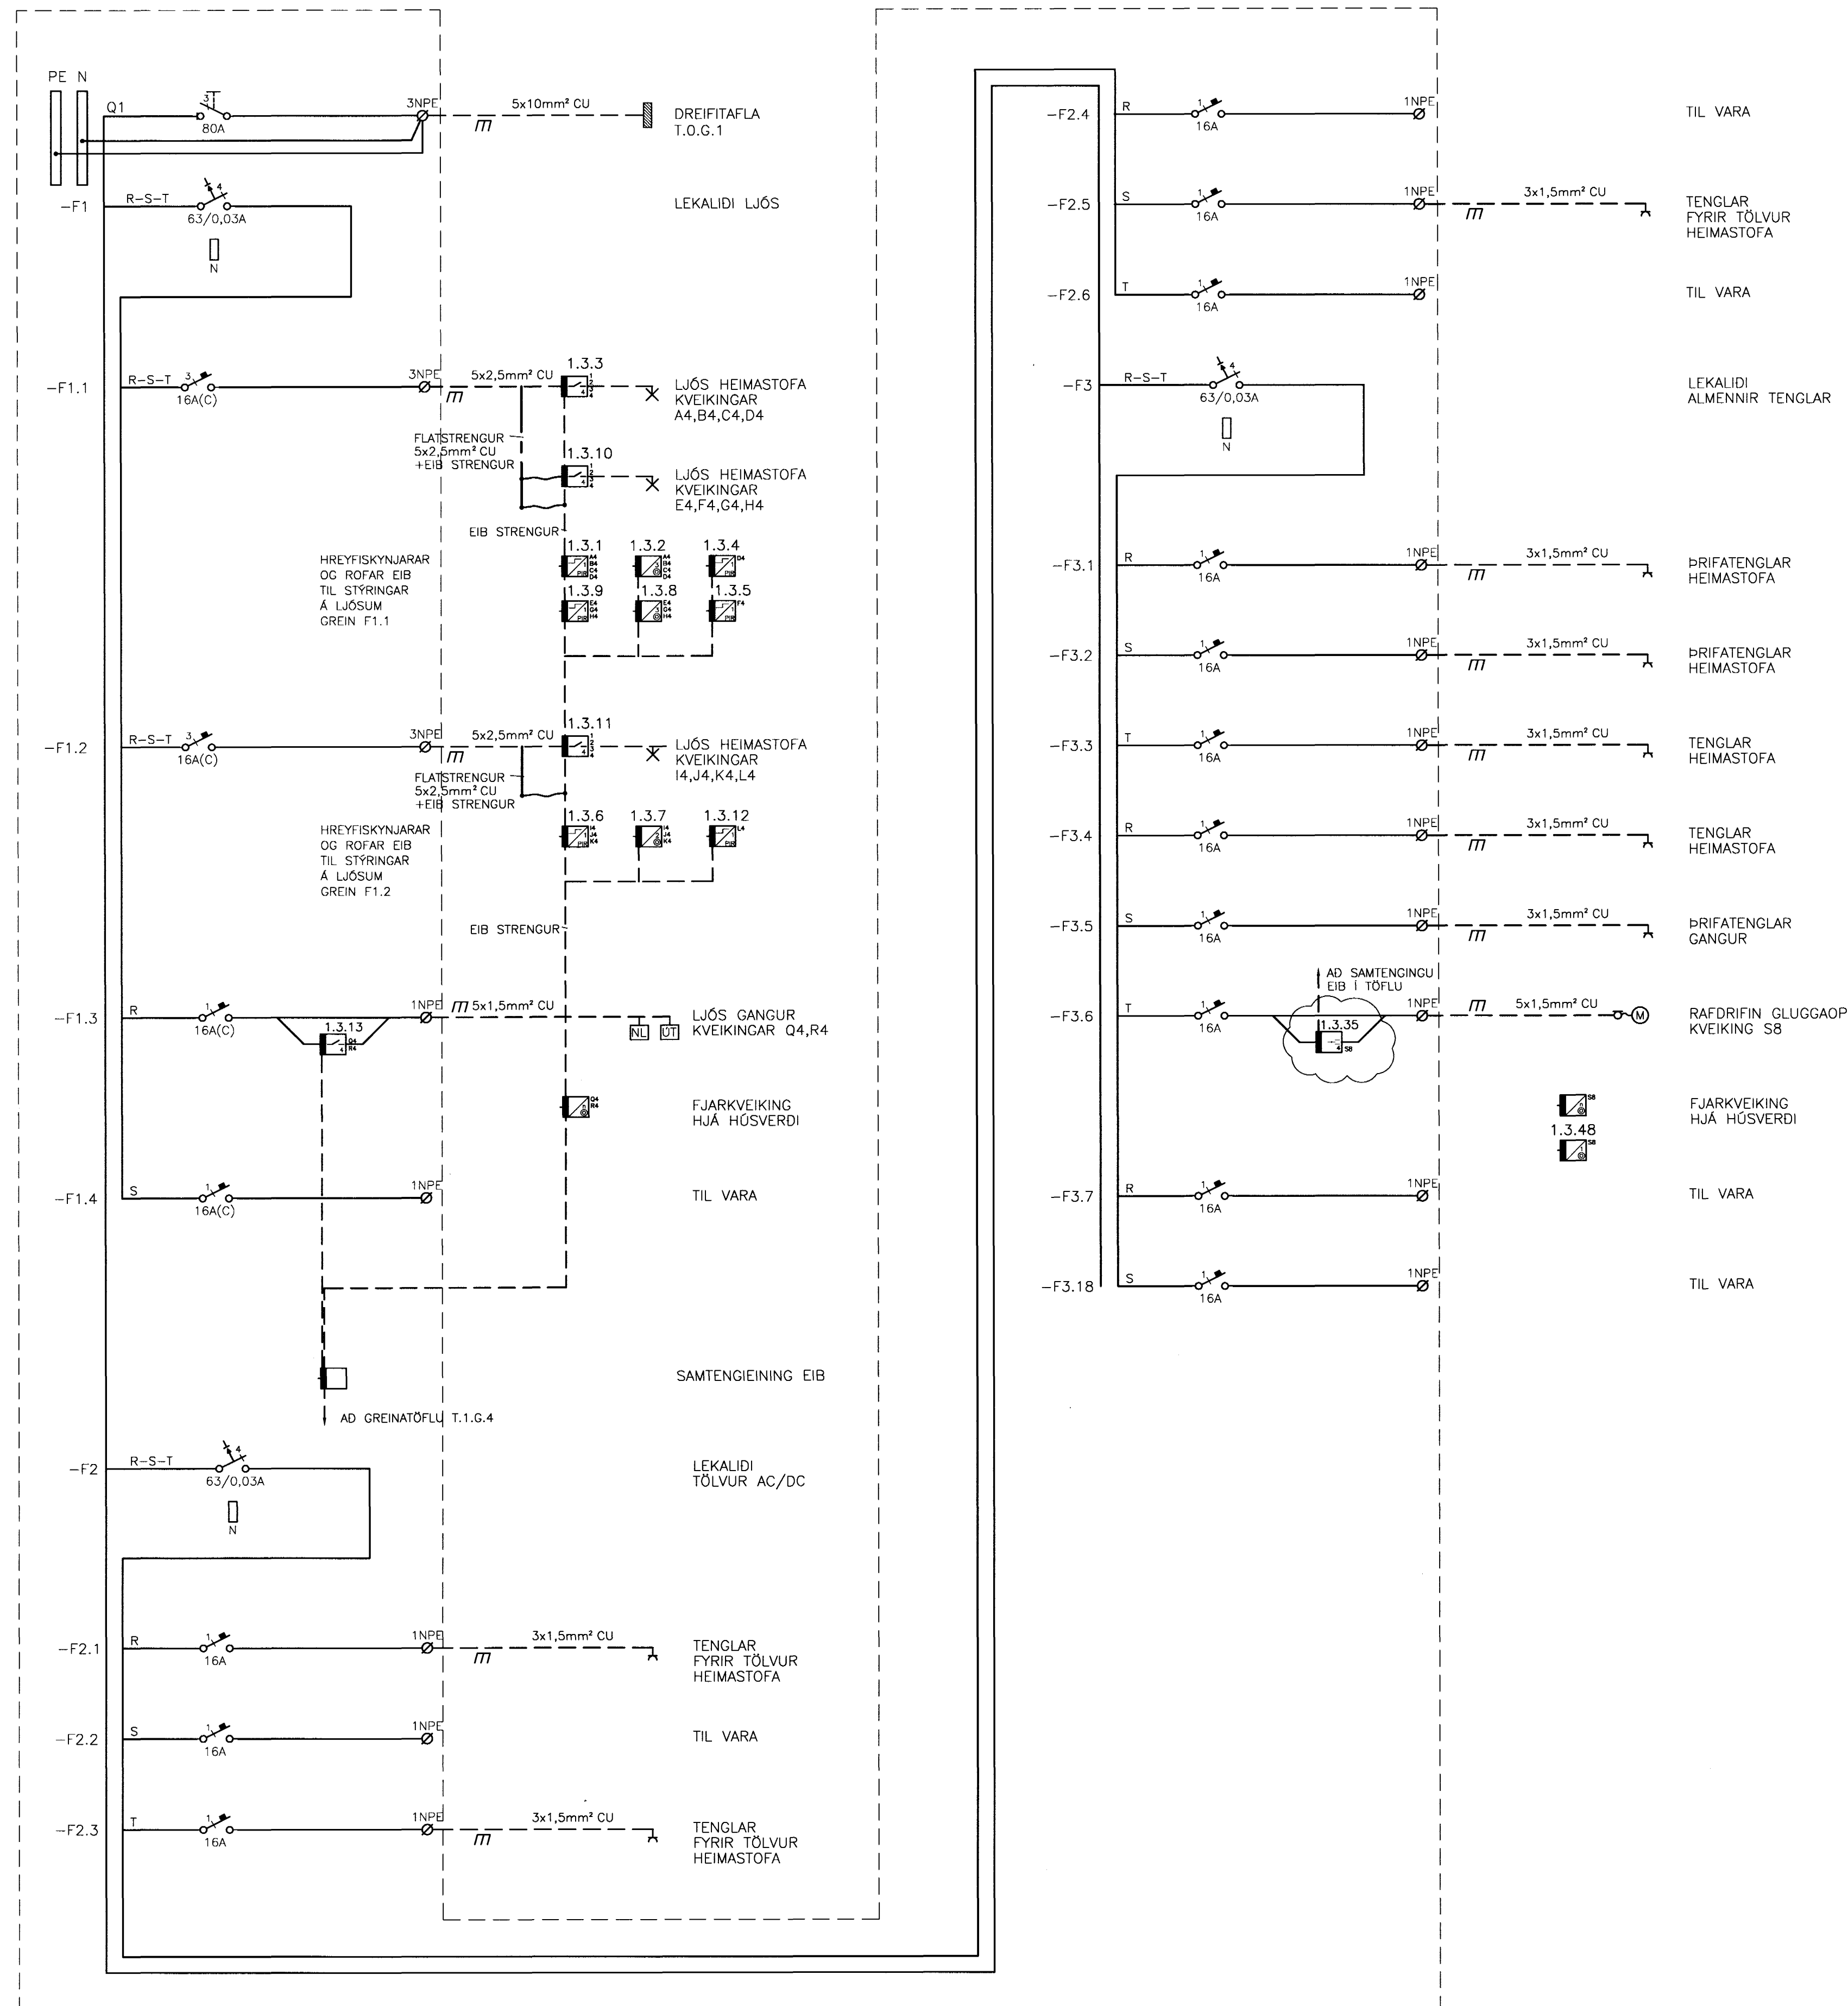

15/7/03 SC 071070-5069

B	07.07.03	JJ	LL
A	26.03.03	JJ	LL
BR.	DAGS.	BREYTING	REIKN. TEIKN.

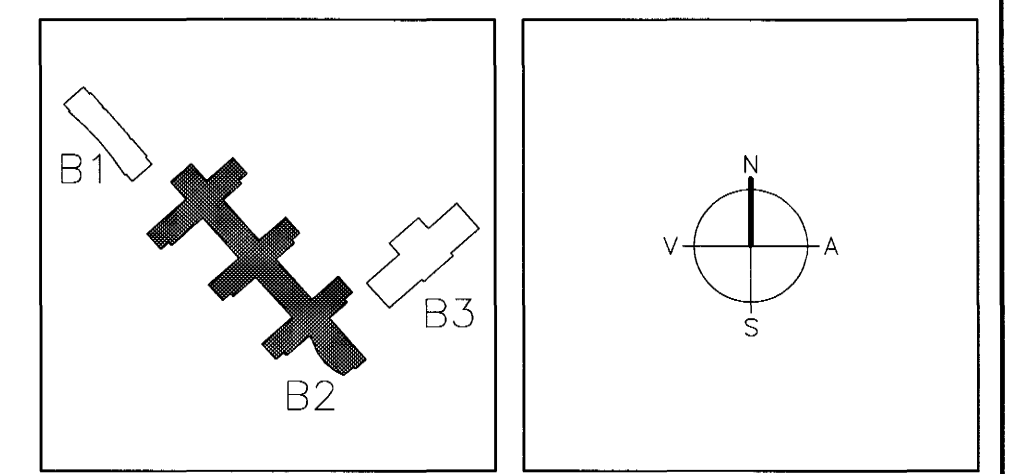

ARKITEKTAR FINNUR BJÖRGVINSSON
 BERGSTADASTRÆTI 10, RVK HILMAR ÞÓR BJÖRNSSON
 sími:551-1460, netfang:arkitekt@isholf.is SIGRÍÐUR ÓLAFSDÓTTIR

LANDMÖTUN. EINAR E. SÆMUNDSEN
 INGIBJÖRG KRISTJÁNSDÓTTIR MARGRÉT SIGURDARDÓTTIR
 HRYLLAVEGUR 6 - 200 KOPAVOGUR - Sími: 554 0300 - FAX: 554 5360 - NETFANG: landmotun@landmotun.is

VSÓ RÁÐGJÖF
 HÖRGAÐIÐ 20, 105 REYKJAVÍK. Sími: 585-9000, Símbref: 585-9010, Netfang: vs@vs.is
SÓLVANGSVEGUR 4
LÆKJASKÓLI

RAFORKLVRKI EINLÍNUMYND GREINATAFLA 2. HÆD T.2.G.4	HANNA/TEIKN ATH: <i>EX</i> SAMÞYKKT KT. <i>su</i>	JJ/LL
KVARDI VERNR.	REYKJAVÍK	110856-7766
00258	TEIKN. NR. B2-R1-VE2-004	BR. B