
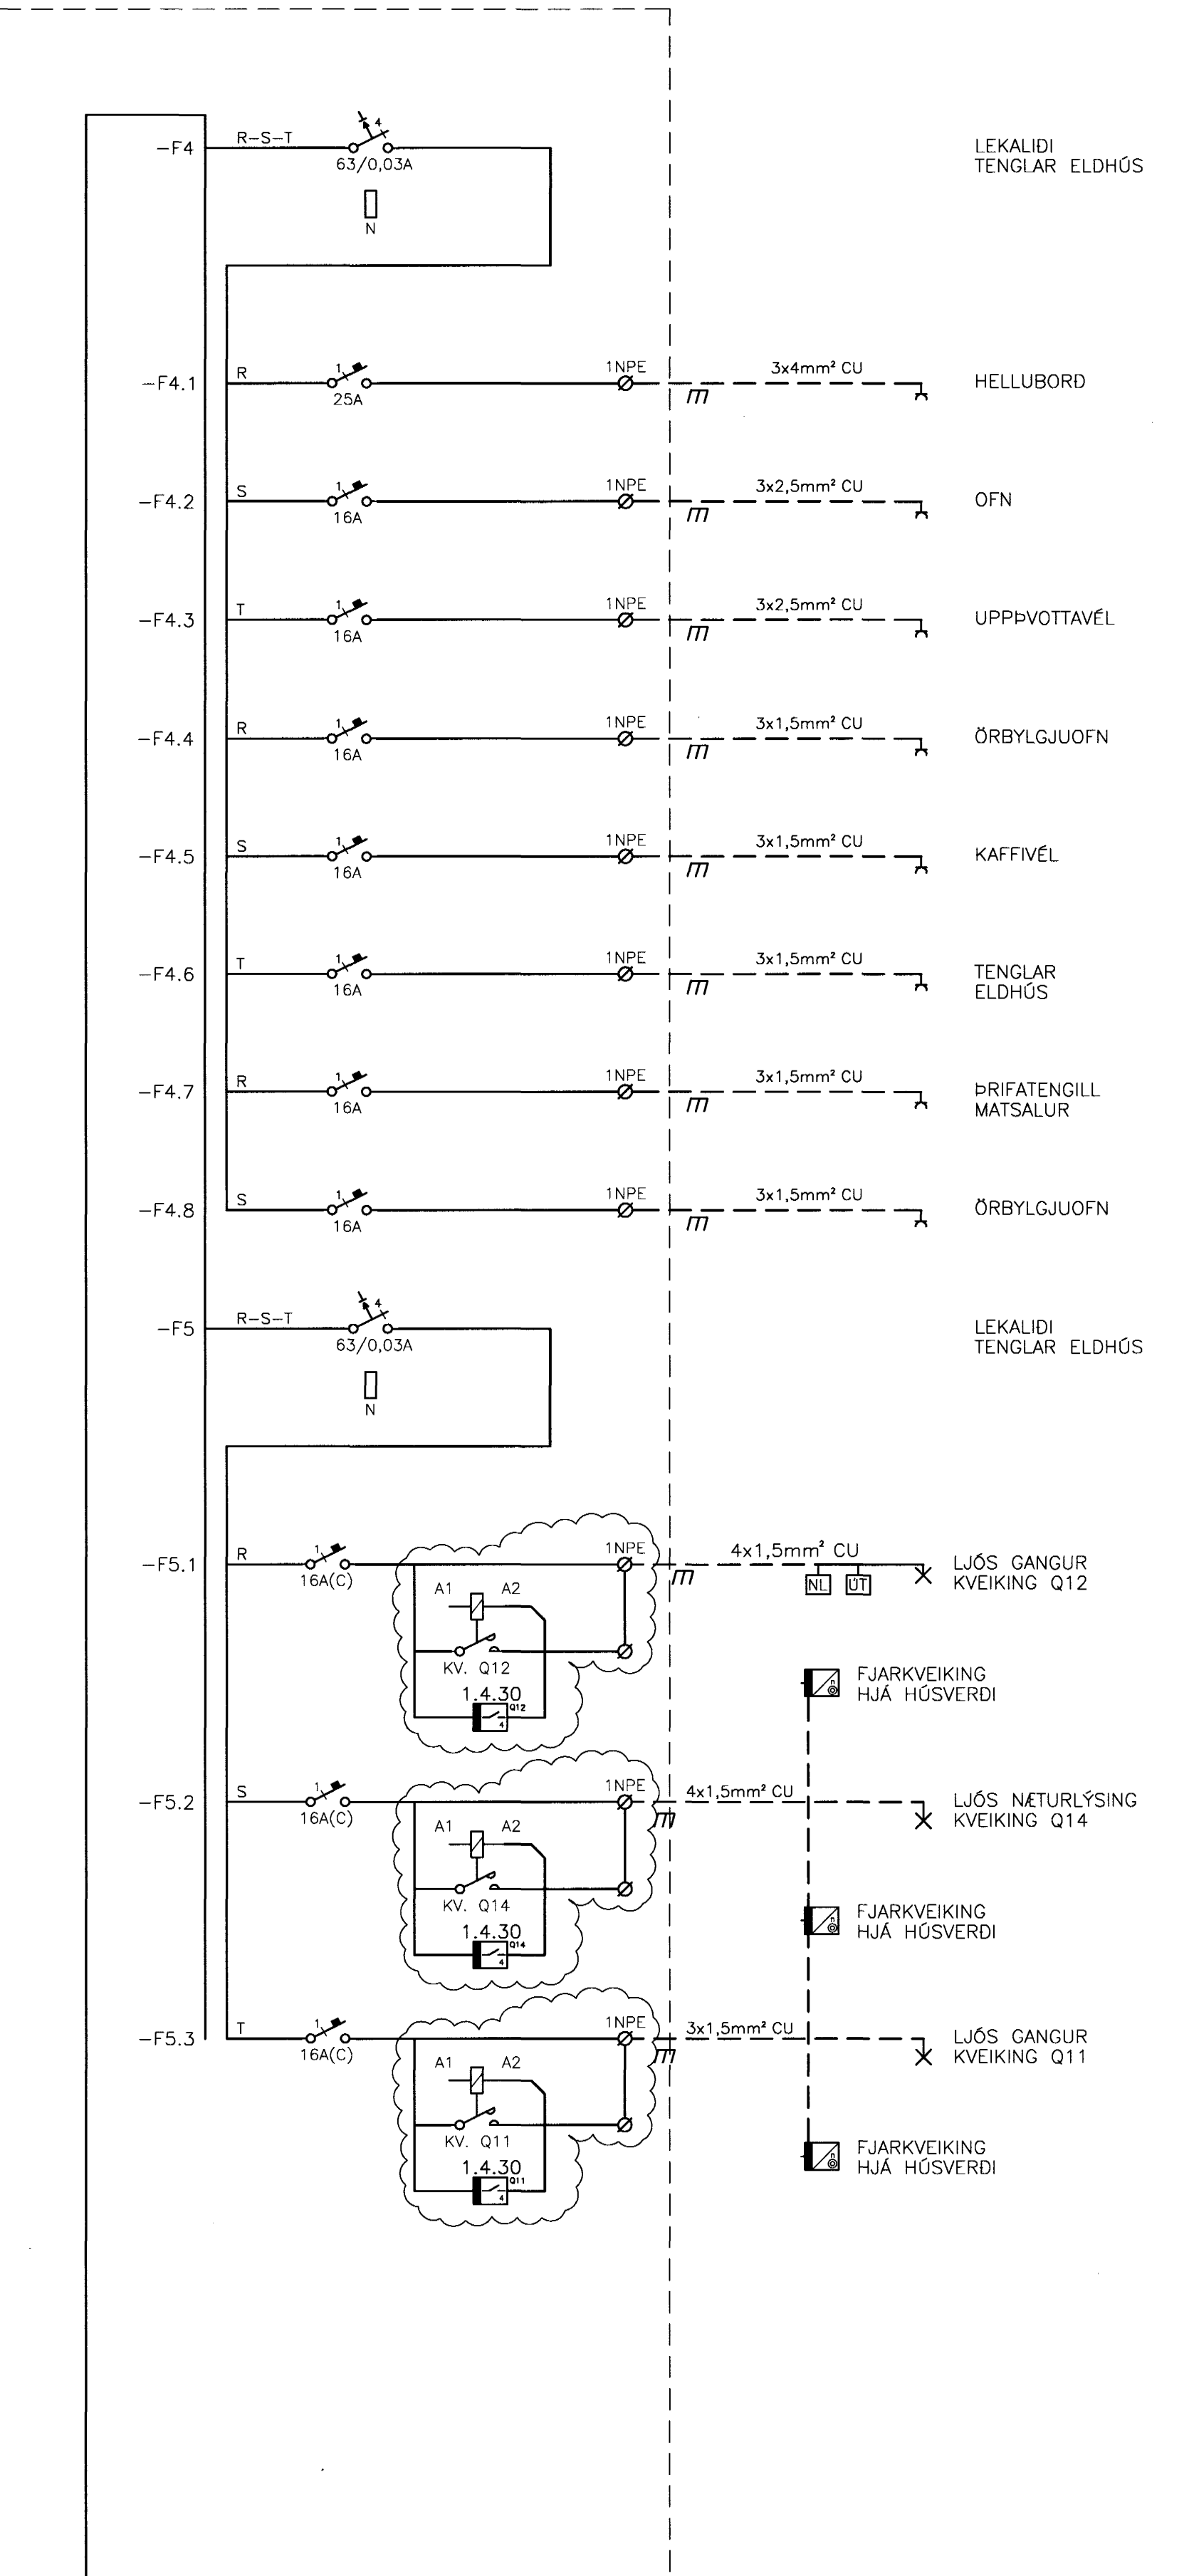



TAFLA T.2.G.5

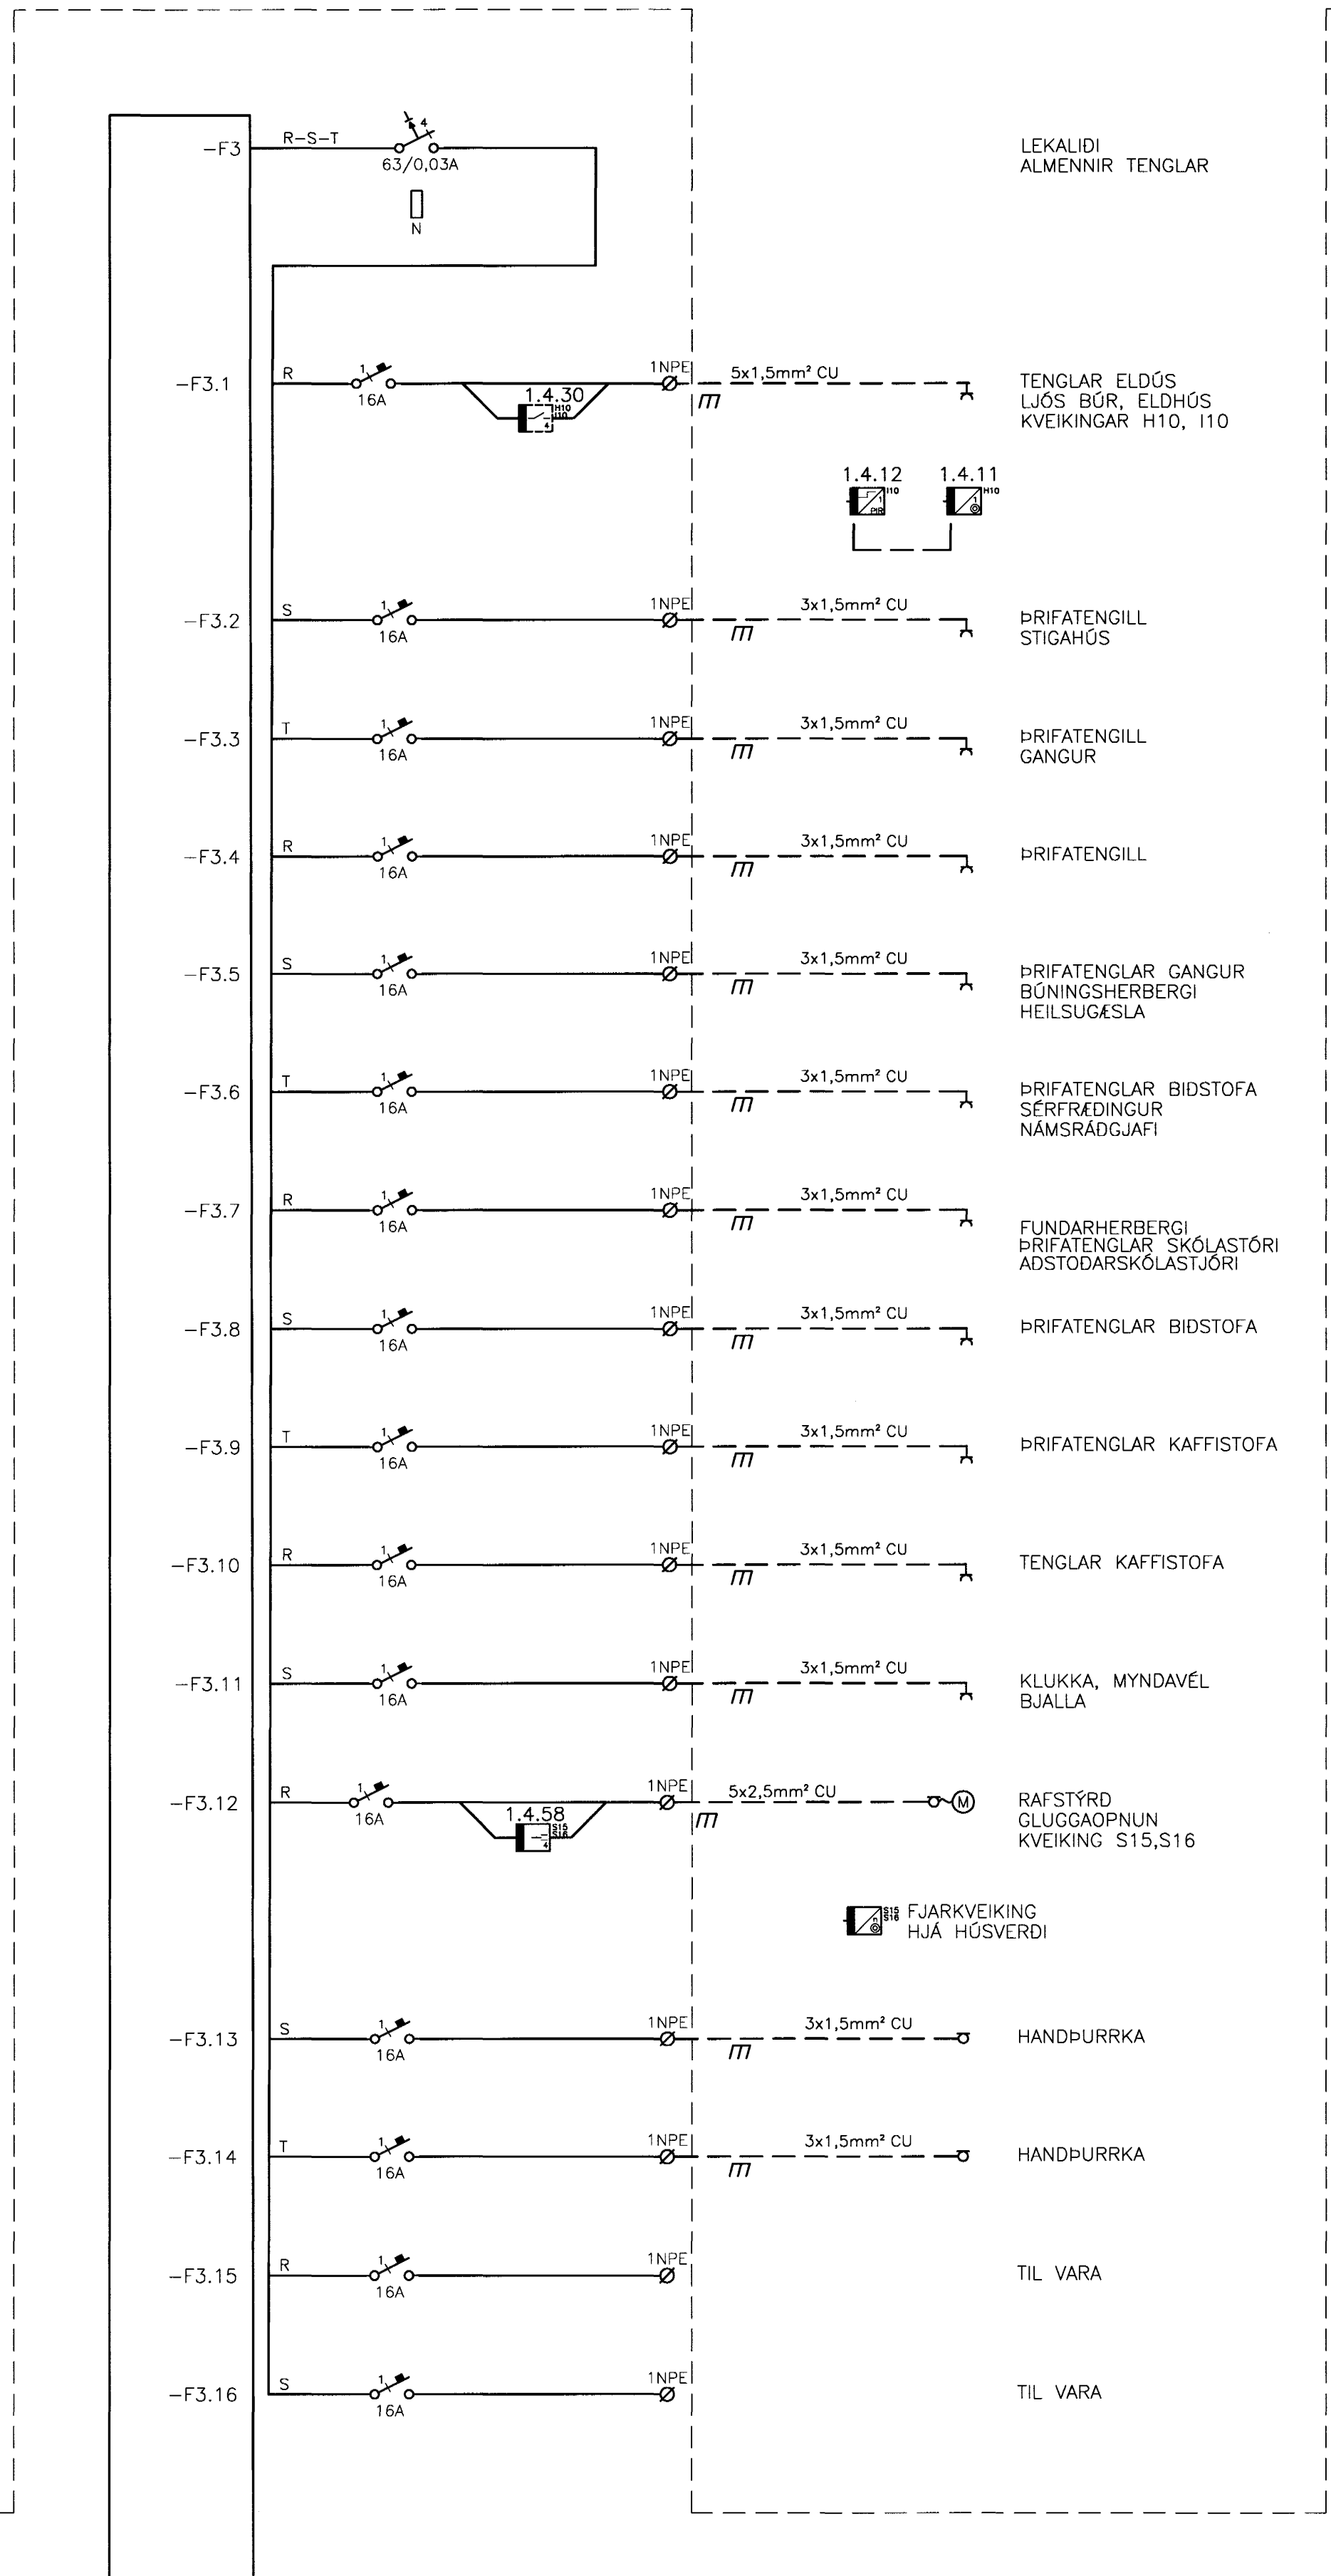

SJÁ TEIKN. B2-R1-VE2-005

15/7/03 SC 071070-5069

B	07.07.03	VIÐBÓT SPÖLURÓFI 16A-230V	JJ	VK
A	26.03.03		JJ	LL
BR.	DAGS.	BREYTING	REIKN.	TEIKN.

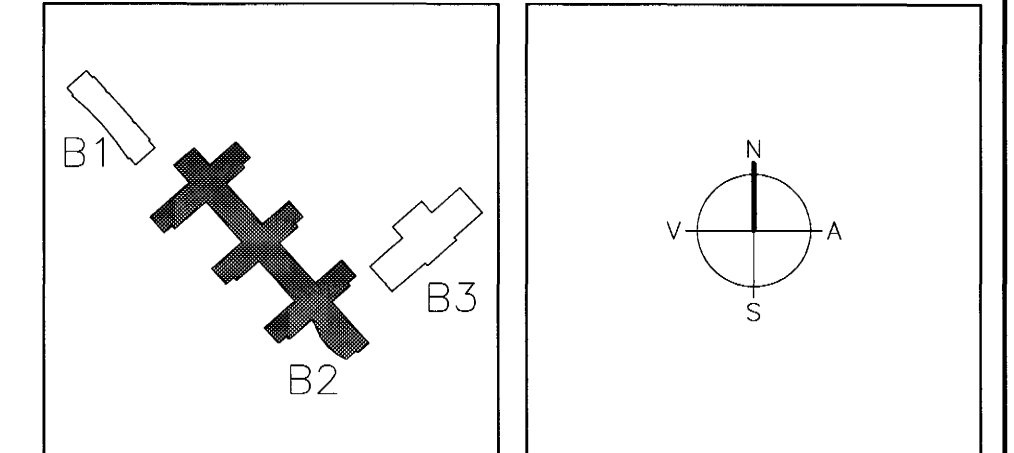

ARKITEKTAR
BERGSTADASTRÆTTI 10, RVK,
Sími: 551-1460, netfang: arkitekt@lahoff.is

FINNUR BJÖRGVINSSON
HILMAR ÞÓR BJÖRNSSON
SIGRÍÐUR ÓLAFSDÓTTIR

LANDMÖTUN.
EINAR E. SÆMUNDSEN
INGIBJÖRG KRISTJÁNSDÓTTIR
MARGRÉT SIGURDÁRSDÓTTIR
NYTELINGUR 6 - 200 KÖPVAOGUR - Sími: 554 5300 - FAX: 554 5300 - NETFANG: landmotun@landmotun.is

VSÓ RÁÐGJÖF
BORGARTÚNI 20, 105 REYKJAVÍK, Sími: 565-9000, Símbref: 565-9010, NETFANG: vs@vso.is

SÖLVANGSVEGUR 4
LÆKJASKÓLI

RAFORKUVRIRKI
EINLÍNUMYND
GREINATAFLA 2. HÉÐ
T.2.G.5

HANNAÐ/TEIKN. JJ/LJ/028
ATH. S
SAMÞYKKT S
KT. 110506-7769
REYKJAVÍK 15.05.2002

KVARNR. 00258
TEIKN. NR. B2-R1-VE2-006
BR. B