



TAFLA T.2.G.7

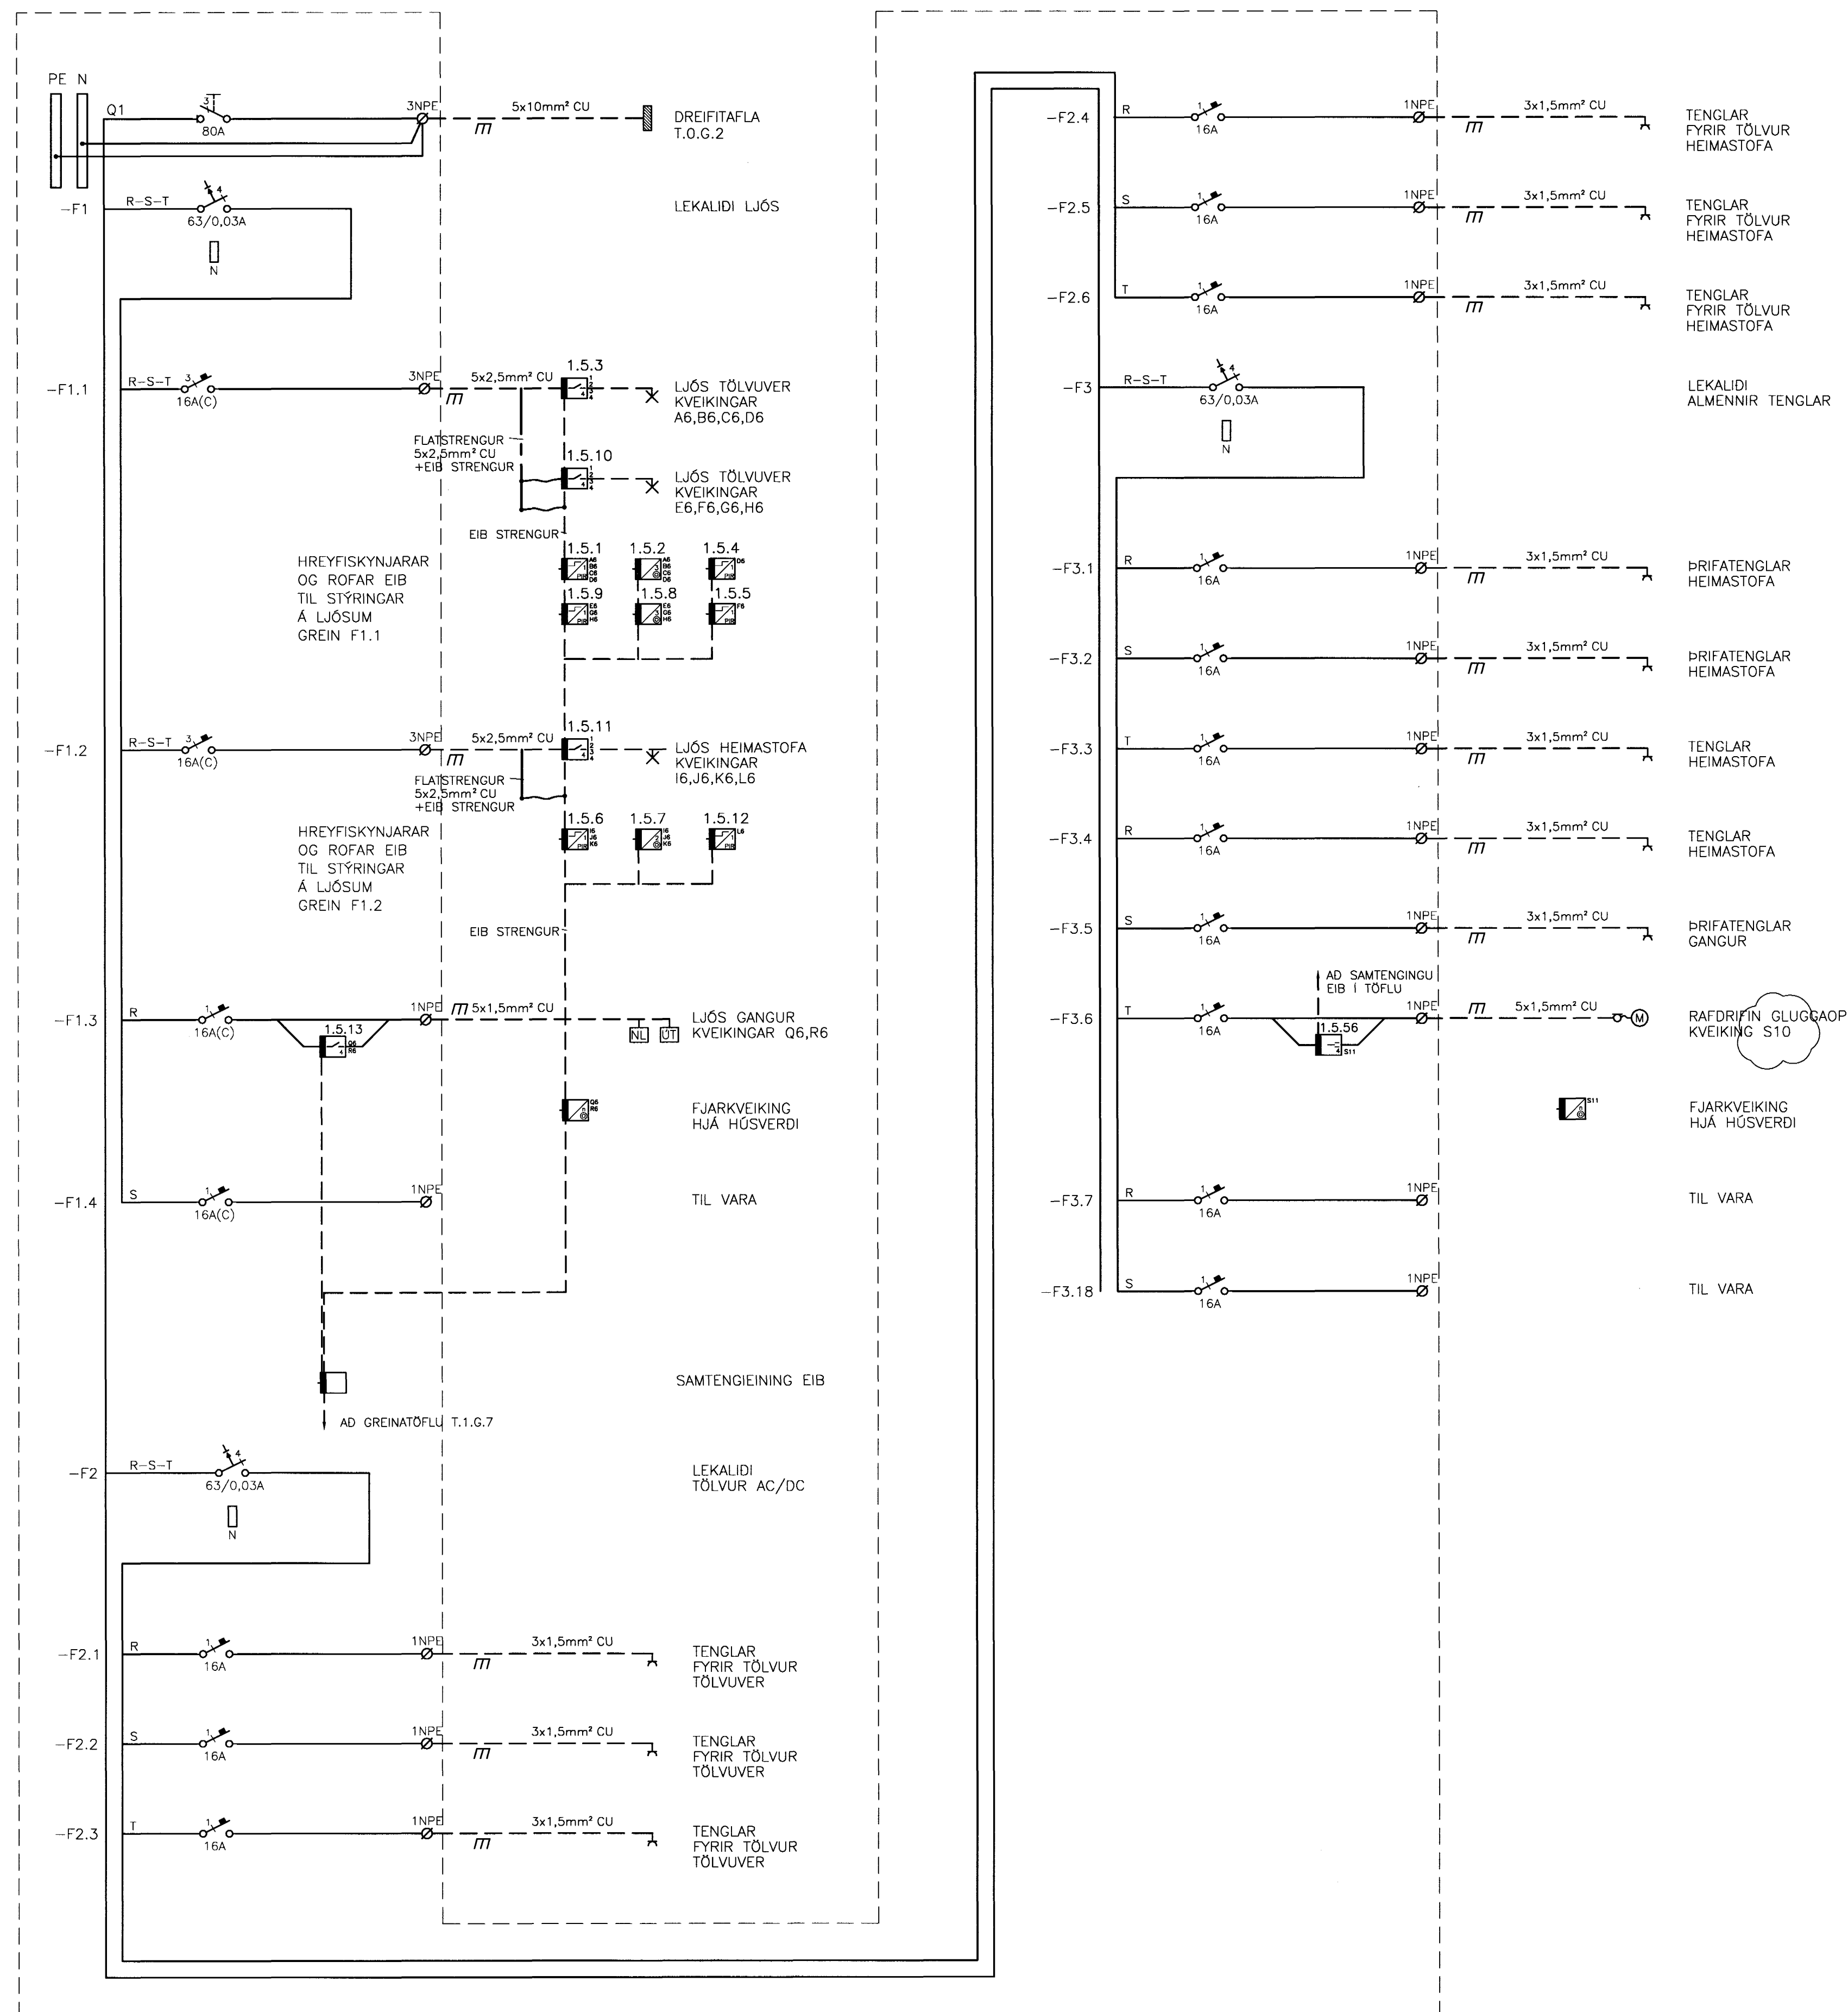

15/103 SÉ 071070-5069

C	07.07.03	JJ	LL
B	26.06.03	REYNDARTEKNIK	JJ
A	26.03.03	JJ	LL
BR.	DAGS.	BREYTING	REIKN.

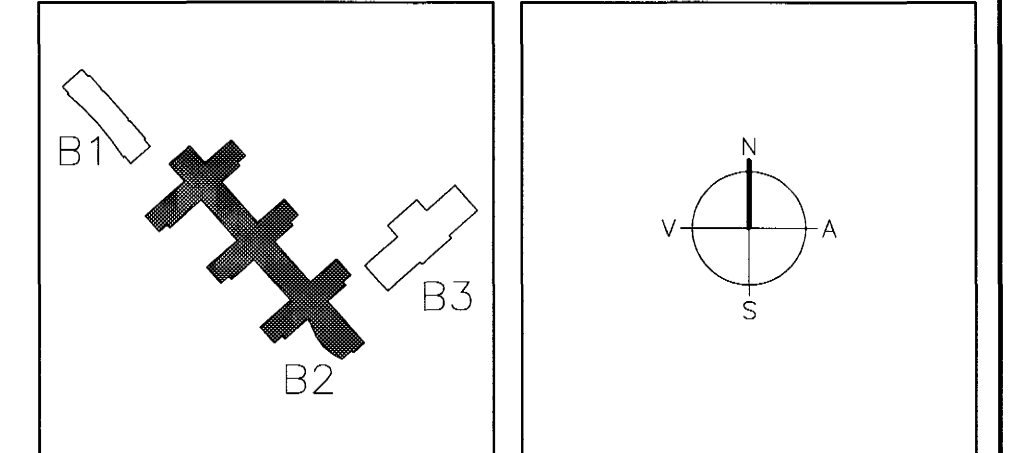

ARKITEKTAR FINNUR BJÖRGVINSSON
 BERGSTADASTRÆTI 10, RVK
 sími: 551-1460, netfang: arkitekt@isholf.is
 HILMAR ÞÓR BJÖRNSSON
 SIGRÍÐUR ÓLAFSDÓTTIR

LANDMÖTUN. EINAR E. SÆMUNDSEN
 INGIBJÖRG KRISTJÁNSDÓTTIR
 MARGRÉT SIGURDARDÓTTIR
 NYPLAVÆGIRI 6 - 200 KÖPVAEGUR - Sími: 554 5300 - FAX: 554 5300 - NETFANG: landmotun@landmotun.is

VSÓ RÁÐGJÖF
 SÓLVANGSVEGUR 4
 LÆKJASKÓLI

RAFORKLIVIRKI
 EINLÍNUMYND
 GREINATAFLA 2. HED
 T.2.G.7
 HANNAÐ/TEIKN. JJ/LL
 ATH. SAMPYKKT
 KT. 110856-7788
 REYKJAVIK 15.05.2002