



TAFLA T.2.G.8

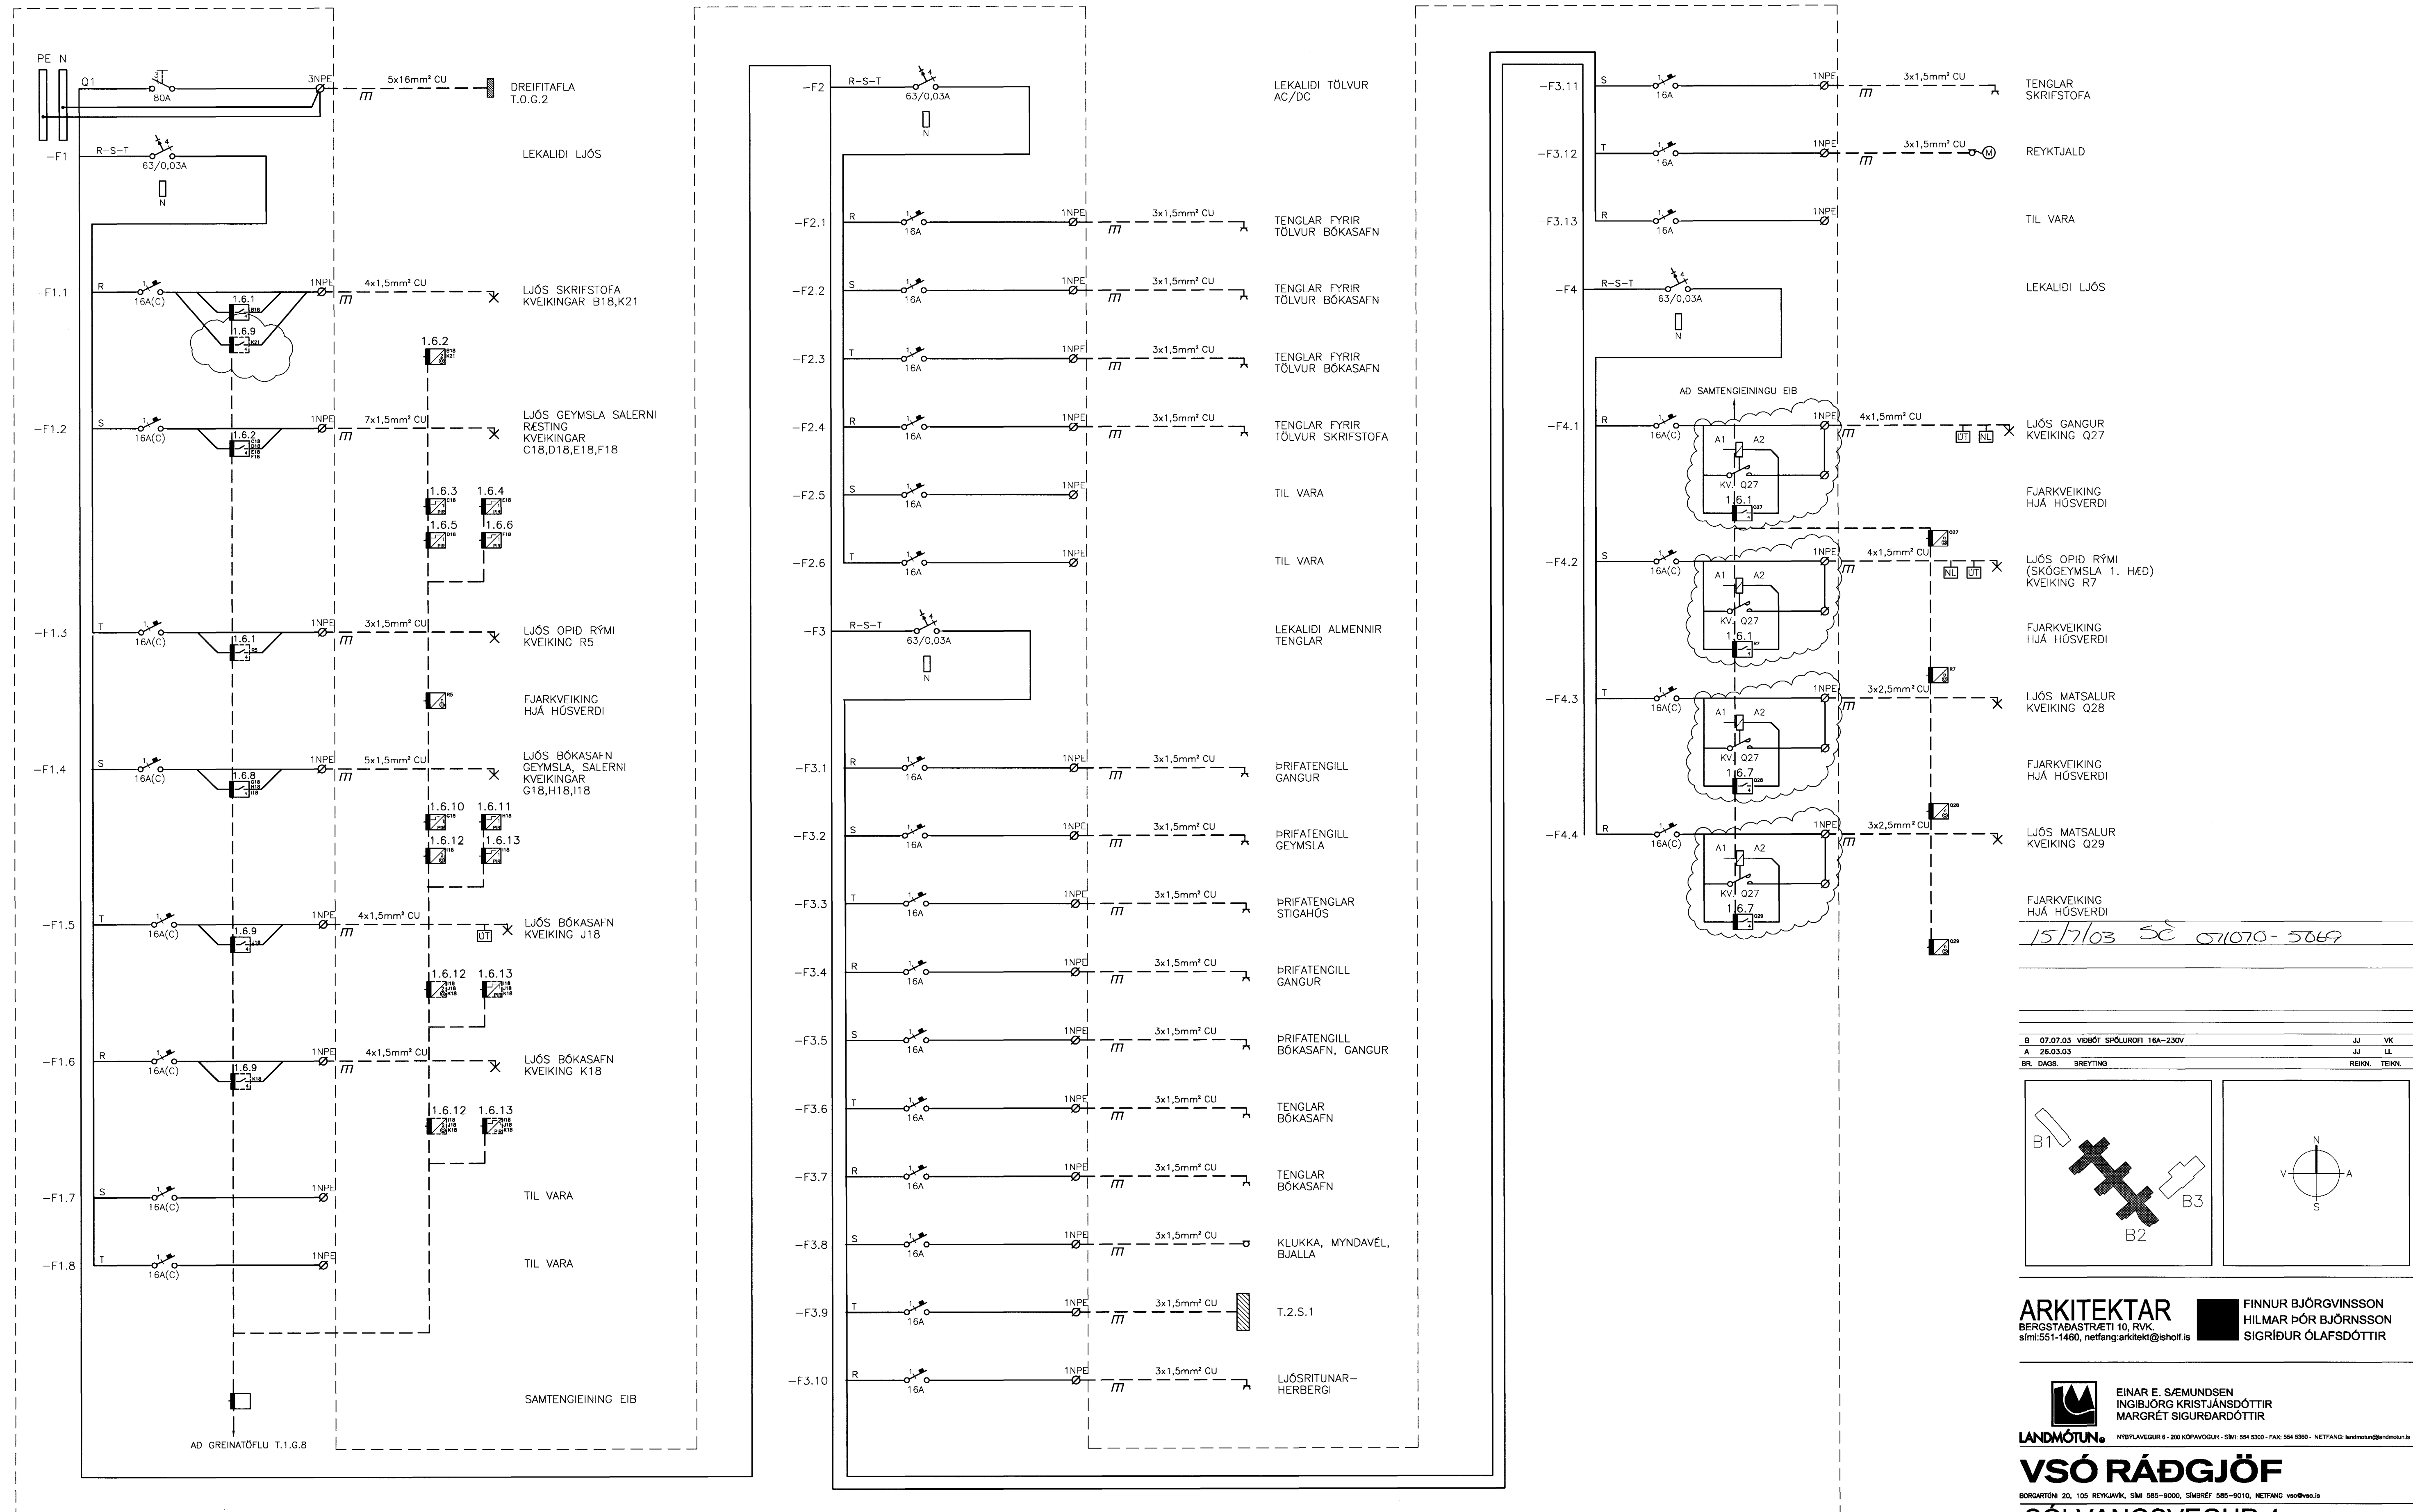

15/7/03 SE 071070-5669

| | | | | |
|-----|----------|---------------------------|--------|-------|
| B | 07.07.03 | VIÐBÓT SPÖLURORI 16A-230V | JJ | VK |
| A | 26.03.03 | | JJ | LL |
| BR. | DAGS. | BREYTING | REIKN. | TEKN. |

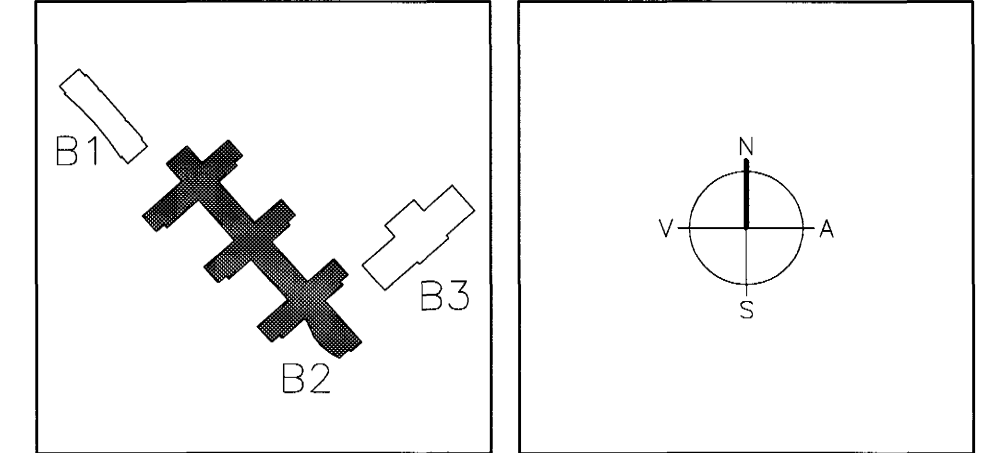

ARKITEKTAR
 BERGSTADASTRÆTI 10, RVK.
 sími: 551-1460, netfang: arkitekti@ishof.is

FINNUR BJÖRGVINSSON
HILMAR ÞÓR BJÖRNSSON
SIGRÍÐUR ÓLAFSDÓTTIR

LANDMÖTUN.
 EINAR E. SÆMUNDSEN
 INGIBJÖRG KRISTJÁNSDÓTTIR
 MARGRÉT SIGURDARDÓTTIR

VSÓ RÁÐGJÖF
 SÓLVANGSVEGUR 4
 LÆKJASKÓLI

| | |
|---|--|
| RAFORKLIRKI EINLÍNUNYND GREINATAFLA 2. HÆÐ T.2.G.8 | HANNAÐ/TEIKN ATH: <i>[Signature]</i> SAMPYKKT KT. 110856-7789 REYKJAVÍK 15.05.2002 |
| VERNRN. 00258 | TEIKN. NR. B2-R1-VE2-009 |