



GRUNNMYND 1.HÆÐ 1:50

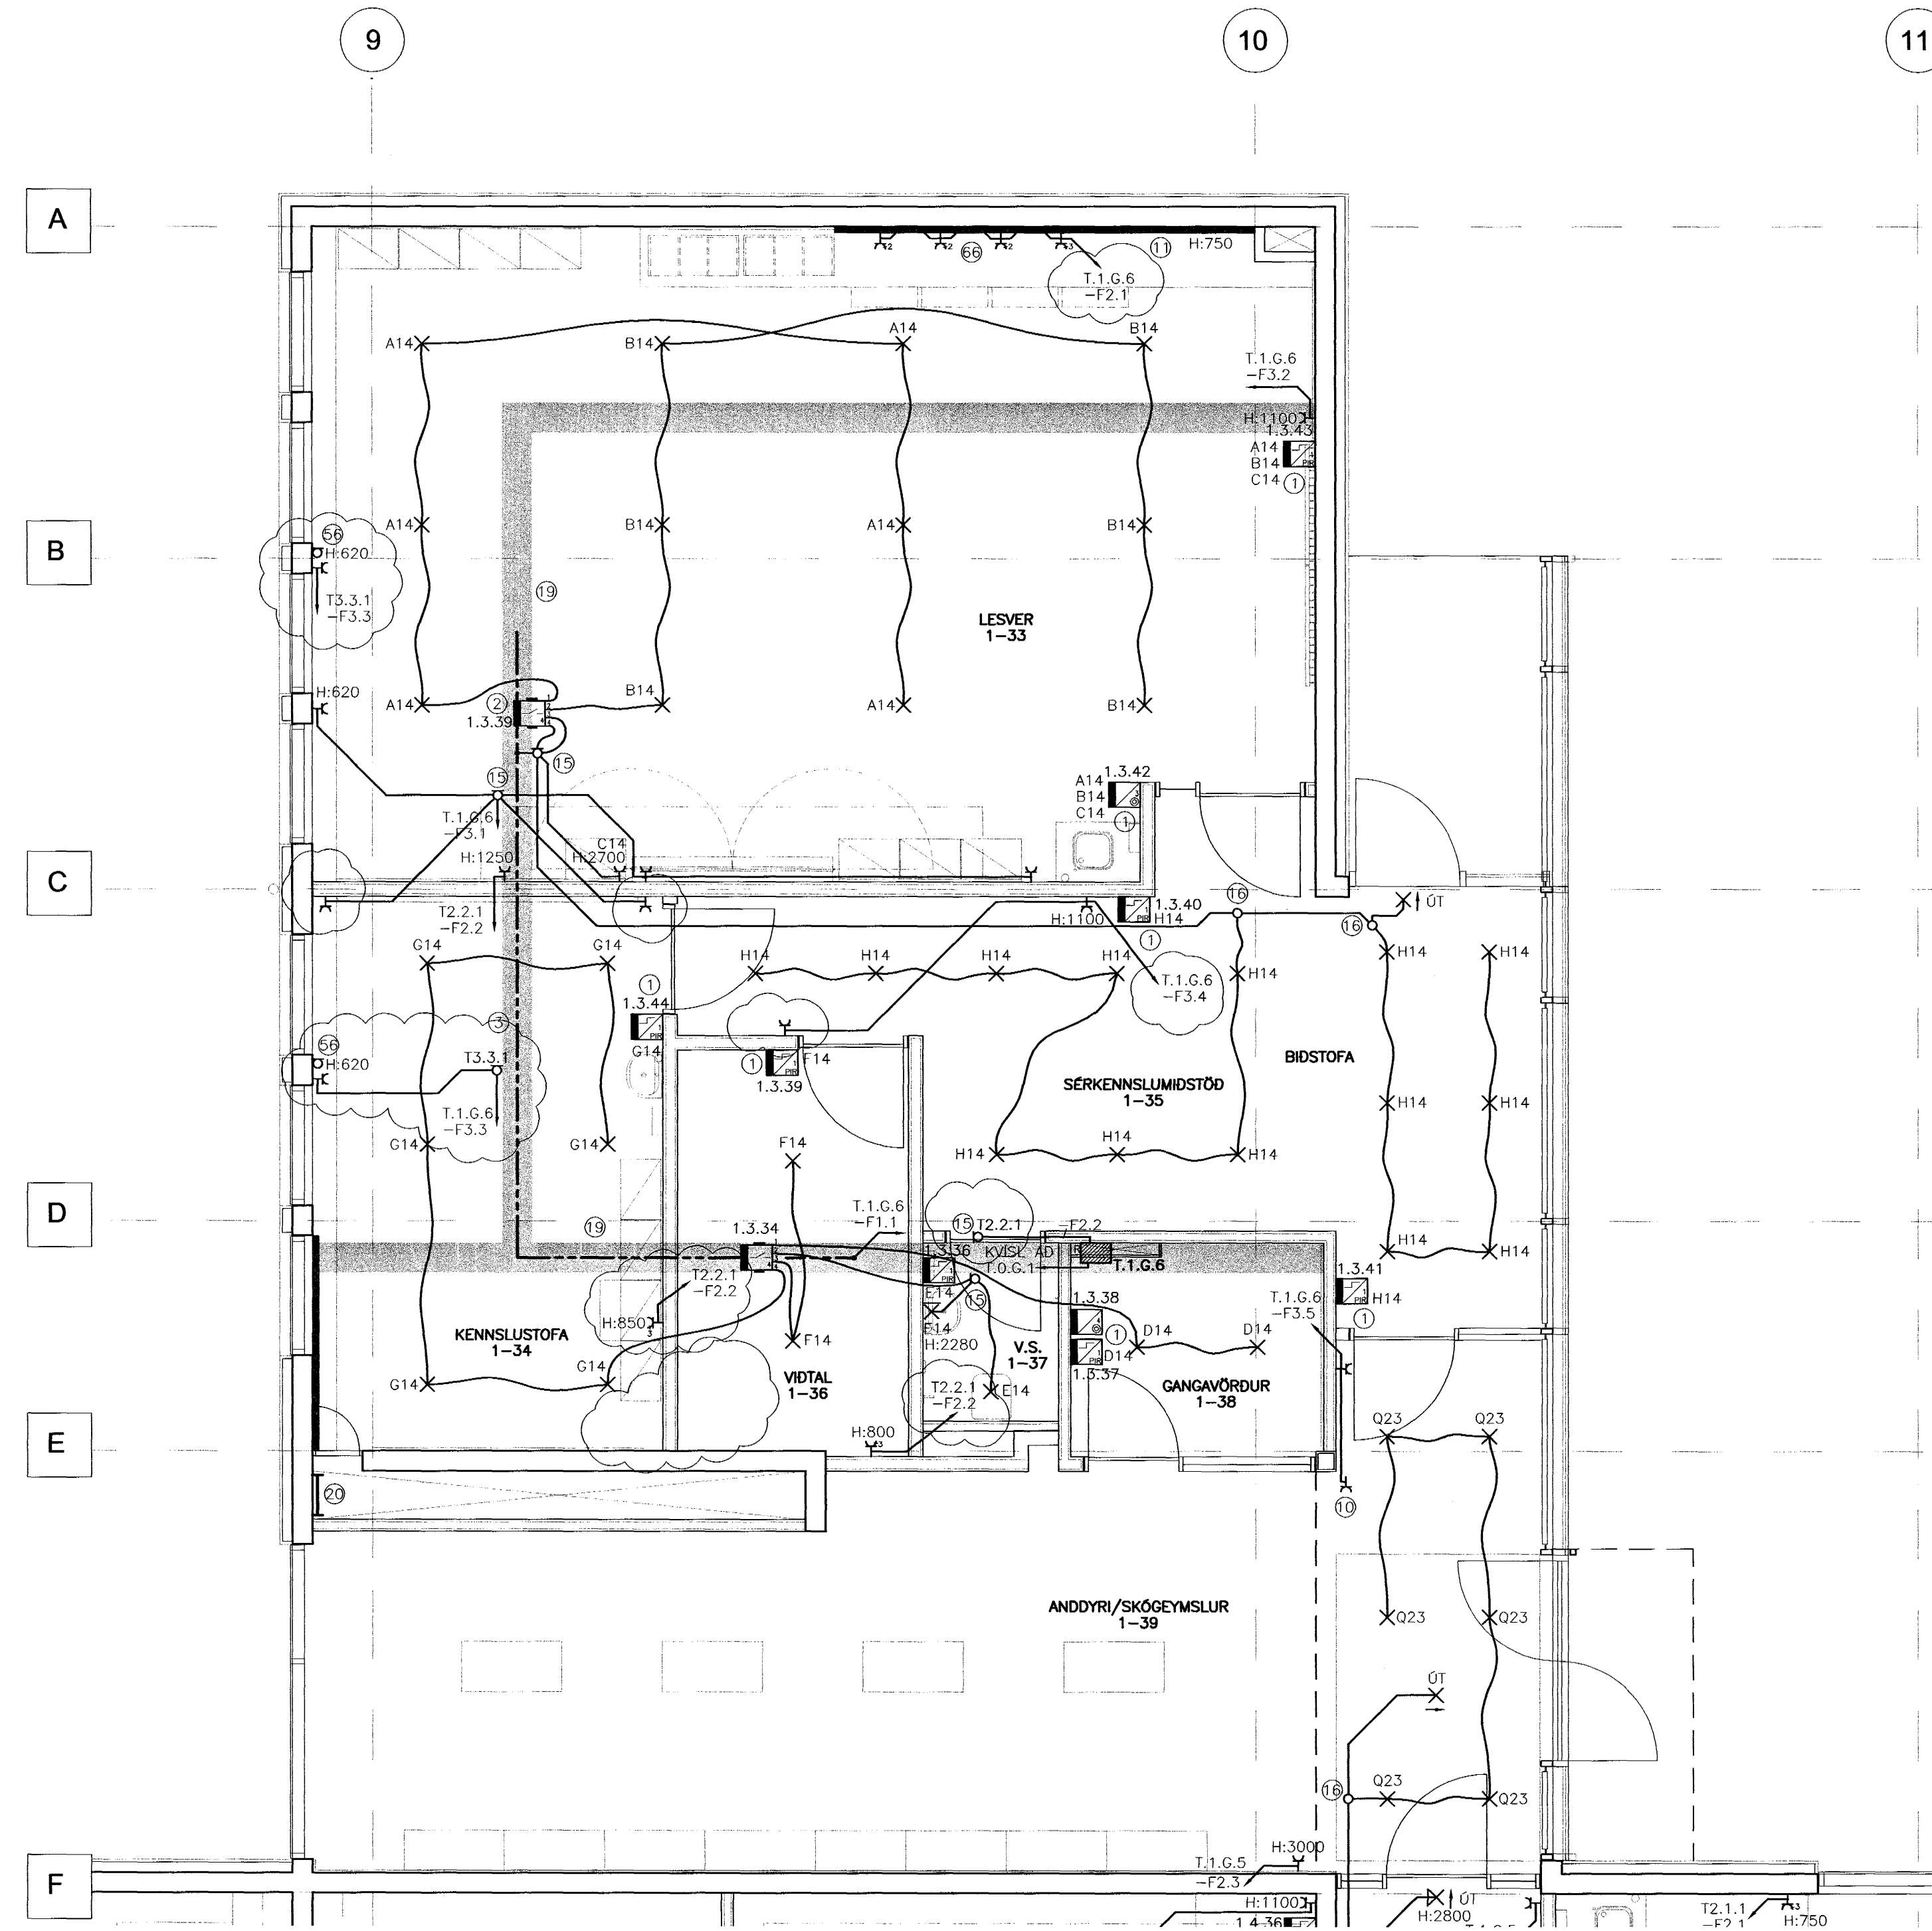

ATHUGASEMDIR OG SKÝRINGAR SJÁ TEIKNINGU B2-R0-VA-001

15/1/03 SC 071070-5069

B	16.07.03	TENGLAR FARDIR	JJ	VK
A	26.03.03	YMJAR BREYTINGAR	JJ	LL
BR	DAGS	BREYTING	REIKN	TEIKN

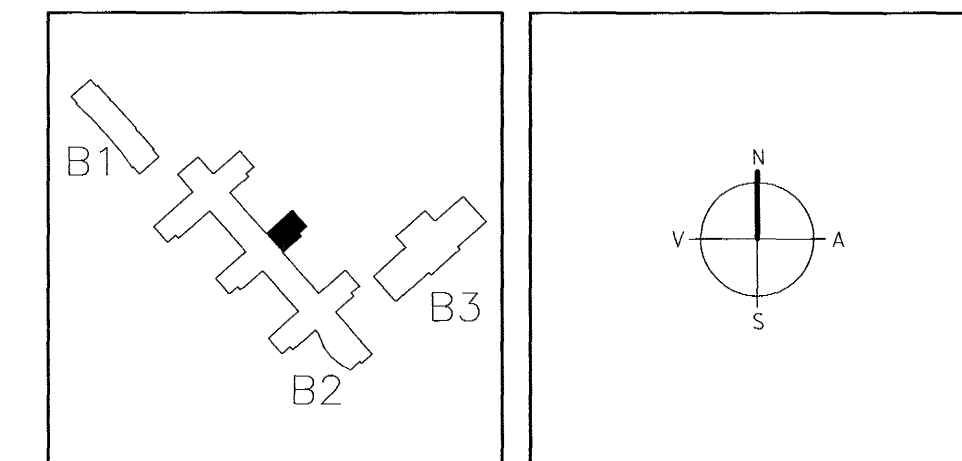

**ARKITEKTAR**  
BERGSTADASTRÆTI 10, RVK  
Sími: 551-1460, netfang: arkitekt@isholf.is

**FINNUR BJÖRGVINSSON**  
**HILMAR ÞÓR BJÖRNSSON**  
**SIGRÍÐUR ÓLAFSDÓTTIR**

**LANDMÖTUN.**  
HRYLLAVEIGUR 6-200 KÖPAVOGUR - Sími: 554 5300 - FAX: 554 5360 - NETFANG: landmotun@landmotun.is

**VSÓ RÁÐGJÖF**  
HORGHARTONI 20, 105 REYKJAVÍK, Sími: 585-9000, SímiREF: 585-9010, NETFANG: vsor@vsao.is

**SÓLVANGSVEGUR 4**  
**LÆKJARSKÓLI**

RAFORKUMIRKI	HANNAÐ/TEIKN.	JJ/LL
LÁGSFENNA	ATH: EK	
GRUNNMYND 1. HÆÐ	SMÁMYNKT	St
	KT.	110656-7769

KVARDI 1:50 REYKJAVÍK 15.05.2002

VERNRN. 00258 TEIKN. NR. B2-R1-VG1-005 BR. B