



GRUNNMYND 2.HÆÐ 1:50

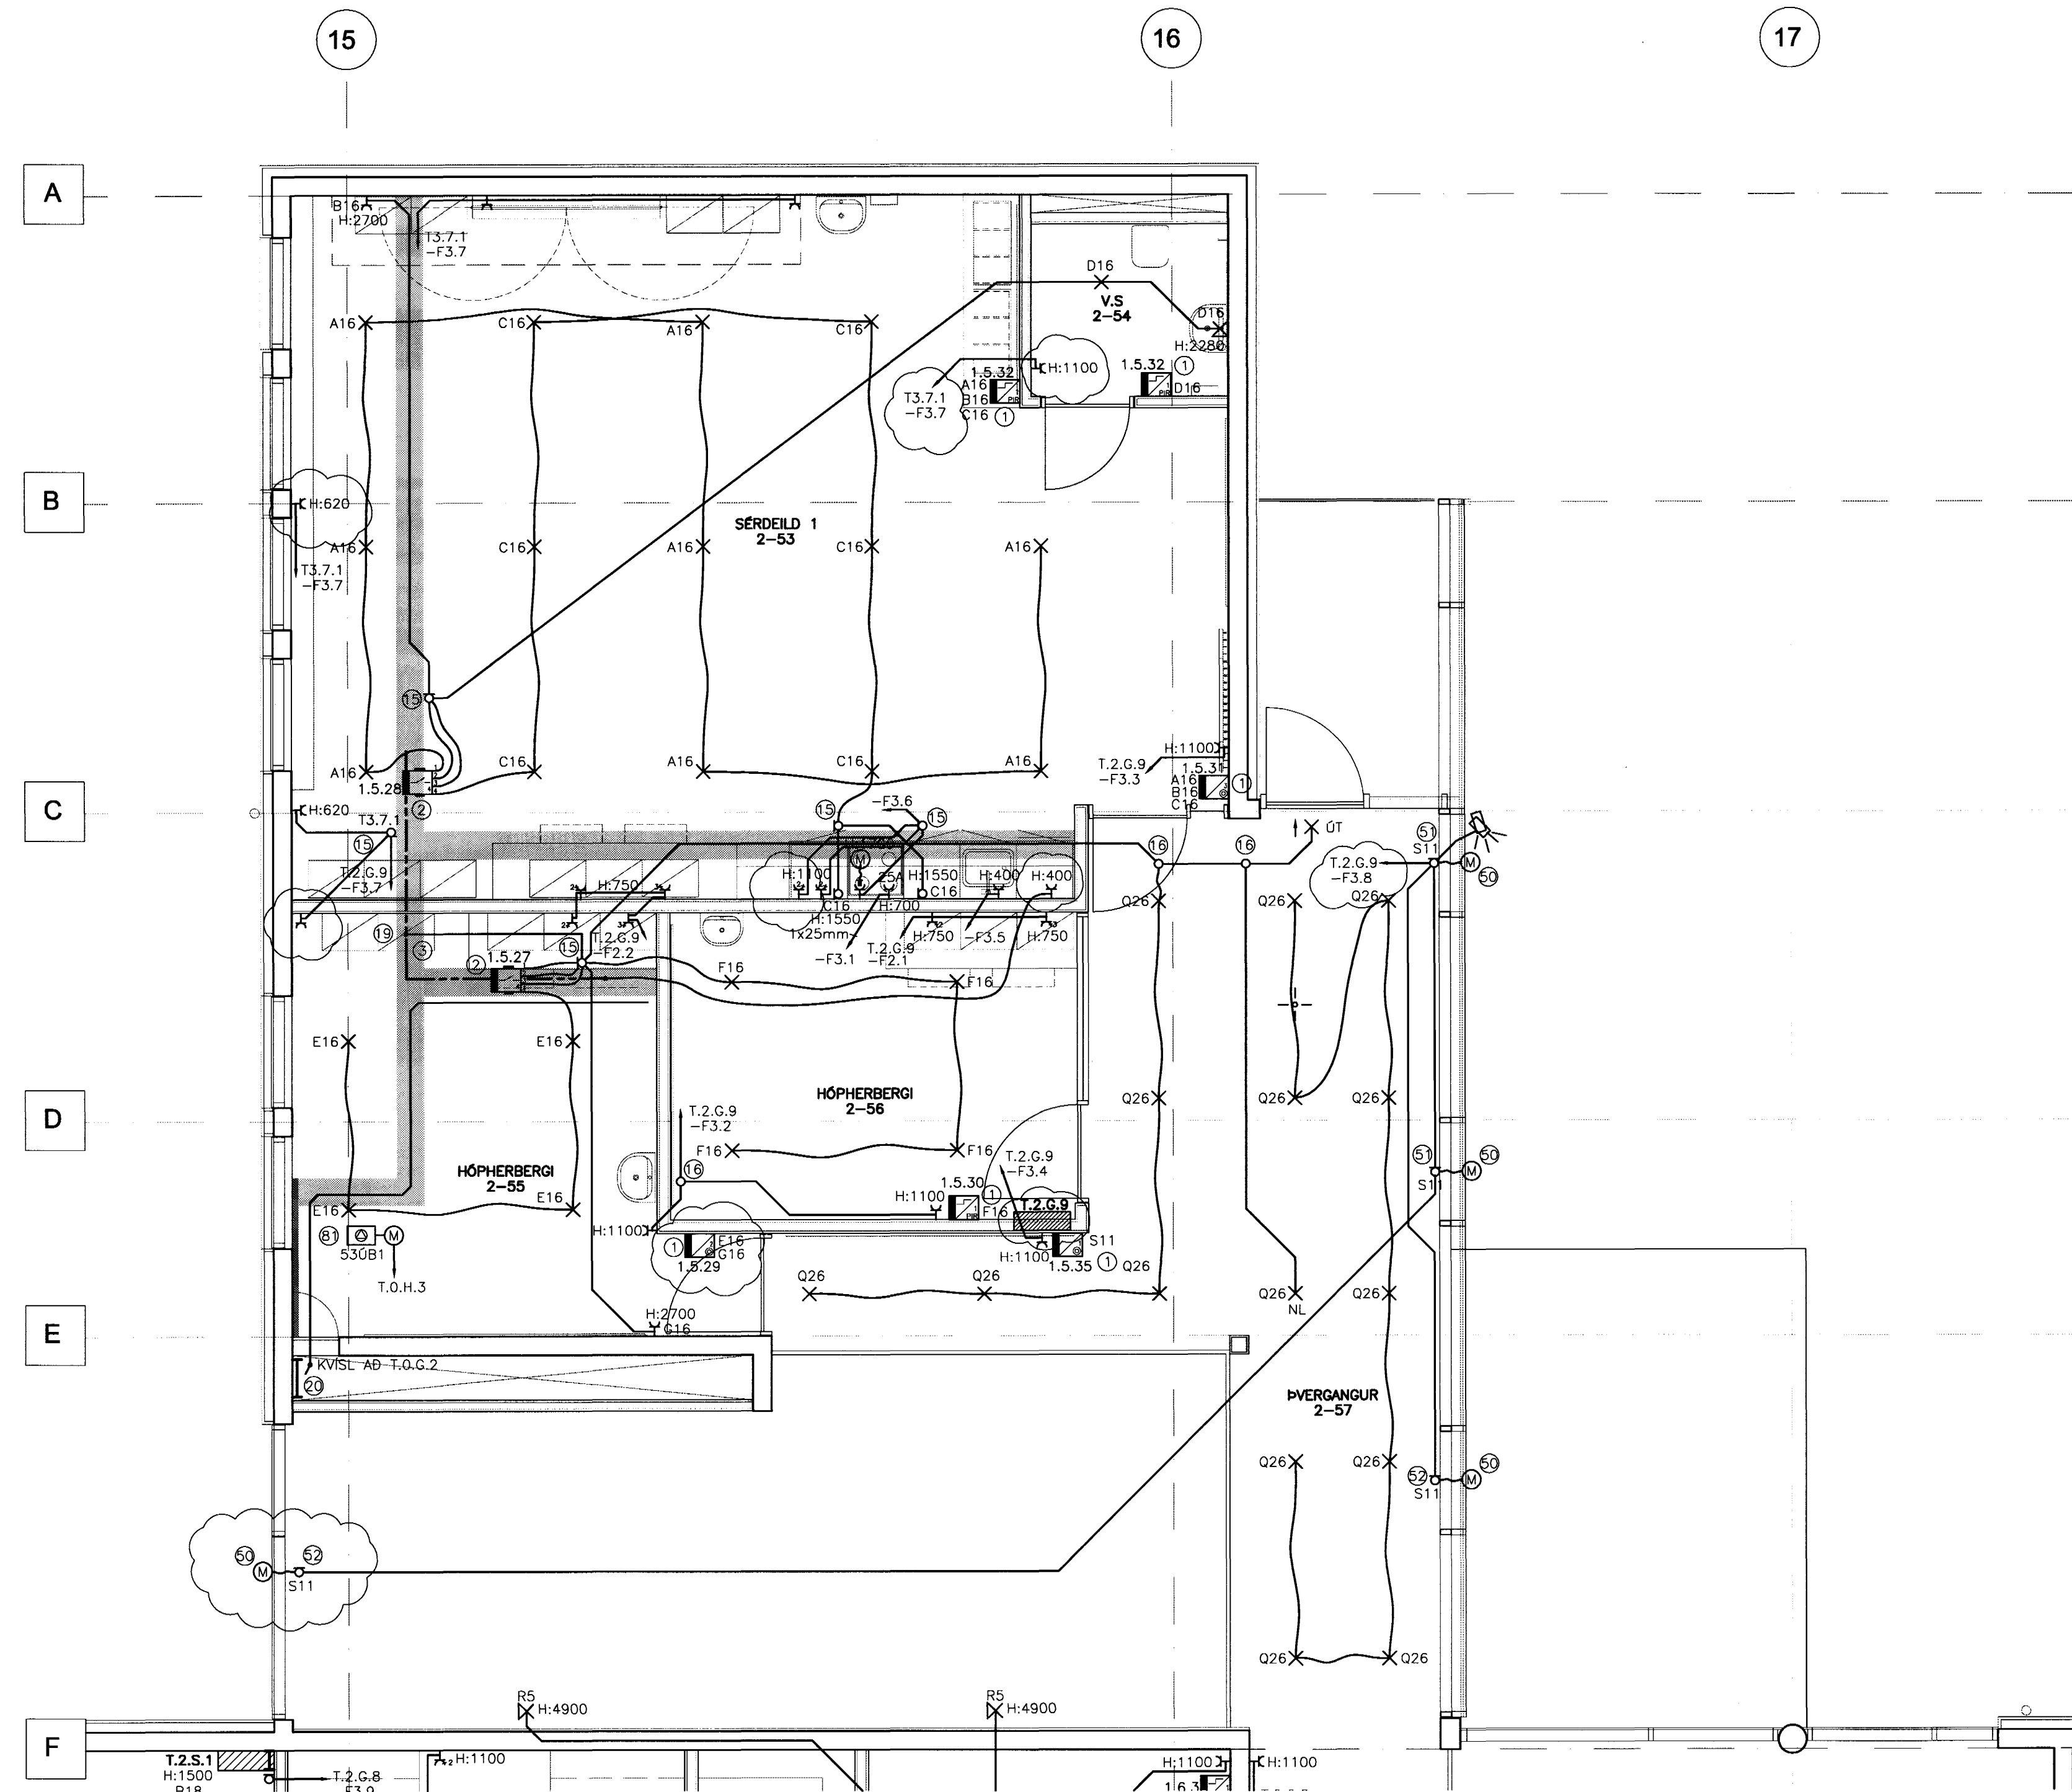

ATHUGASEMDIR OG SKÝRINGAR SJÁ TEIKNINGU B2-R0-VA-001

15/7/03 SC 071070-5069

BR.	DAGS.	BREYTING	REIKN.	TEIKN.
A	28.03.03	ÞMSAR BREYTINGAR	JJ	LL

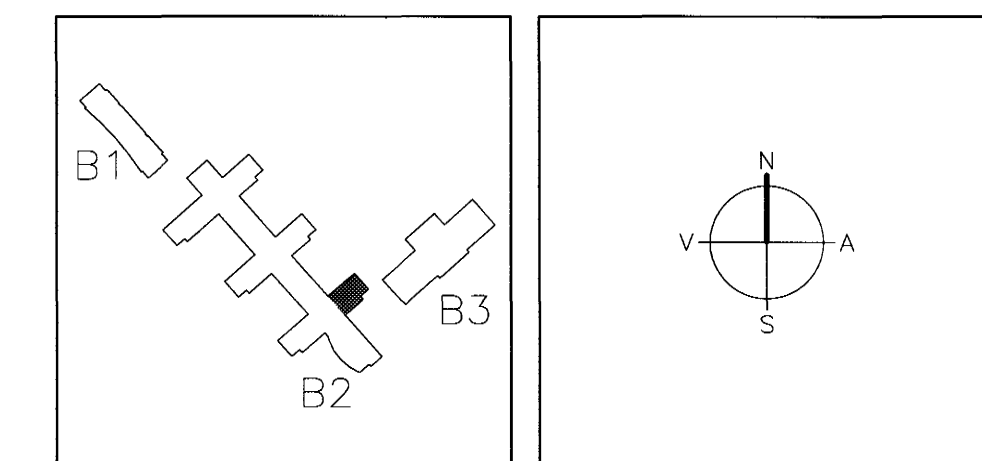

**ARKITEKTAR**  
 BERGSTADASTRÆTI 10, RVK.  
 sími: 551-1460, netfang: arkitekti@ishoff.is

**FINNUR BJÖRGVINSSON**  
**HILMAR ÞÓR BJÖRNSSON**  
**SIGRÍÐUR ÓLAFSDÓTTIR**

**LANDMÖTUN.**  
 NYBYLAVEGUR 6 - 200 KÓPAVOGUR - Sími: 504 5300 - FAX: 554 5380 - NETFANG: landmaur@landmaur.is

**EINAR E. SÆMUNDSEN**  
**INGIBJÖRG KRISTJÁNSDÓTTIR**  
**MARGRÉT SIGURDARDÓTTIR**

**VSÓ RÁÐGJÖF**  
 BORGATONN 20, 105 REYKJAVÍK, Sími: 585-9000, SMÍÐRÉT: 585-9010, NETFANG: vs@vs.is

**SÓLVANGSVEGUR 4**  
**LÆKJARSKÓLI**

RAFORKUMIRKI LÁGSPENNA GRUNNMYND 2. HÆÐ	HANNAÐ/TEIKN. ATH. SAMPYKKT	JJ/LL sk
KVARDI: 1:50	REYKJAVÍK	110856-7768

VERKNR. 00258	TEKN. NR. B2-R1-VG2-009	BR. A
------------------	----------------------------	----------