



GRUNNMYND 2.HÆÐ 1:50

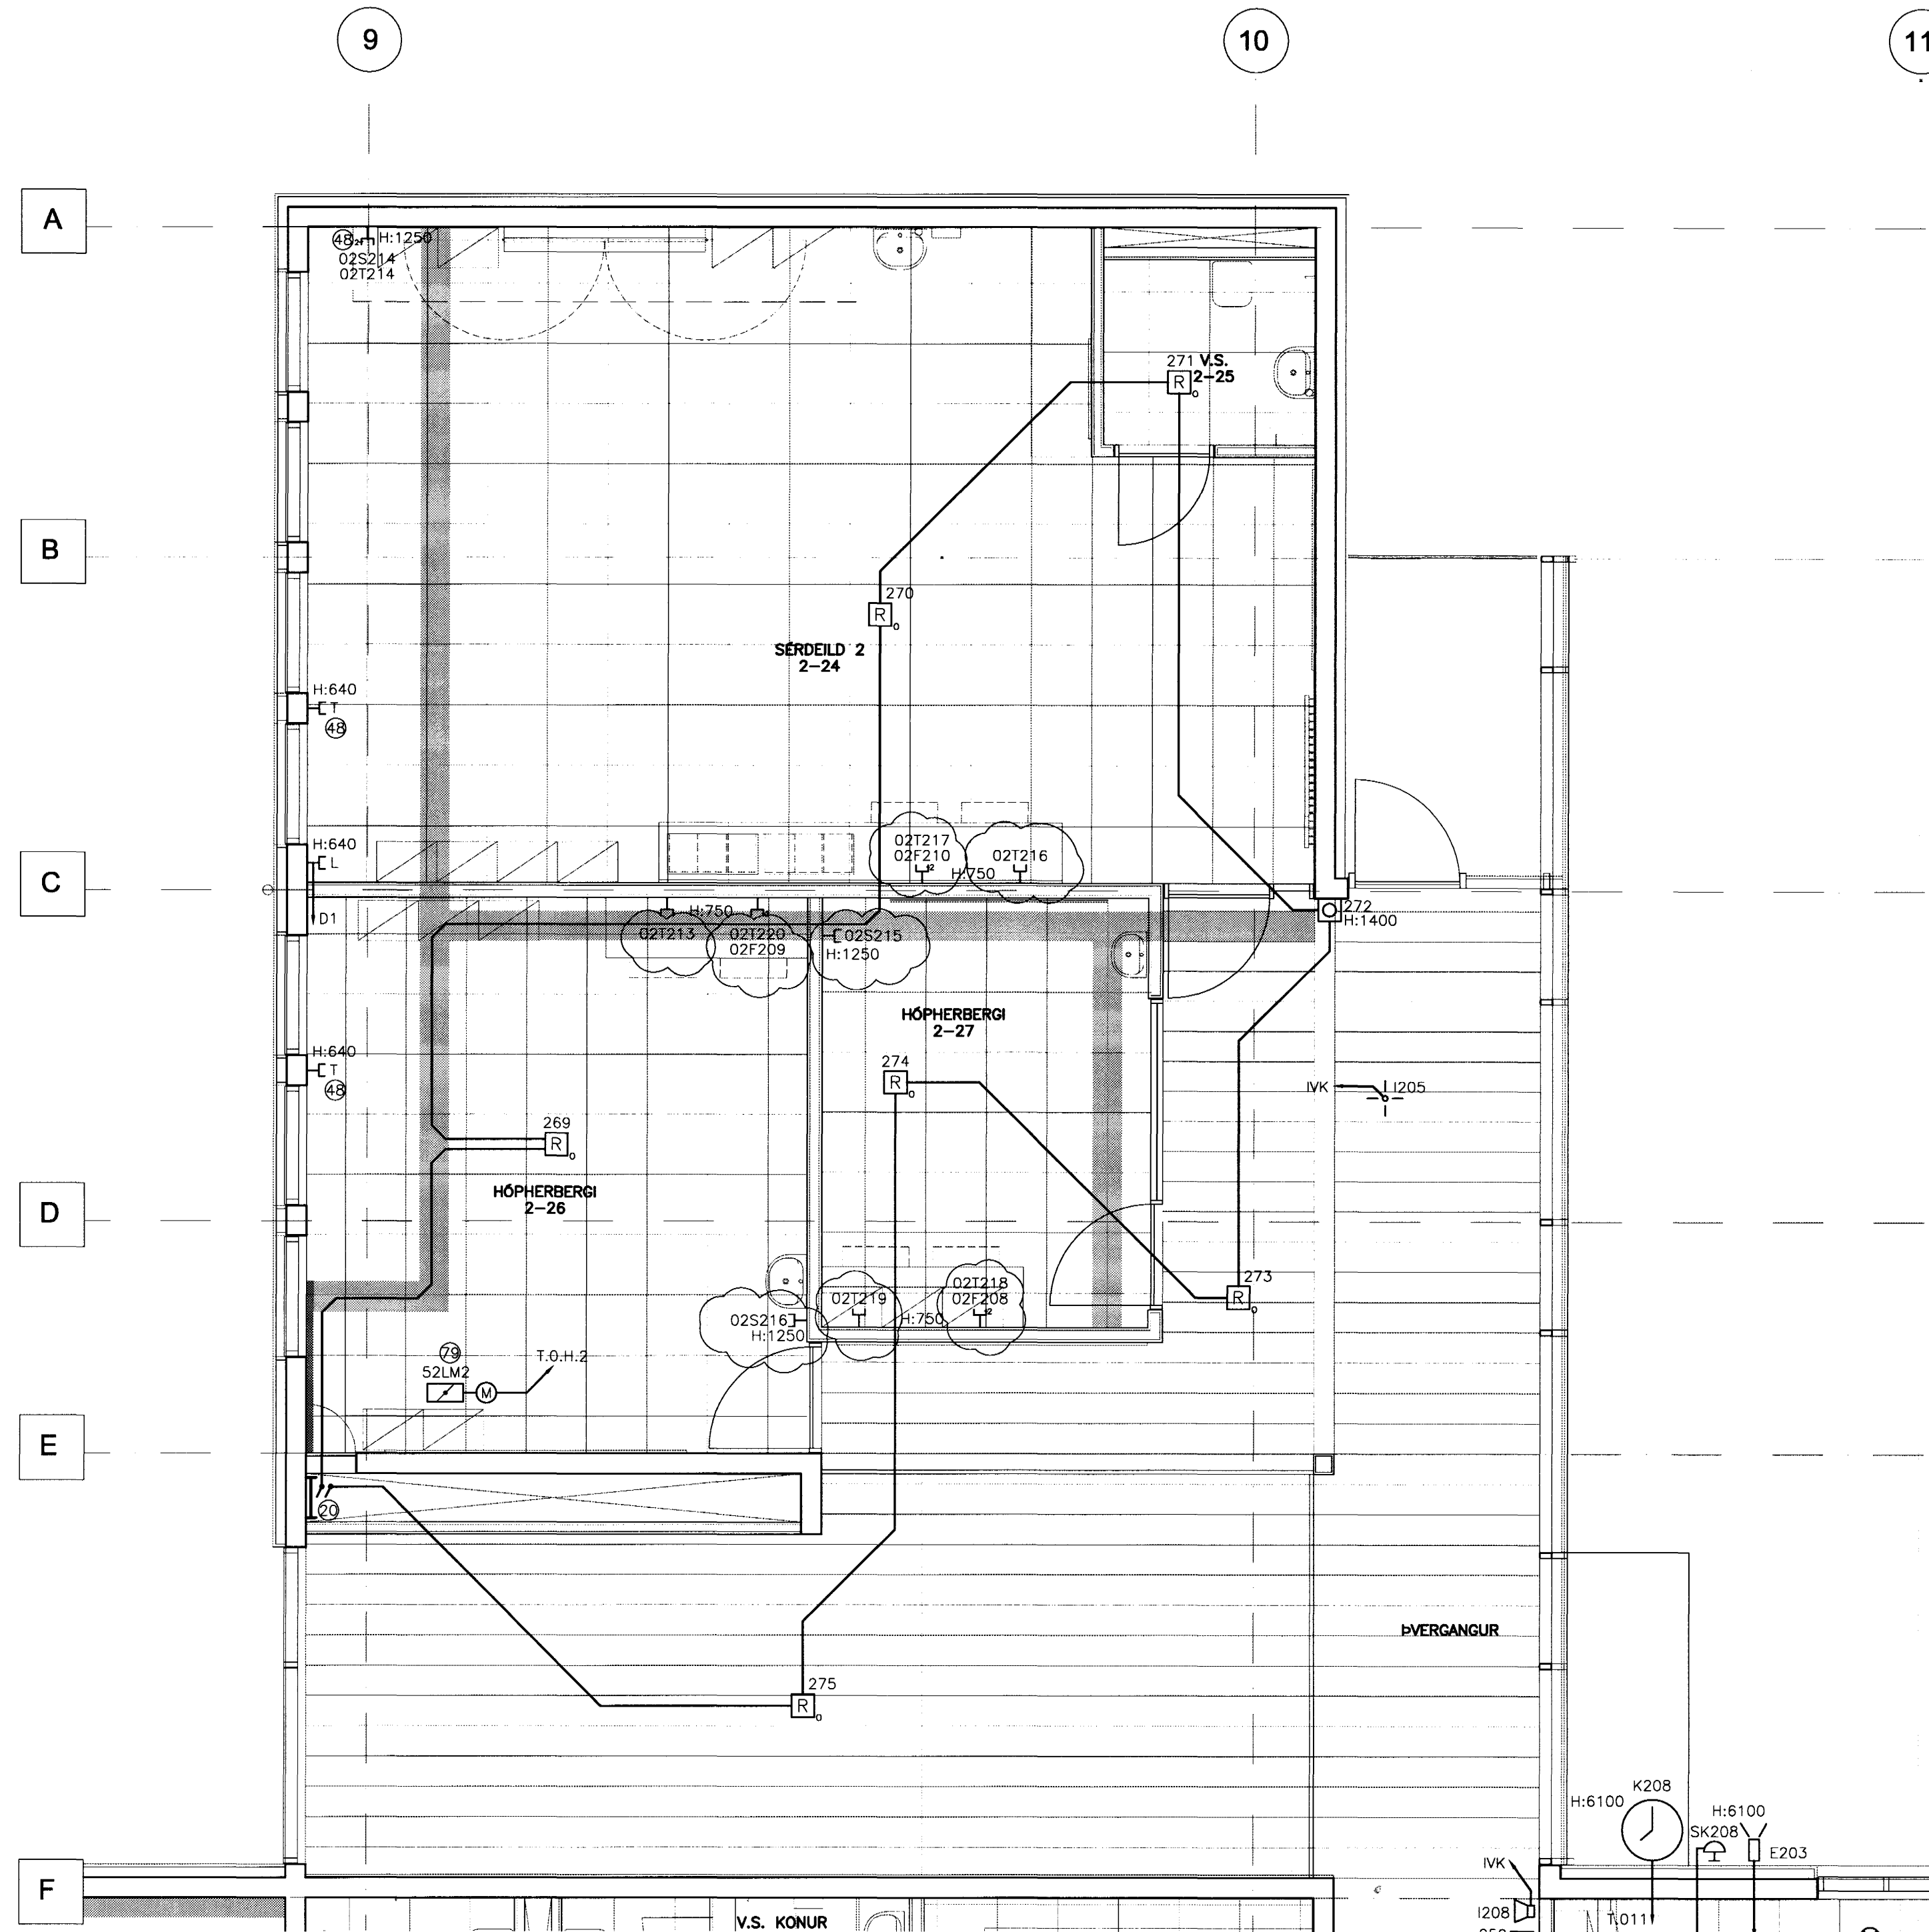

ATHUGASEMDIR OG SKÝRINGAR SJÁ TEIKNINGU B2-R0-VA-002

15/7/03 SC 071070-5069

B	07.07.03	NÖMUR TENGLA	JJ	LL
A	26.03.03	VÍSAR BREYTINGAR	JJ	LL
BR.	DAGS.	BREYTING	REKNI	TEIKN.

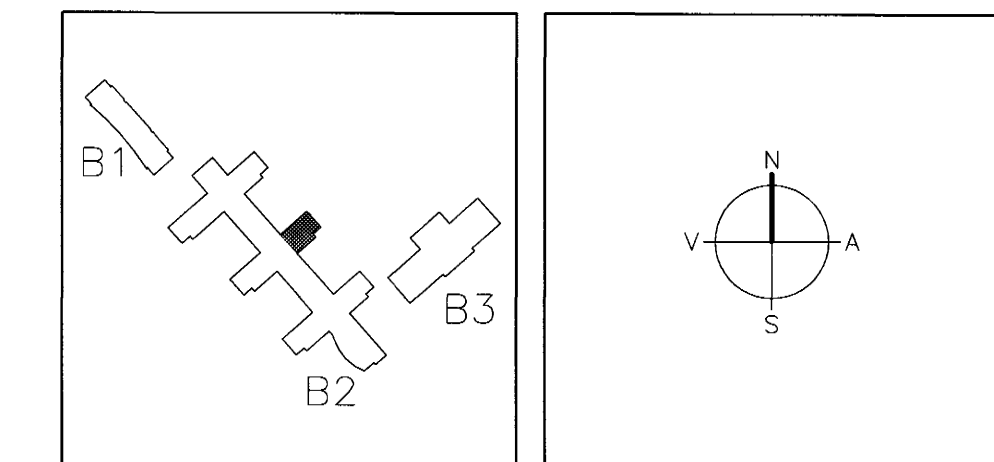

ARKITEKTAR
BERGSTADASTRÆTI 10, RVK.
Sími: 551-1460, netfang: arkitekt@ishof.is

FINNUR BJÖRGVINSSON
HILMAR ÞÓR BJÖRNSSON
SIGRÍÐUR ÓLAFSDÓTTIR

LANDMÖTUN. HANND/TEKN. JJ/LL
NYBYLAVEGUR 6 - 200 KÖPAVOGUR - Sími: 554 5300 - Fax: 554 5300 - Netfang: landmota@landmota.is

VSO RÁÐGJÖF
BORGARTONI 20, 105 REYKJAVÍK, Sími: 585-9000, Símiþref: 585-9010, Netfang: vso@vso.is

SÓLVANGSVEGUR 4
LÆKJARSKÓLI

RAFORKLUMIRKI SMÁSPENNA GRUNNMYND 2. HÆÐ	HANND/TEKN. JJ/LL ATH. <i>SK</i> SAMHYKKI <i>SK</i> KT. <i>SK</i>
--	--

KVARDI 1:50 VERKNR. 00258	TEIKN. NR. B2-R3-VG2-005	BR. B
------------------------------	--------------------------	-------