



GRUNNMYND 1:50

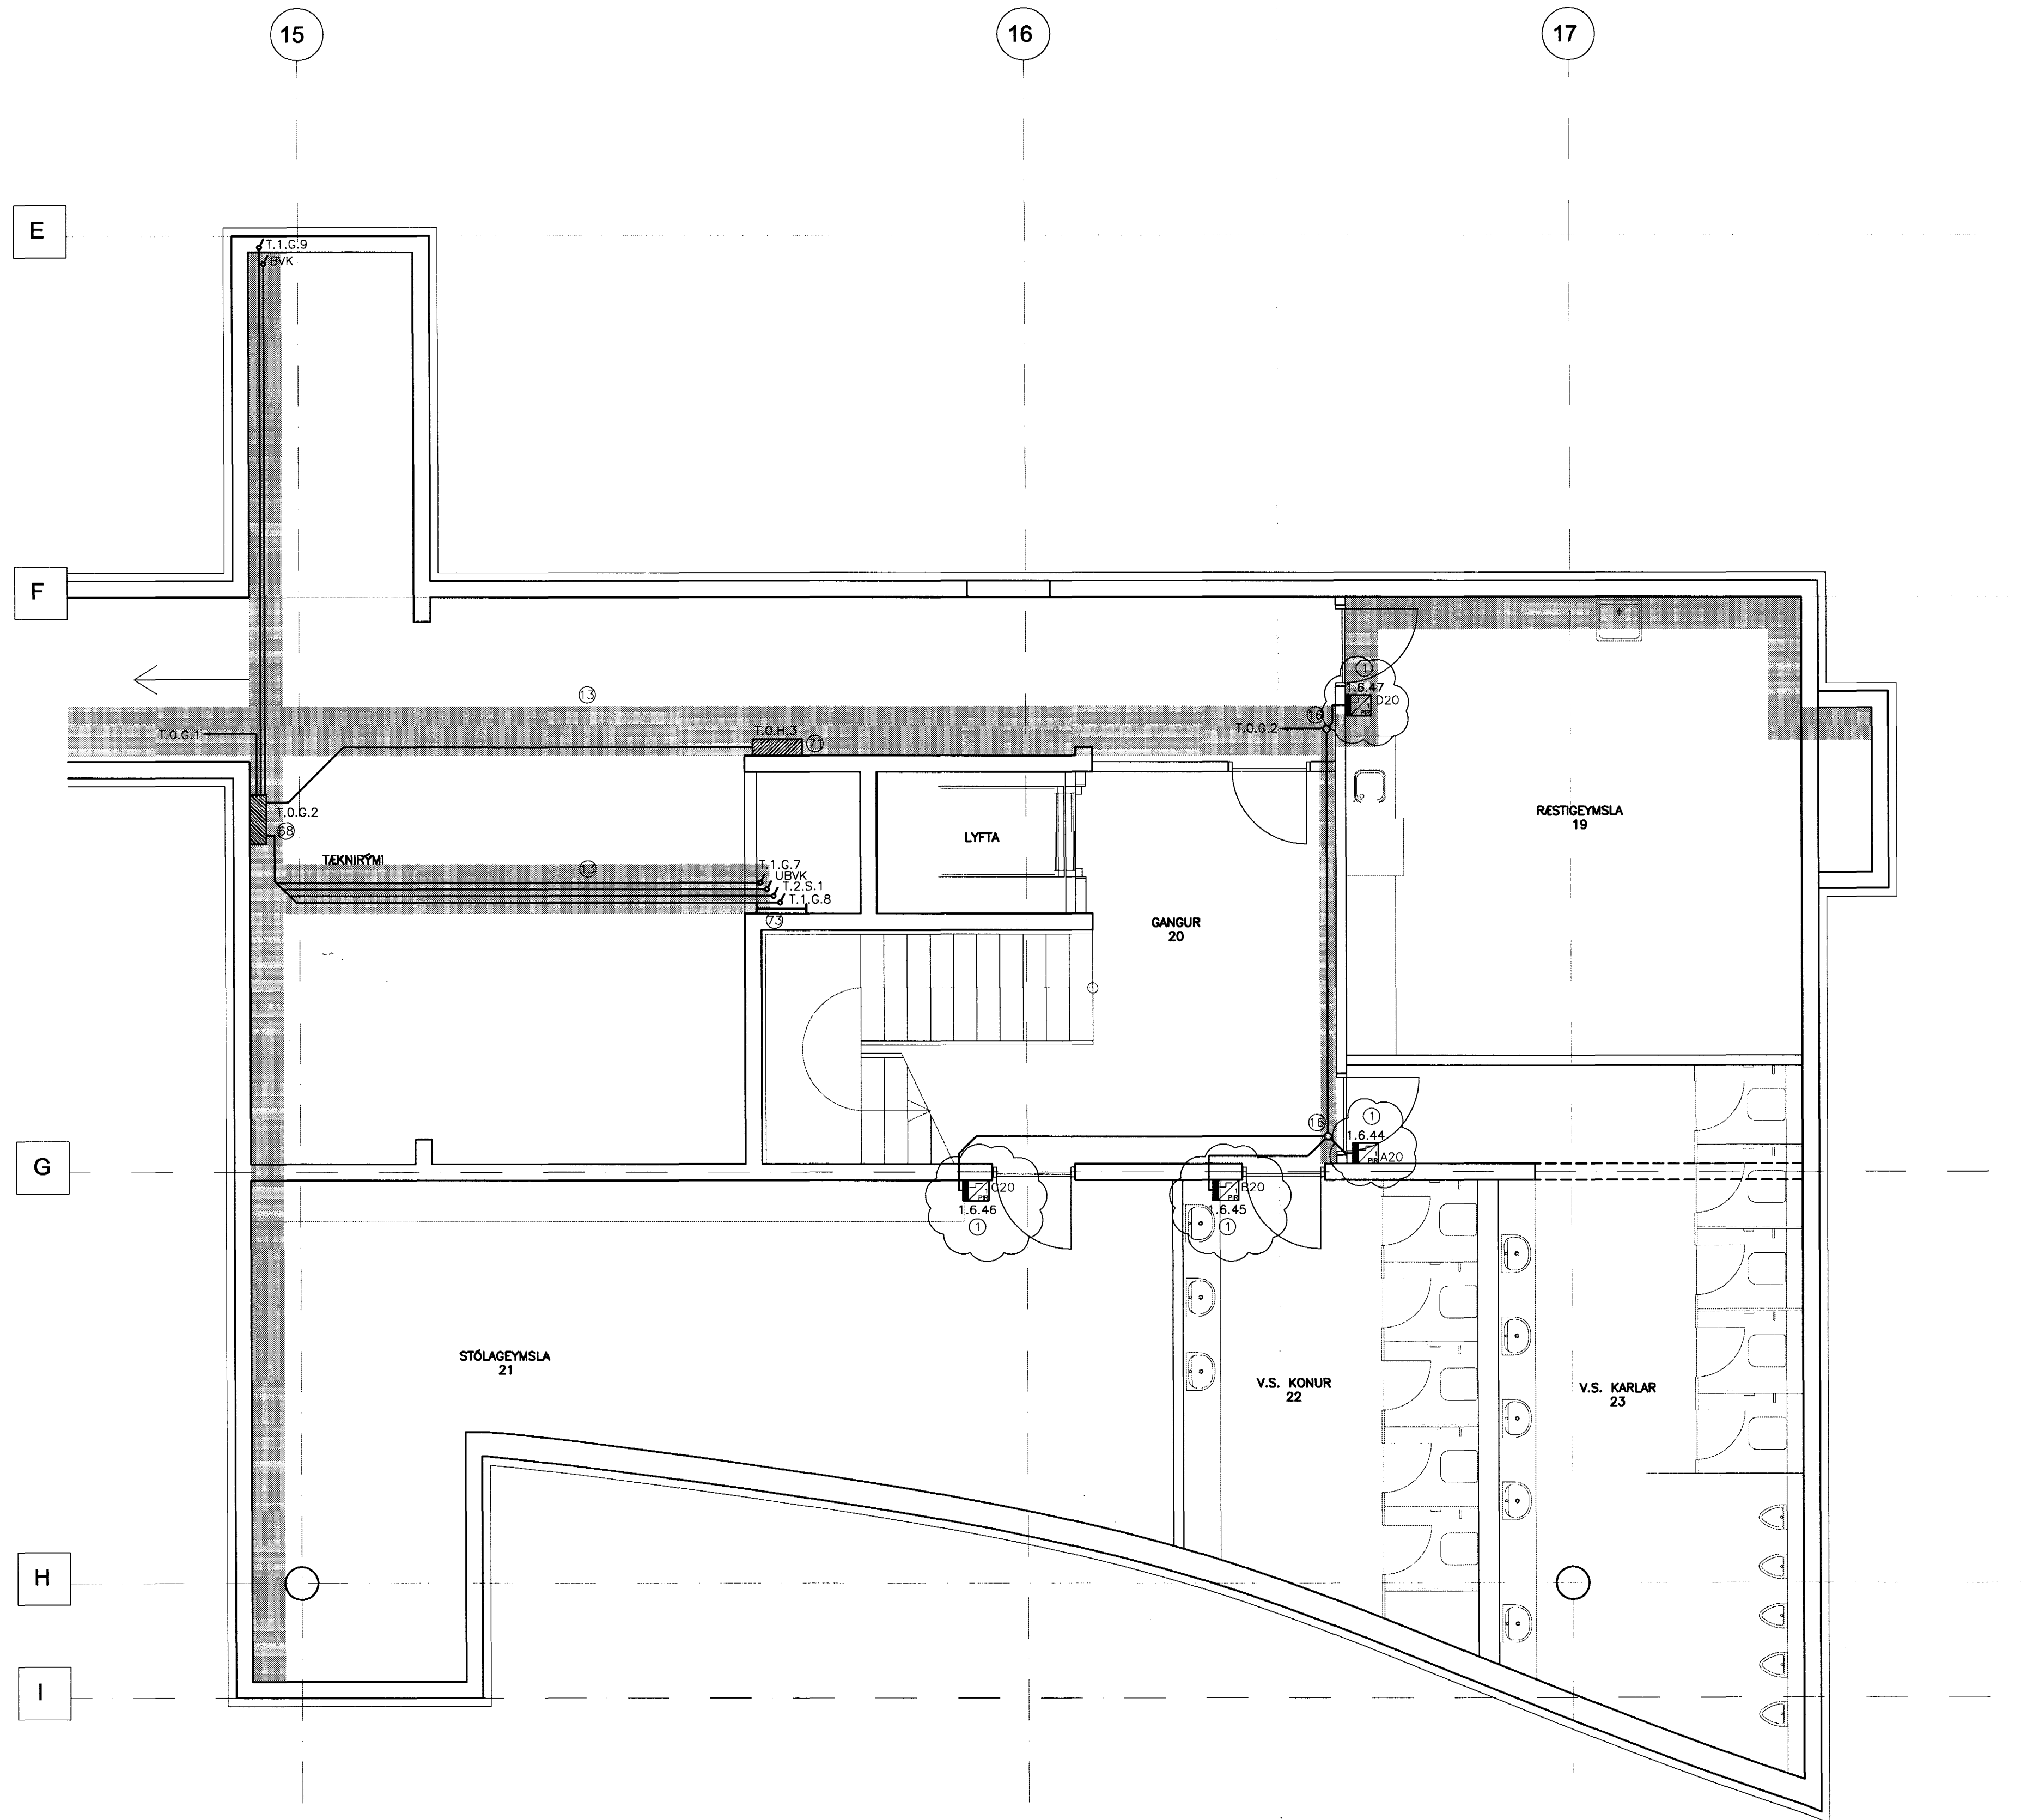

ATHUGASEMDIR OG SKÝRINGAR SJÁ TEIKNINGU B2-R0-VA-001

15/07/03 SC 071070-3689

A	07.07.03	JJ	LL
BR.	DAGS.	BREYTING	REIKN. TEIKN.

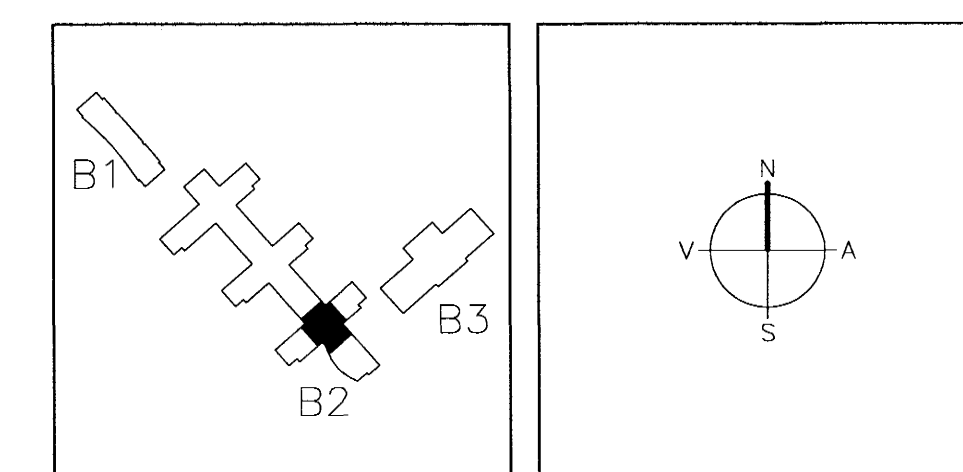

**ARKITEKTAR**  
BERGSTADASTRÆTI 10, RVK.  
sími: 551-1460, netfang:arkitekti@isholf.is

**FINNUR BJÖRGVINSSON**  
**HILMAR ÞÓR BJÖRNSSON**  
**SIGRÍÐUR ÓLAFSDÓTTIR**

**LANDMÖTUN**  
HAFSLAVEGUR 8 · 200 KOPAVOGUR · Sími: 554 5300 · FAX: 554 5380 · NETFANG: landmotun@landmotun.is

**VSÓ RÁÐGJÖF**  
BORGARTONI 20, 105 REYKJAVÍK, Sími 585-9000, Símbreyf 585-9010, NETFANG vs@vs.is

**SÓLVANGSVEGUR 4**  
**LÆKJARSKÓLI**

RAFORKLIRKI INSTABUSKERFI GRUNNMYND KJALLARA	HANNAÐ/TEIKN. ATH: <i>[Signature]</i> SAMÞYKKT KT. <i>[Signature]</i>	JJ/LL 110858-7789
--	--	----------------------

KVARDI 1:50	VERKNR.	TEIKN. NR.	REYKJAVÍK	15.05.2002	BR.
00258		B2-R4-VG0-006			A