



GRUNNMYND 1.HÆÐ 1:50

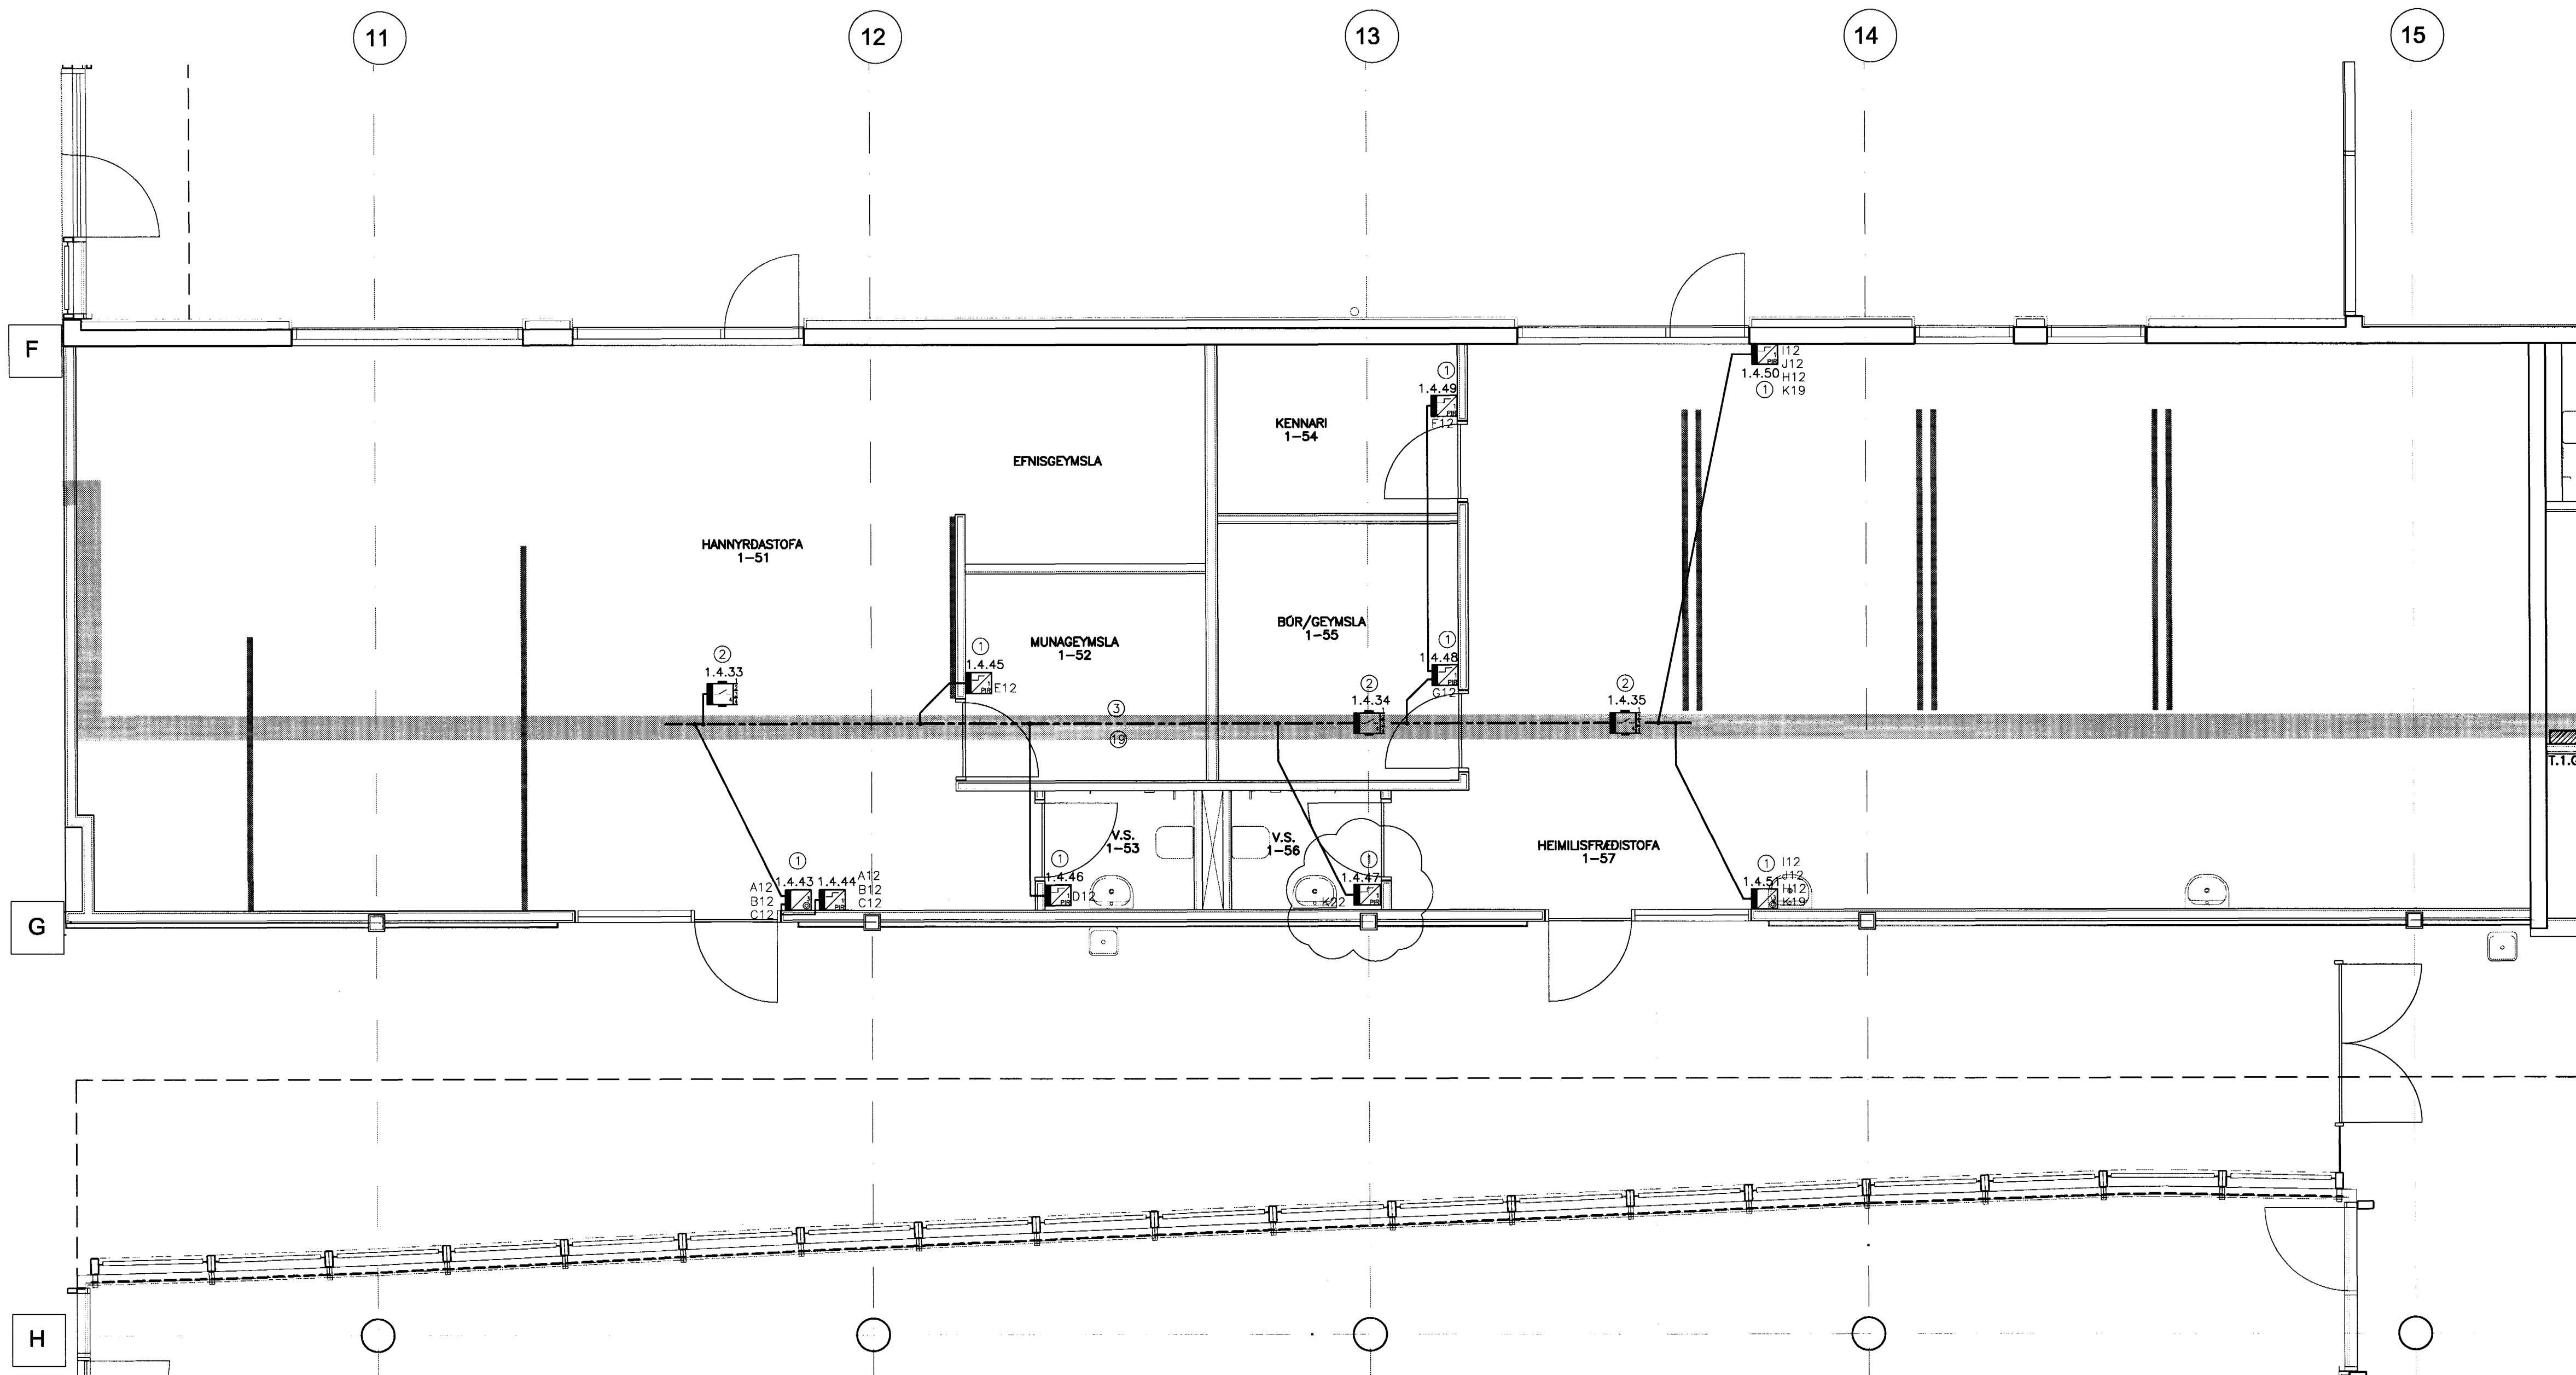

ATHUGASEMDIR OG SKÝRINGAR SJÁ TEIKNINGU B2-R0-VA-001

15/7/03 SC 01070-5069

B	07.07.03	KVEKING K22	JJ	LL
A	26.03.03	YMJAR BREYTINGAR	JJ	LL
BR.	DAGS.	BREYTING	REIKN.	TEIKN.

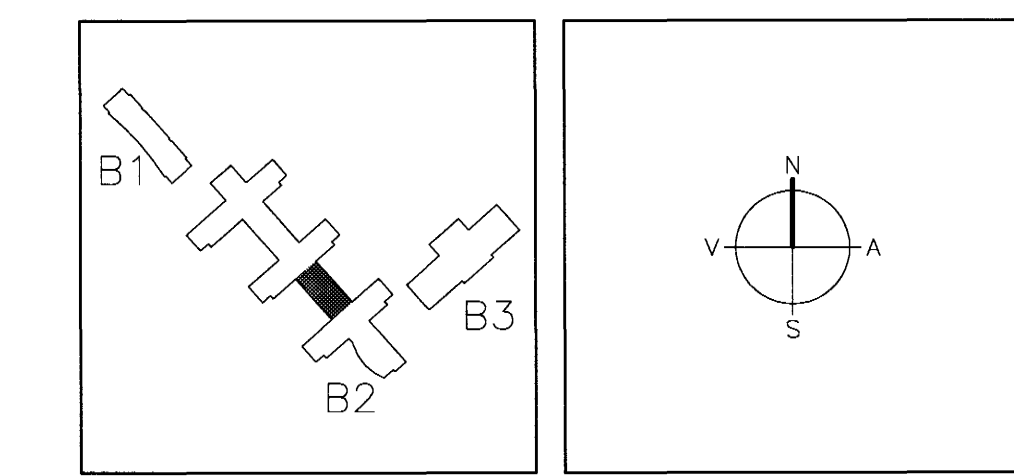

ARKITEKTAR
 BERGSTADASTRÆTI 10, RVK
 sími:551-1460, netfang:arkitekt@ishoff.is

FINNUR BJÖRGVINSSON
HILMAR ÞÓR BJÖRNSSON
SIGRÍÐUR ÓLAFSDÓTTIR

LANDMÖTLUN
 HAFSSTR. 10, 105 REYKJAVÍK, SÍMI 565-9000, SÍMBRUF 565-9010, NETFANG: landmotun@landmotun.is

VSÓ RÁDGJÖF
 BORGARTÚNI 20, 105 REYKJAVÍK, SÍMI 565-9000, SÍMBRUF 565-9010, NETFANG: vsoradgjof.is

SÓLVANGSVEGUR 4
LÆKJARSKÓLI

RAFORKUVIRKI	HANNA/TEIKN.	JJ/LL
INSTABUSKERFI	ATH. <i>SC</i>	
GRUNNMYND 1. HÆÐ	SAMBÝKOT <i>SC</i>	
	KT.	110856-7789
KVARDI 1:50	REYKJAVÍK	15.05.2002
VERKNR.	TEIKN. NR.	BR.
00258	B2-R4-VG1-008	B