



GRUNNMYND 1.HÆÐ 1:50

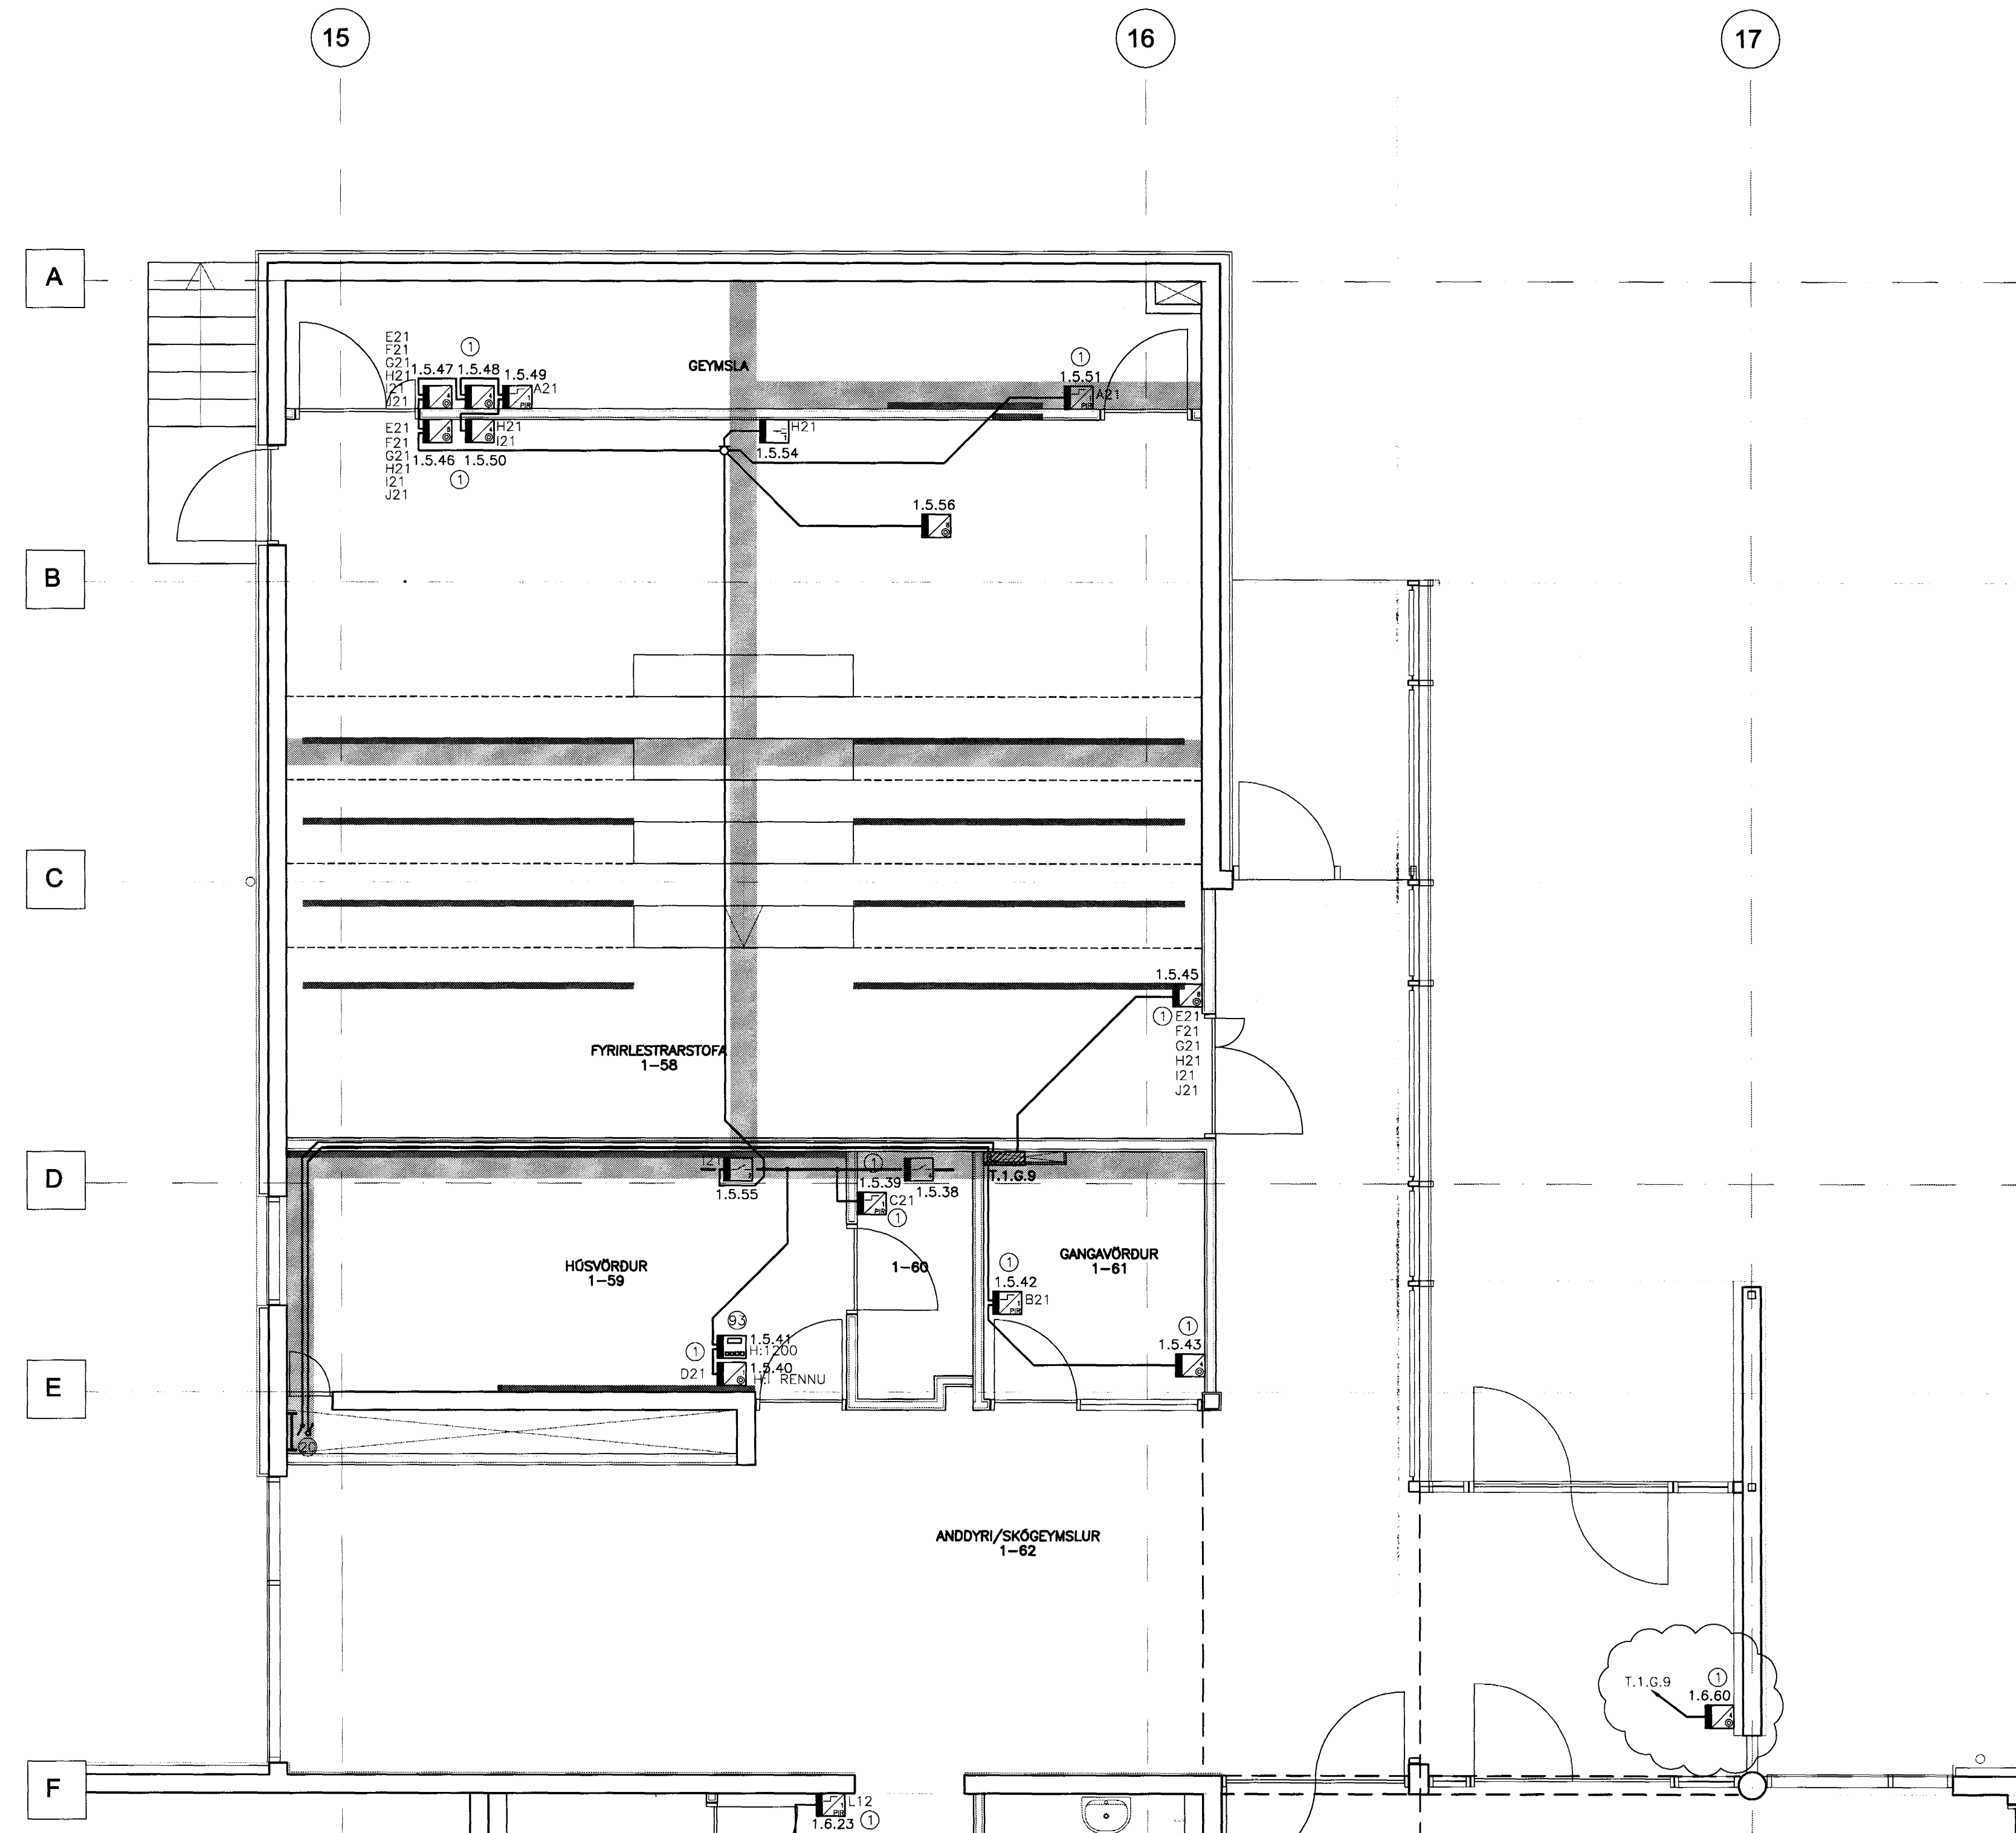

ATHUGASEMDIR OG SKÝRINGAR SJÁ TEIKNINGU B2-R0-VA-001

15/7/03 JC 071070-5067

C	07.07.03	HEM EIB-EININGAR	JJ	LL
B	26.03.03	YMISAR BREYTINGAR	JJ	LL
A	07.11.02	FYRIRLESTARSAÐUR FULLVANNADUR	JJ	LL
BR.	DAGS.	BREYTING	REIKN.	TEIKN.

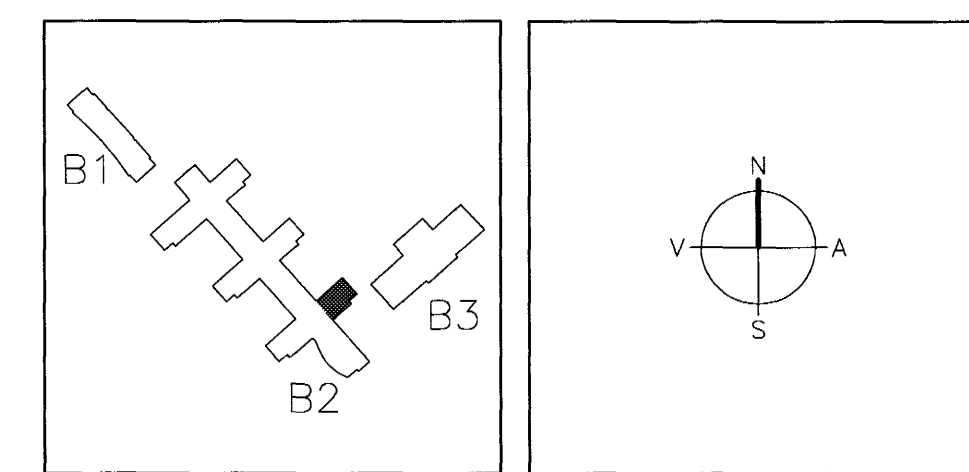

ARKITEKTAR
BERGSTADASTRÆTI 10, RVK.
sími:551-1460, netfang:arkitekt@isholf.is

FINNUR BJÖRGVINSSON
HILMAR ÞÓR BJÖRNSSON
SIGRÍÐUR ÓLAFSDÓTTIR

LANDMÖTUN.
EINAR E. SÆMUNDSEN
INGIBJÖRG KRISTJÁNSDÓTTIR
MARGRÉT SIGURDÁRDÓTTIR

NYBYLAVEIGUR 6 - 200 KÓPAVOGUR - Sími: 554 5300 - FAX: 554 5360 - NETFANG: landmotun@landmotun.is

VSÓ RÁÐGJÖF
BORGARTÓNI 20, 105 REYKJAVÍK, Sími: 595-9000, Símbref: 595-9010, NETFANG: vs@vsao.is

SÓLVANGSVEGUR 4
LÆKJARSKÓLI

RAFORKLIRKIRI INSTABUSKERFI GRUNNMYND 1. HÆÐ	HANNAÐ/TEIKN. ATH: <i>[Signature]</i> SAMÞYKKT KT. <i>[Signature]</i> 110956-7769	JJ/LL
KVARDI 1:50	REYKJAVÍK	15.05.2002
VERKNR.	TEIKN. NR.	BR.
00258	B2-R4-VG1-009	C