
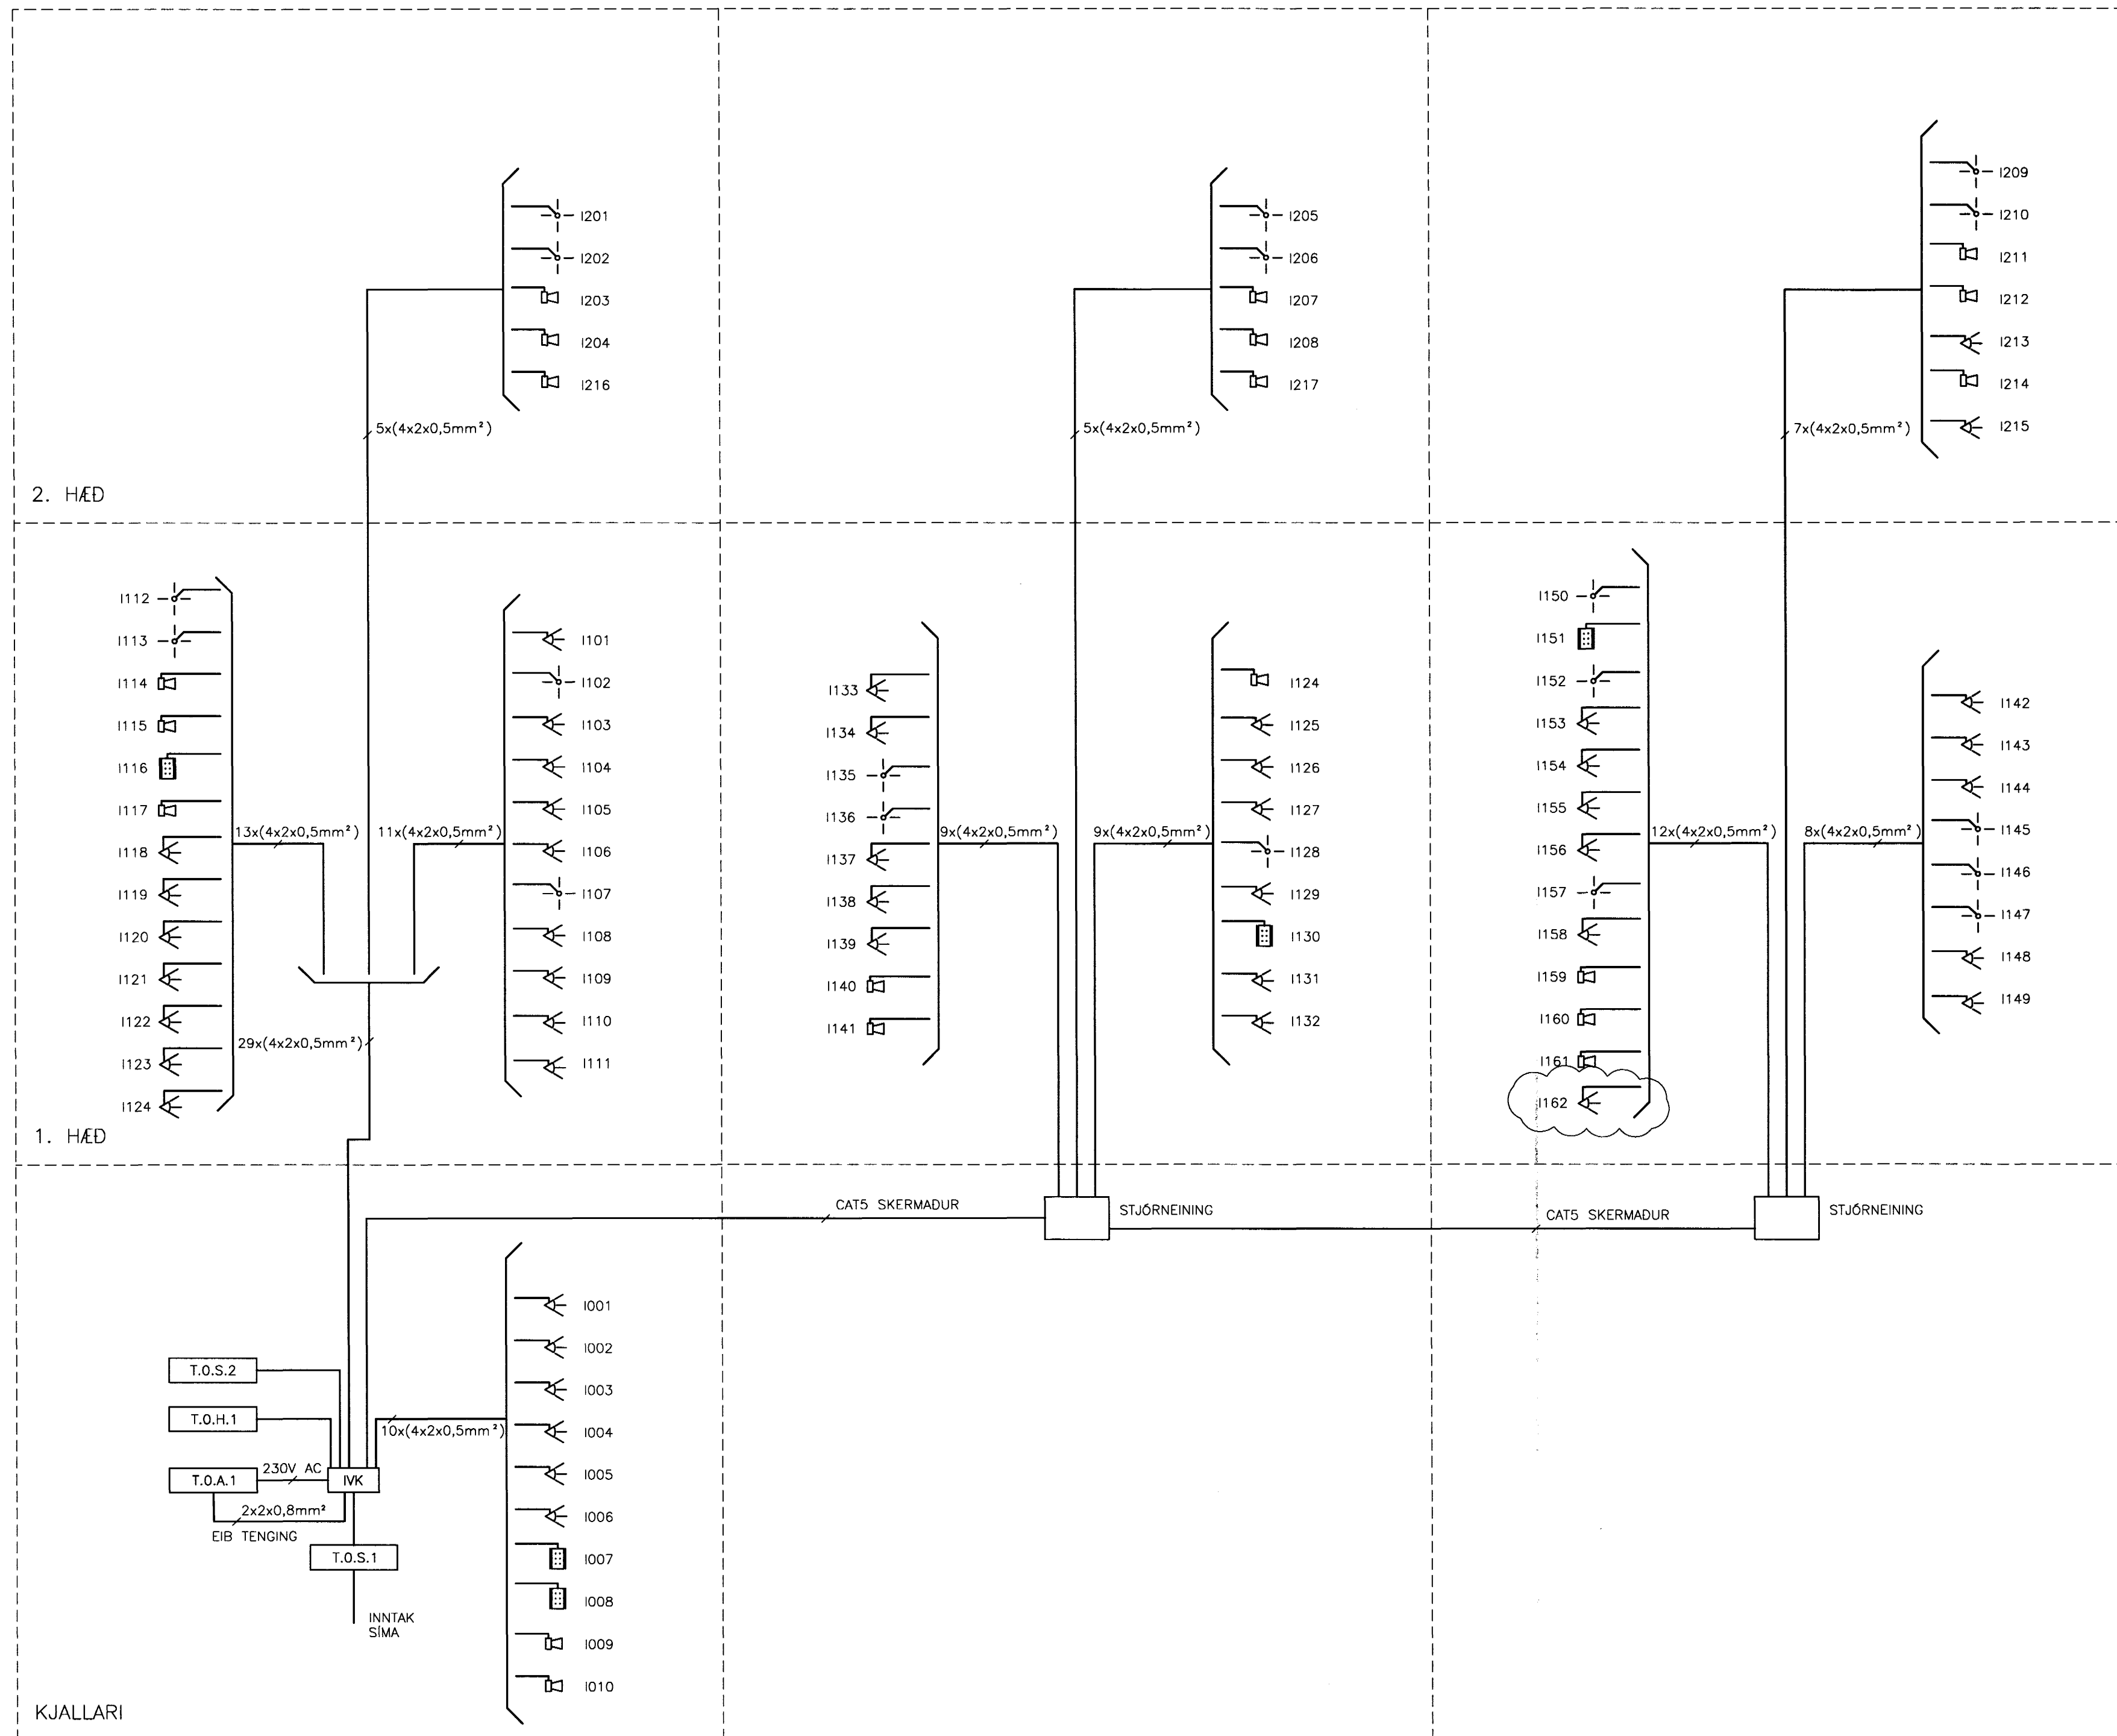
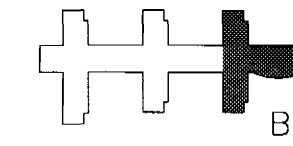
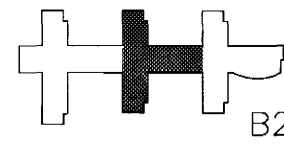


INNBROTAVIDVÖRUNARKERFI – KERFISMYND

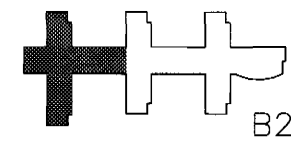


SKÝRINGAR:

- HREYFISKYNJARI (PIR), 90° SKYNJUN
- HREYFISKYNJARI (PIR), 360° SKYNJUN
- HLJÓDGAFI (SIRENA), H:2700mm
- TALNABORD, H:1600mm
- STJÖRNSTÖÐ INNBROTAVIDVÖRUNARKERFIS
- ADALTAFLA
- INNTAK SÍMA
- ADGANGSKORTAKERFI
- HÚSSTJÖRNARKERFI
- HLAUPANDI NÖMER EINGANG HÆÐ HÚSSINS SEM EINGANG ER Á GERD EINGANG (INNBROTAVIDVÖRUNARKERFI)

15/07/03 JC 071070-5069

B	07.07.03	HREYFISKYNJARI 1162	JJ	LL
A	13.06.03	STJÖRNEING OG STRENGIR	JJ	LL
BR.	DAGS.	BREYTING	REKN.	TEKN.

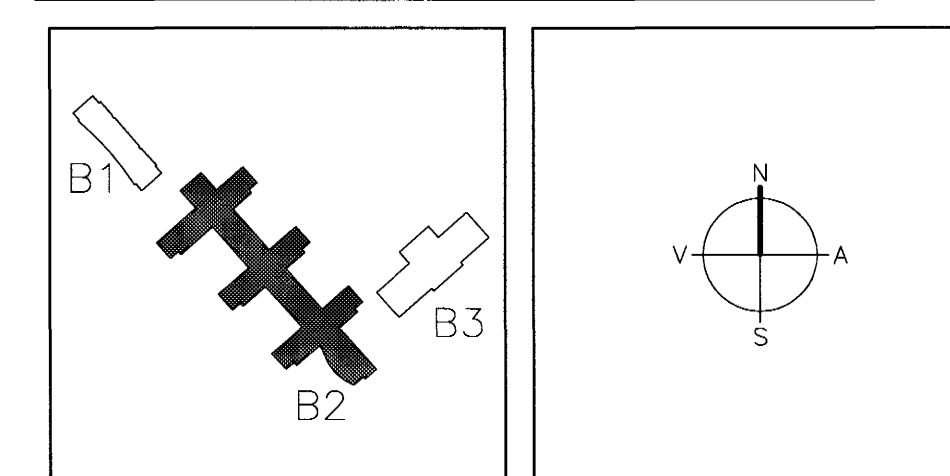

ARKITEKTAR
BERGSTABASTRÆTI 10, RVK
sími:551-1460, netfang:arkitekt@ishoff.is

FINNUR BJÖRGVINSSON
HILMAR ÞÓR BJÖRNSSON
SIGRÍÐUR ÓLAFSDÓTTIR

LANDMÖTUN. EINHAF/TEKN. JÚ/005
INGÍBJÖRG KRISTJÁNSDÓTTIR
MARGRÉT SIGURDARDÓTTIR

NYBYLAVEGUR 8 - 200 KÓPAVOGUR - Sími: 664 5300 - FAX: 664 5300 - NETFANG: landmotun@landmotun.is

VSÓ RÁÐGJÖF
BORGARTÚNI 20, 105 REYKJAVÍK, Sími 585-9000, Símbref 585-9010, Netfang vs@vso.is

SÓLVANGSVEGUR 4
LÆKJARSKÓLI

RAFORKLAVIRKI
INNBROTAVIDVÖRUNARKERFI
KERFISMYND

HANNA/TEKN. JÚ/005
ATH. EBF
SAMÞYKKT Su
KT.

KVARÐI
VERKNR. TEKN. NR. REYKJAVÍK 15.05.2002 BR.

00258 B2-R6-VK-001 B