
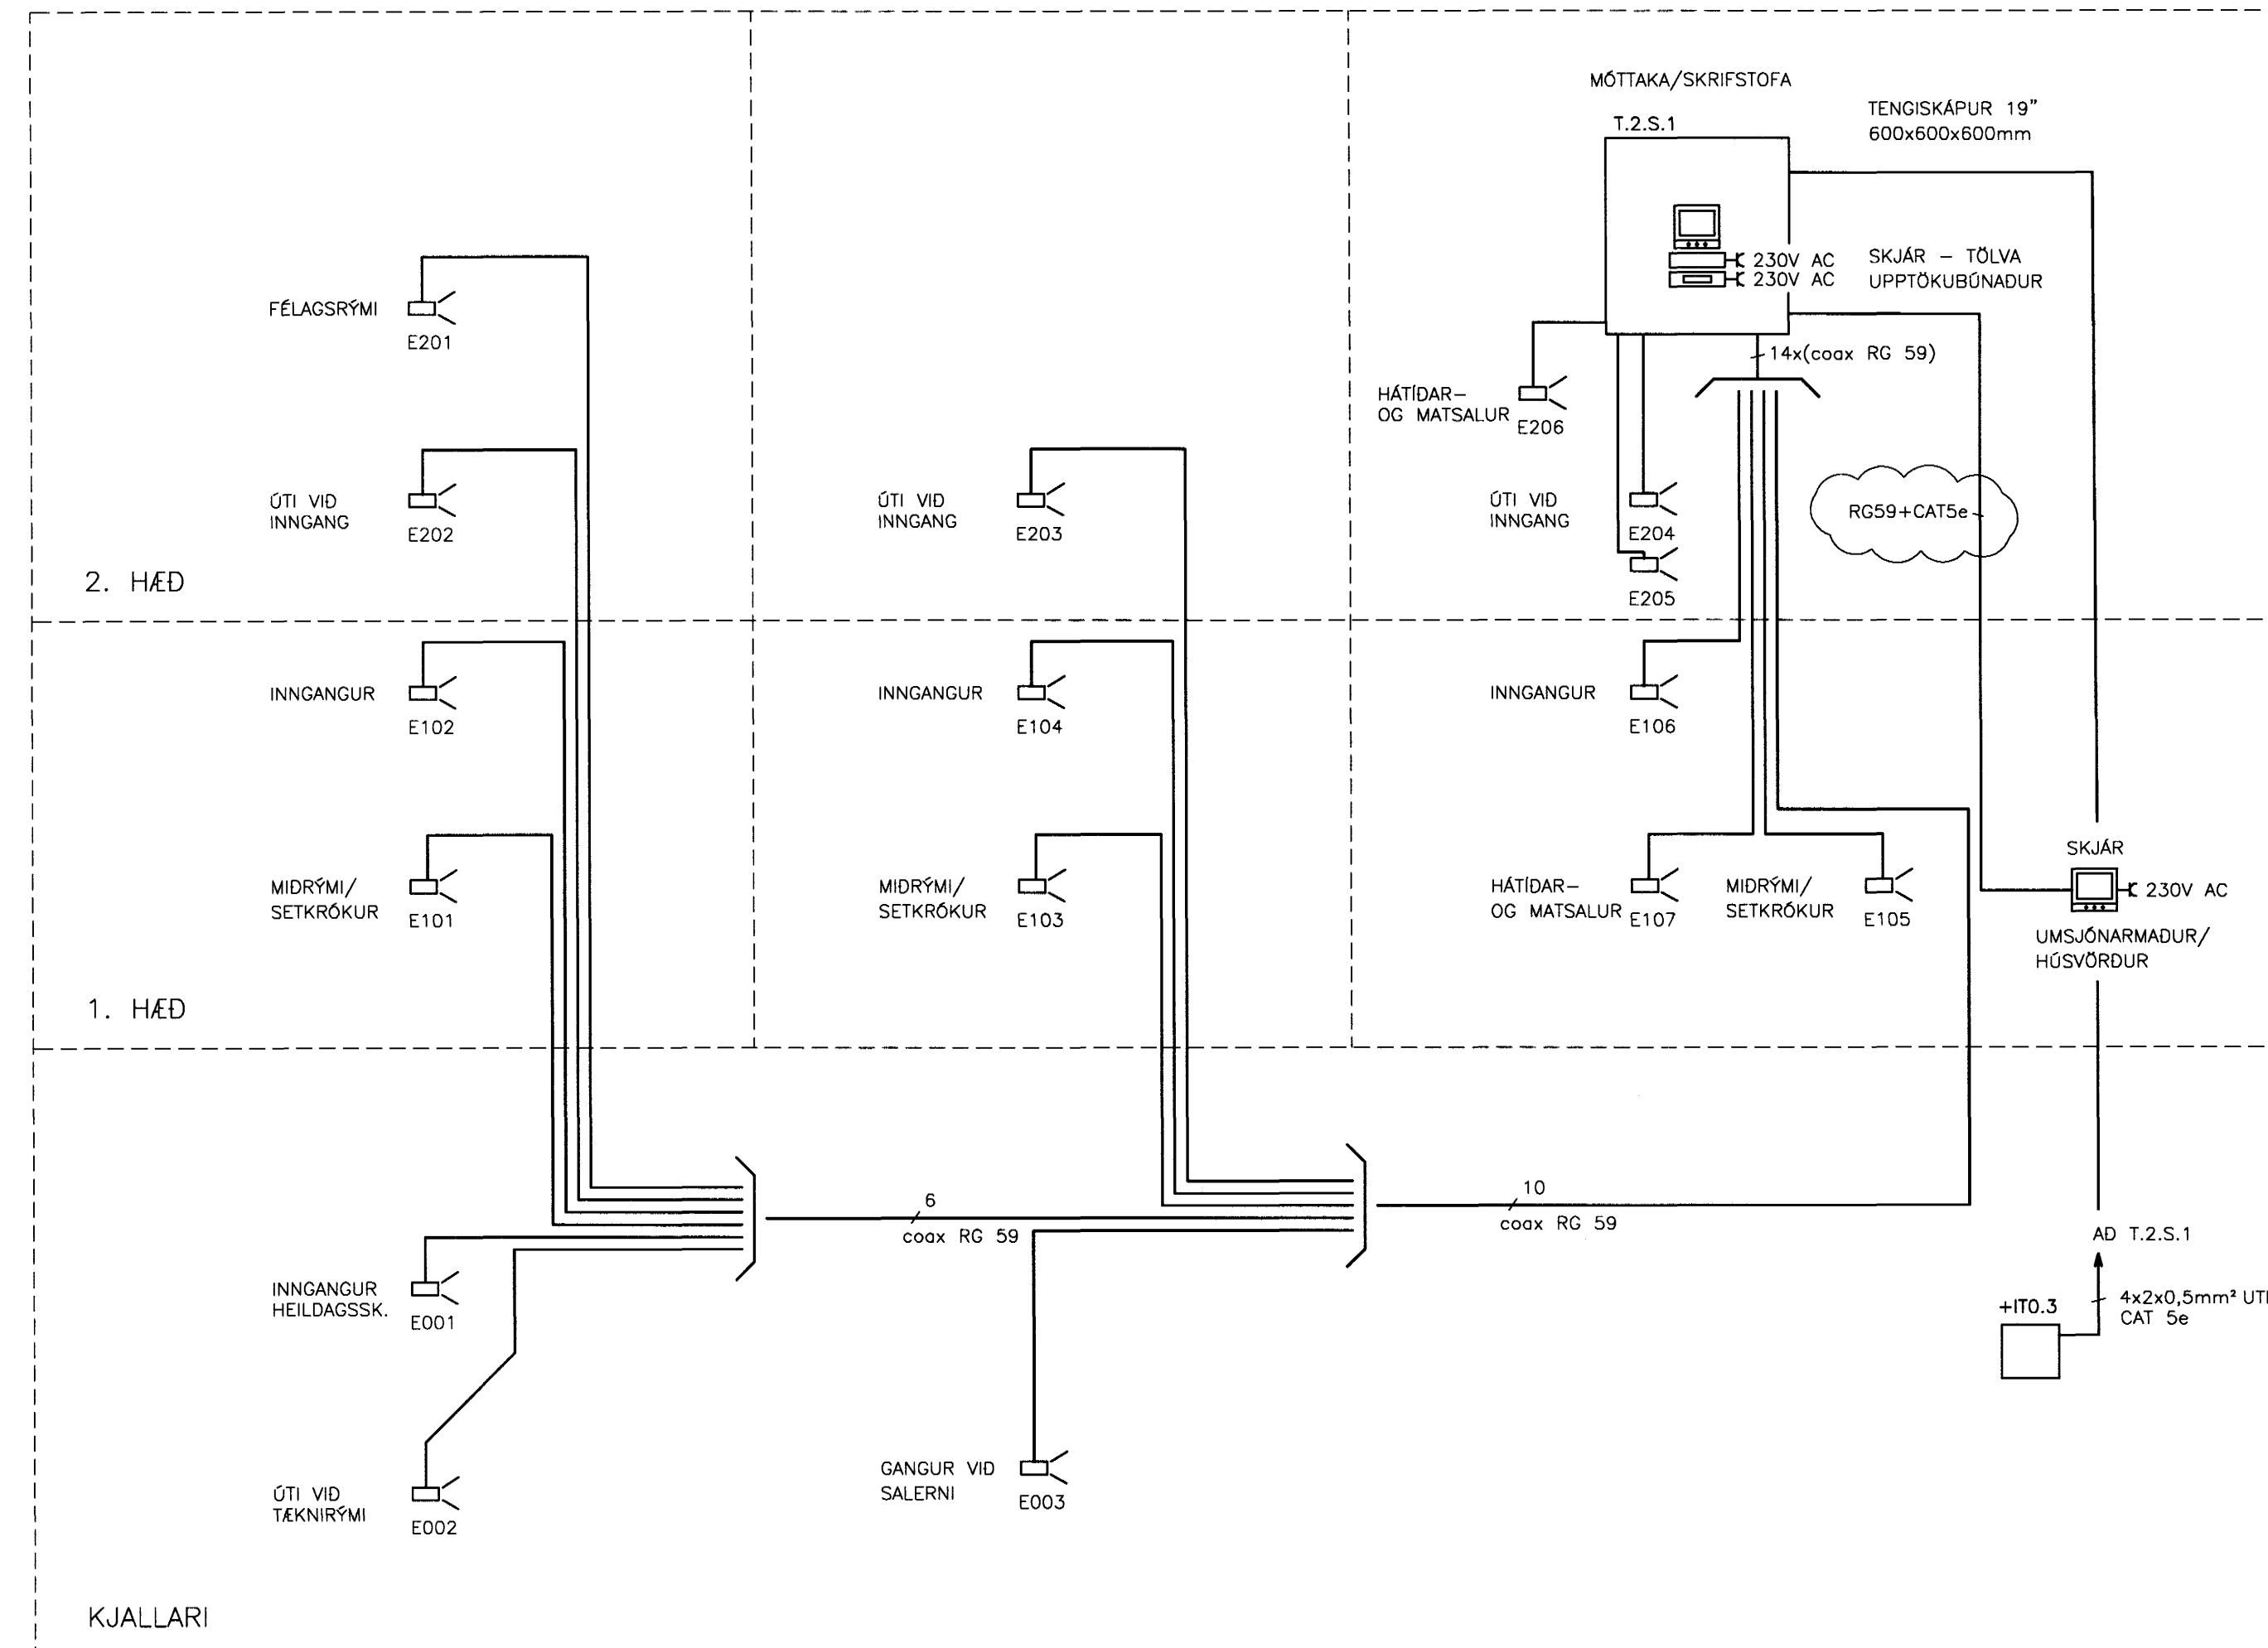
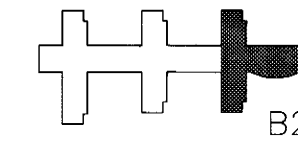
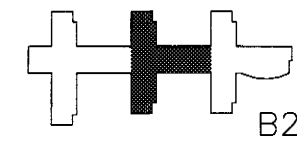


EFTIRLITSMYNDAVÉLAKERFI – KERFISMYND

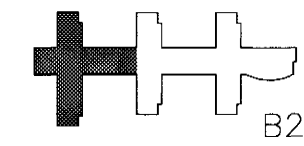

SKÝRINGAR:

- EFTIRLITSMYNDAVÉL
- UPPTÖKUBÚNADUR
- TÖLVA – SKJÁR

T.2.S.1


TENGISKÁPUR 19" (600x600x600mm)

- E 1 03 HLAUPANDI NÓMER EFTIRLITSMYNDAVÉLAR
- HÆÐ HÚSSINS SEM EFTIRLITSMYNDAVÉL ER Á
- GERD, HEITI EININGAR/KERFIS

E: EFTIRLITSMYNDAVÉL

15/7/03 SC 071070-5069

BR.	DAGS.	BREYTING	JJ.	LL.	REKNI.	TEIKN.
A	18.03.03					

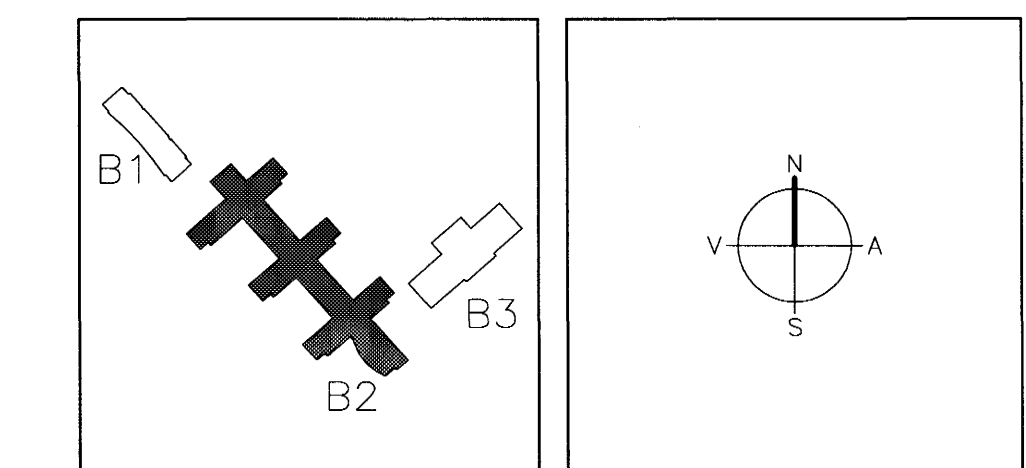

**ARKITEKTAR**  
BERGSTADASTRÆTI 10, RVK  
sími: 551-1460, netfang: arkitekt@shoff.is

**FINNUR BJÖRGVINSSON**  
**HILMAR ÞÓR BJÖRNSSON**  
**SIGRÍÐUR ÓLAFSDÓTTIR**

**LANDMÖTUN.** HANNA/TEIKN. JJ/005  
INGIBJÖRG KRISTJÁNSDÓTTIR  
MARGRÉT SIGURDÁRDÓTTIR

NYBYLAVEÐUR 6 - 200 KÓPAVOGUR - Sími: 554 5300 - Fax: 554 5380 - Netfang: landmotun@landmotun.is

**VSÓ RÁÐGJÖF**  
BORGARTÚN 20, 105 REYKJAVÍK, Sími: 585-9000, Símbref: 585-9010, Netfang: vs@vsao.is

**SÓLVANGSVEGUR 4**  
**LÆKJARSKÓLI**

RAFORKUVIRKI EFTIRLITSMYNDAVÉLAKERFI KERFISMYND

HANNA/TEIKN. JJ/005  
ATH. EFTIRLITSMYNDAVÉLAKERFI  
SAMÞYKKT Su  
KT. 110858-7789

KVARDI VERKNR. TEIKN. NR. REYKJAVÍK 15.05.2002 BR.

00258 B2-R8-VK-001 A