


HITABLÁSARAR, KERFISMYND

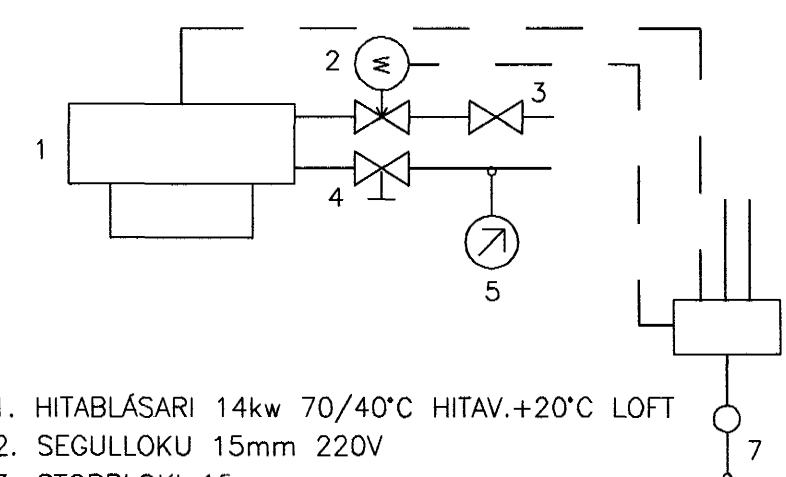

1. HITABLÁSARI 14kw 70/40°C HITAV.+20°C LOFT
2. SEGULLOKU 15mm 220V
3. STOPPLOKI 15mm
4. STILLITÉ 15mm
5. HITAMÉLIR
6. STJÓRNEINING, HRADASTÝRING
7. VEGGHITASTILLIR

ÖLL ÓNEFND MÁL Ø10

Samþykkt þann
27 NOV. 2003
Byggingafultrúinn í Hafnarfirði
E.h. Sigurbjartur Halldórsson

SKÚTAHRAUN 6, HAFNARFIRÐI			
HITALAGNIR RÚMMYND 1.-OG 2.HÆÐAR			
V S B VERKFRÆDISTOFA		Breyting: A : 20.03.02 REYNDARTEIKNING	
Bjarrahraun 20 • 220 HAFNARFJÖRDUR Sími 695-8800 • FAKS 695-2910 Netfang: veb@vsb.is, ic710795-2899		Samþ.: Björn Guðafsson	Kl.: 180550-4889
Mkv: 1:50	Teknið: EBLÁ	Yfirfarið:	Hannað: EB
Dag: 16.03.01	Nr: 00812-P09A		