



MÆLAGRIND SNJÓBRÆDSL
KERFI VESTUR AUSTUR OG EITUREFNASVÆÐI

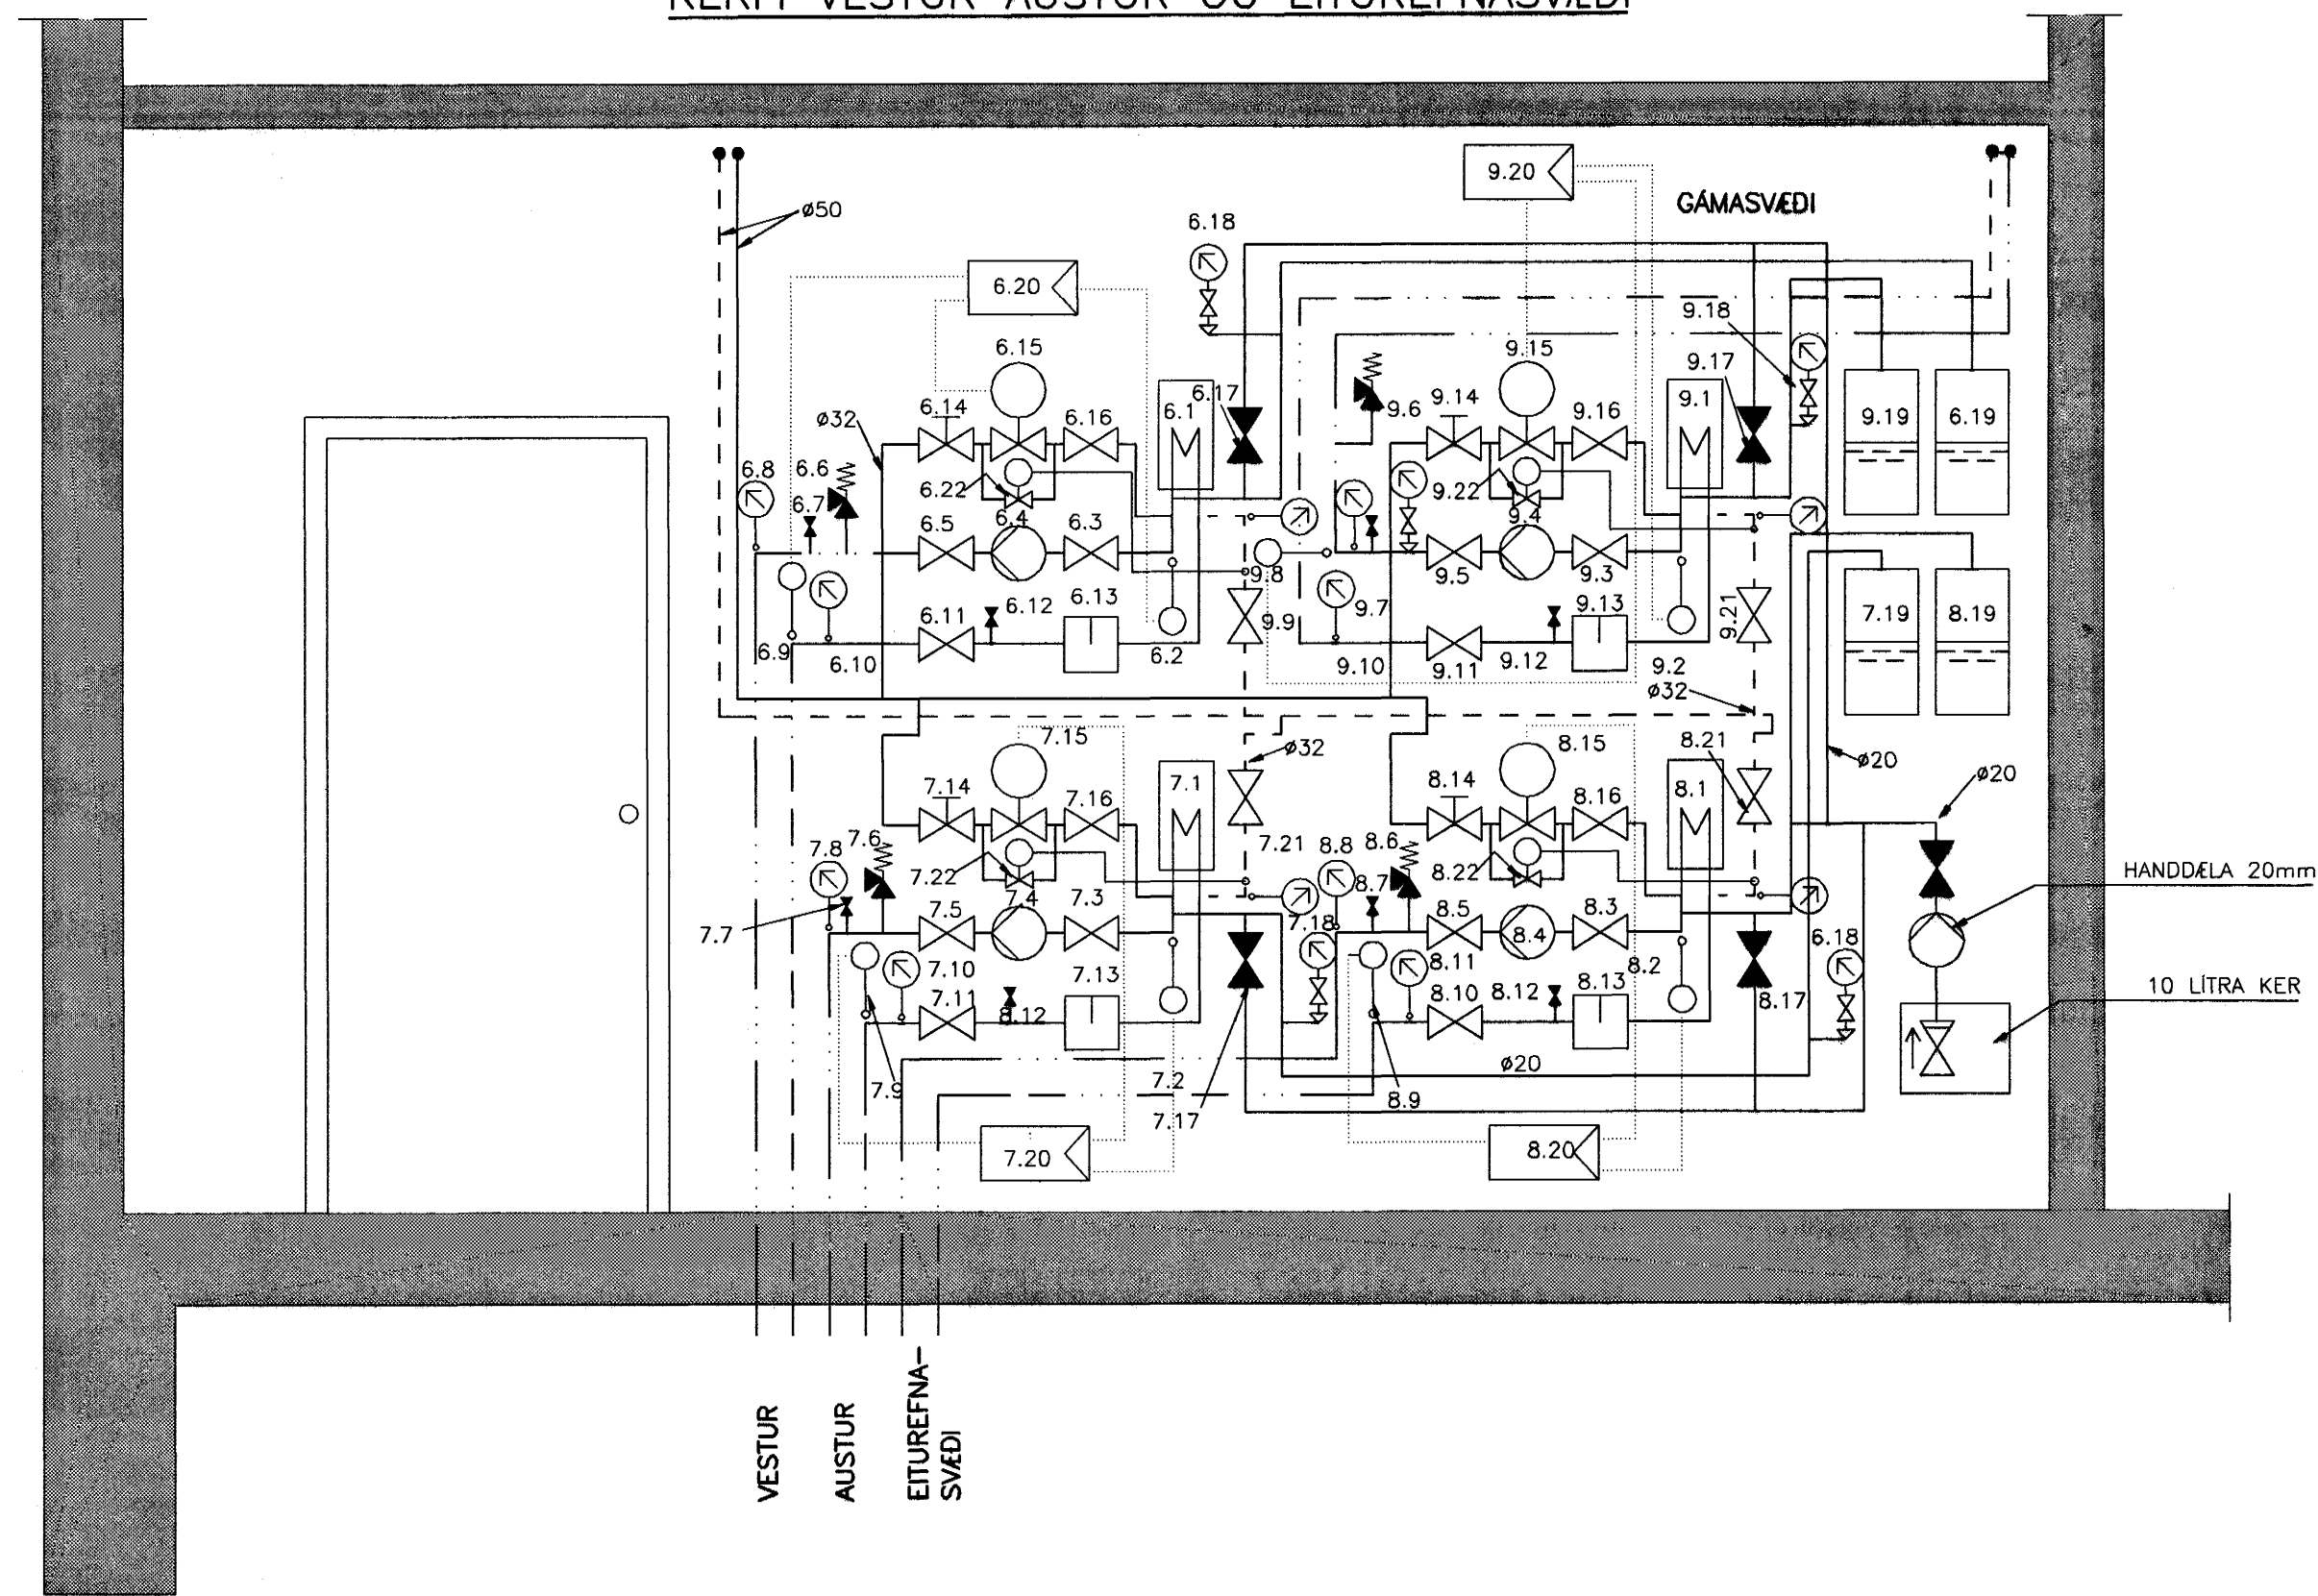


MÆLAGRIND (AFRENNSLI)
SNJÓBRÆDSLUGRIND GANGSTIGAR

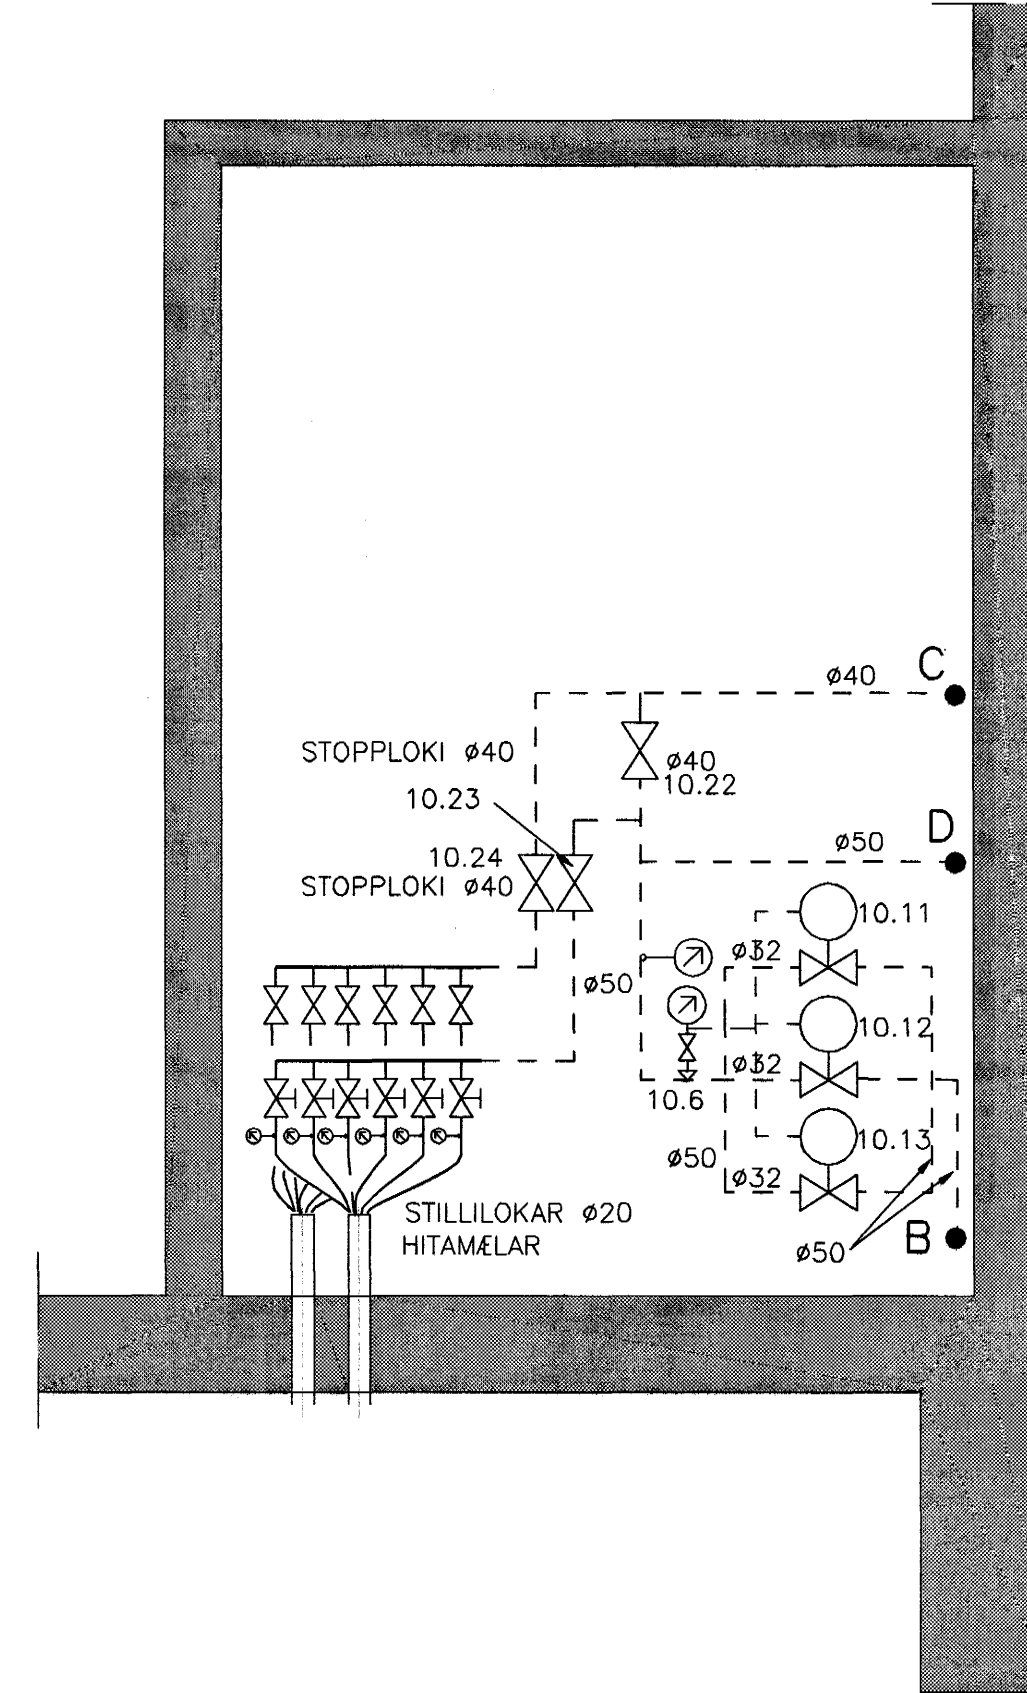

INNTAKSGRIND

SNJÓBRÆDSLUGRIND GÁMASVÆÐI

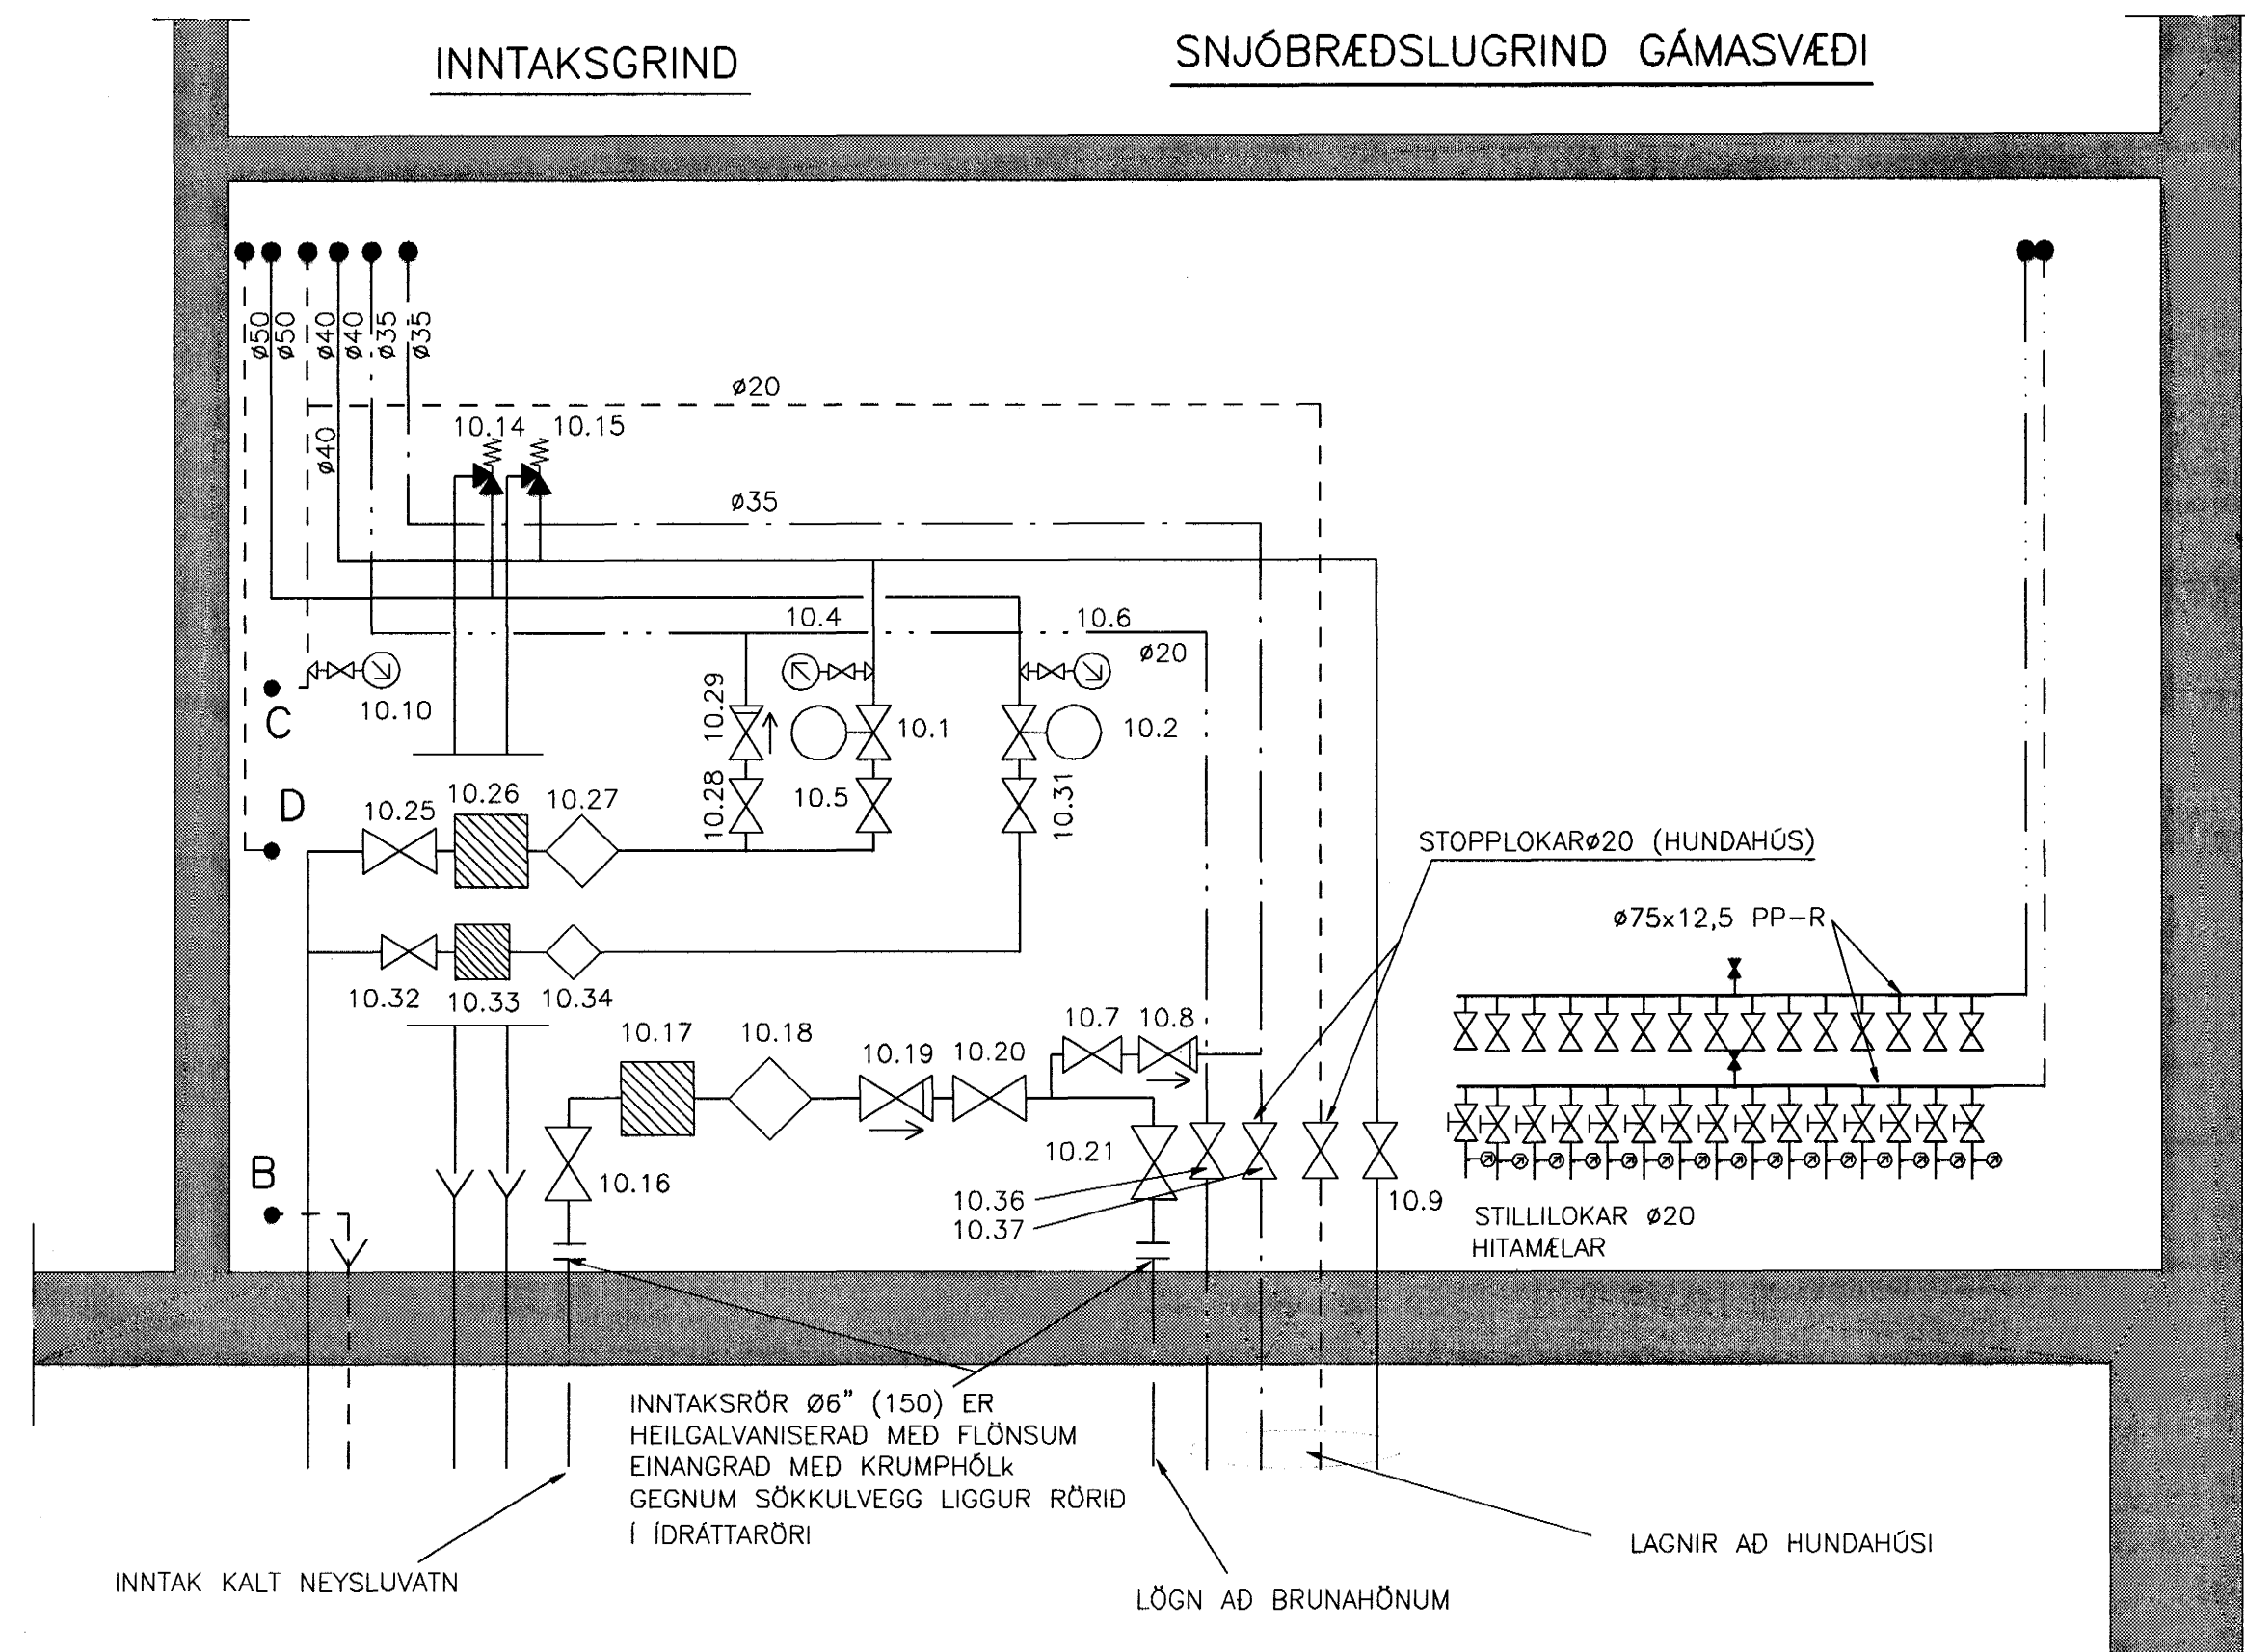

INNTAKSRÖR Ø6" (150) ER HEILGALVANISERAD MED FLÖNSUM EINANGRAD MED KRUMPHÖLK GEGNUM SÖKKULVEGG LIGGUR RÖRID Í DRATTARÖRI

LÖGN AD BRUNAHÖNUM

LAGNIR AD HUNDAHÓSI

Samþykkt þann
27 NOV. 2003
Byggingafrúnn / Hafnarfirði
F.h. Sigurbjartur Halldórsson

SKÚTAHRAUN 6, HAFNARFIRÐI	
HITA-OG HREINLETISLAGNIR SNJÓBRÆDSLULAGNIR VEGGMYNDIR	C :20.03.02 REYNDARTEIKNING B :28.01.02. BAKRÁS BREYTT A :28.05.01. Br.á vatnsinntaki að kröfu Vatnsveitu Hfj.
VSB VERKFRÆDISTOFA	Breyting:
Samp.: Björn Guðstefson	Kl.: 180550-4889
Hennar: SÁS	
Miv: 120	Talnad: SÁS
Yfirfarð:	
Daga: 16.03.01	Nr: 00812-P14C