




SNID D  
1:50 L04

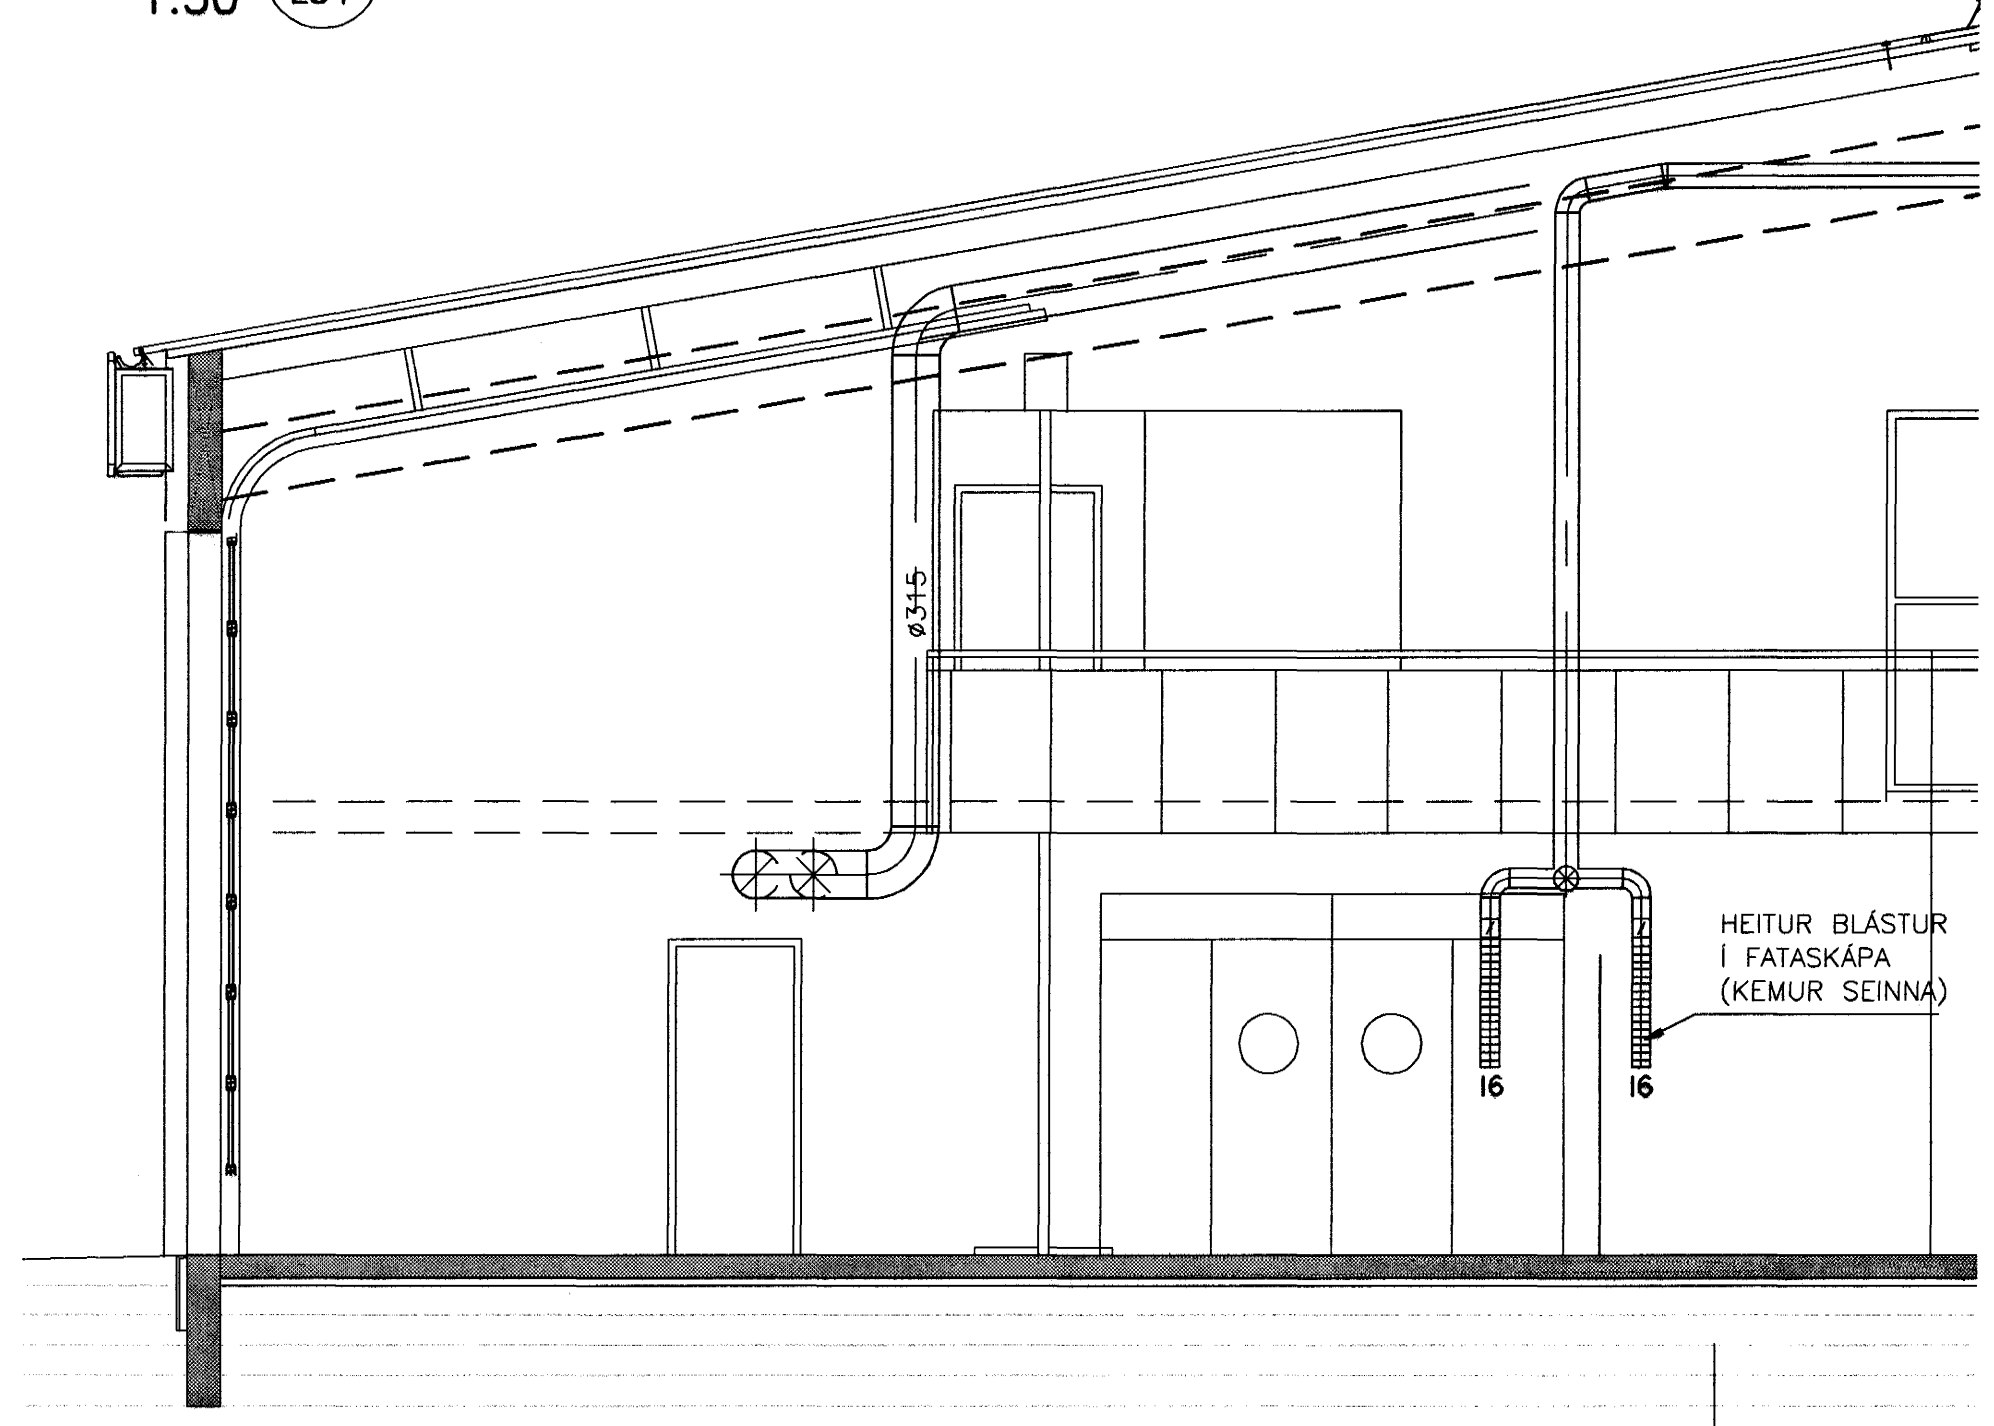


SNID A  
1:50 L01

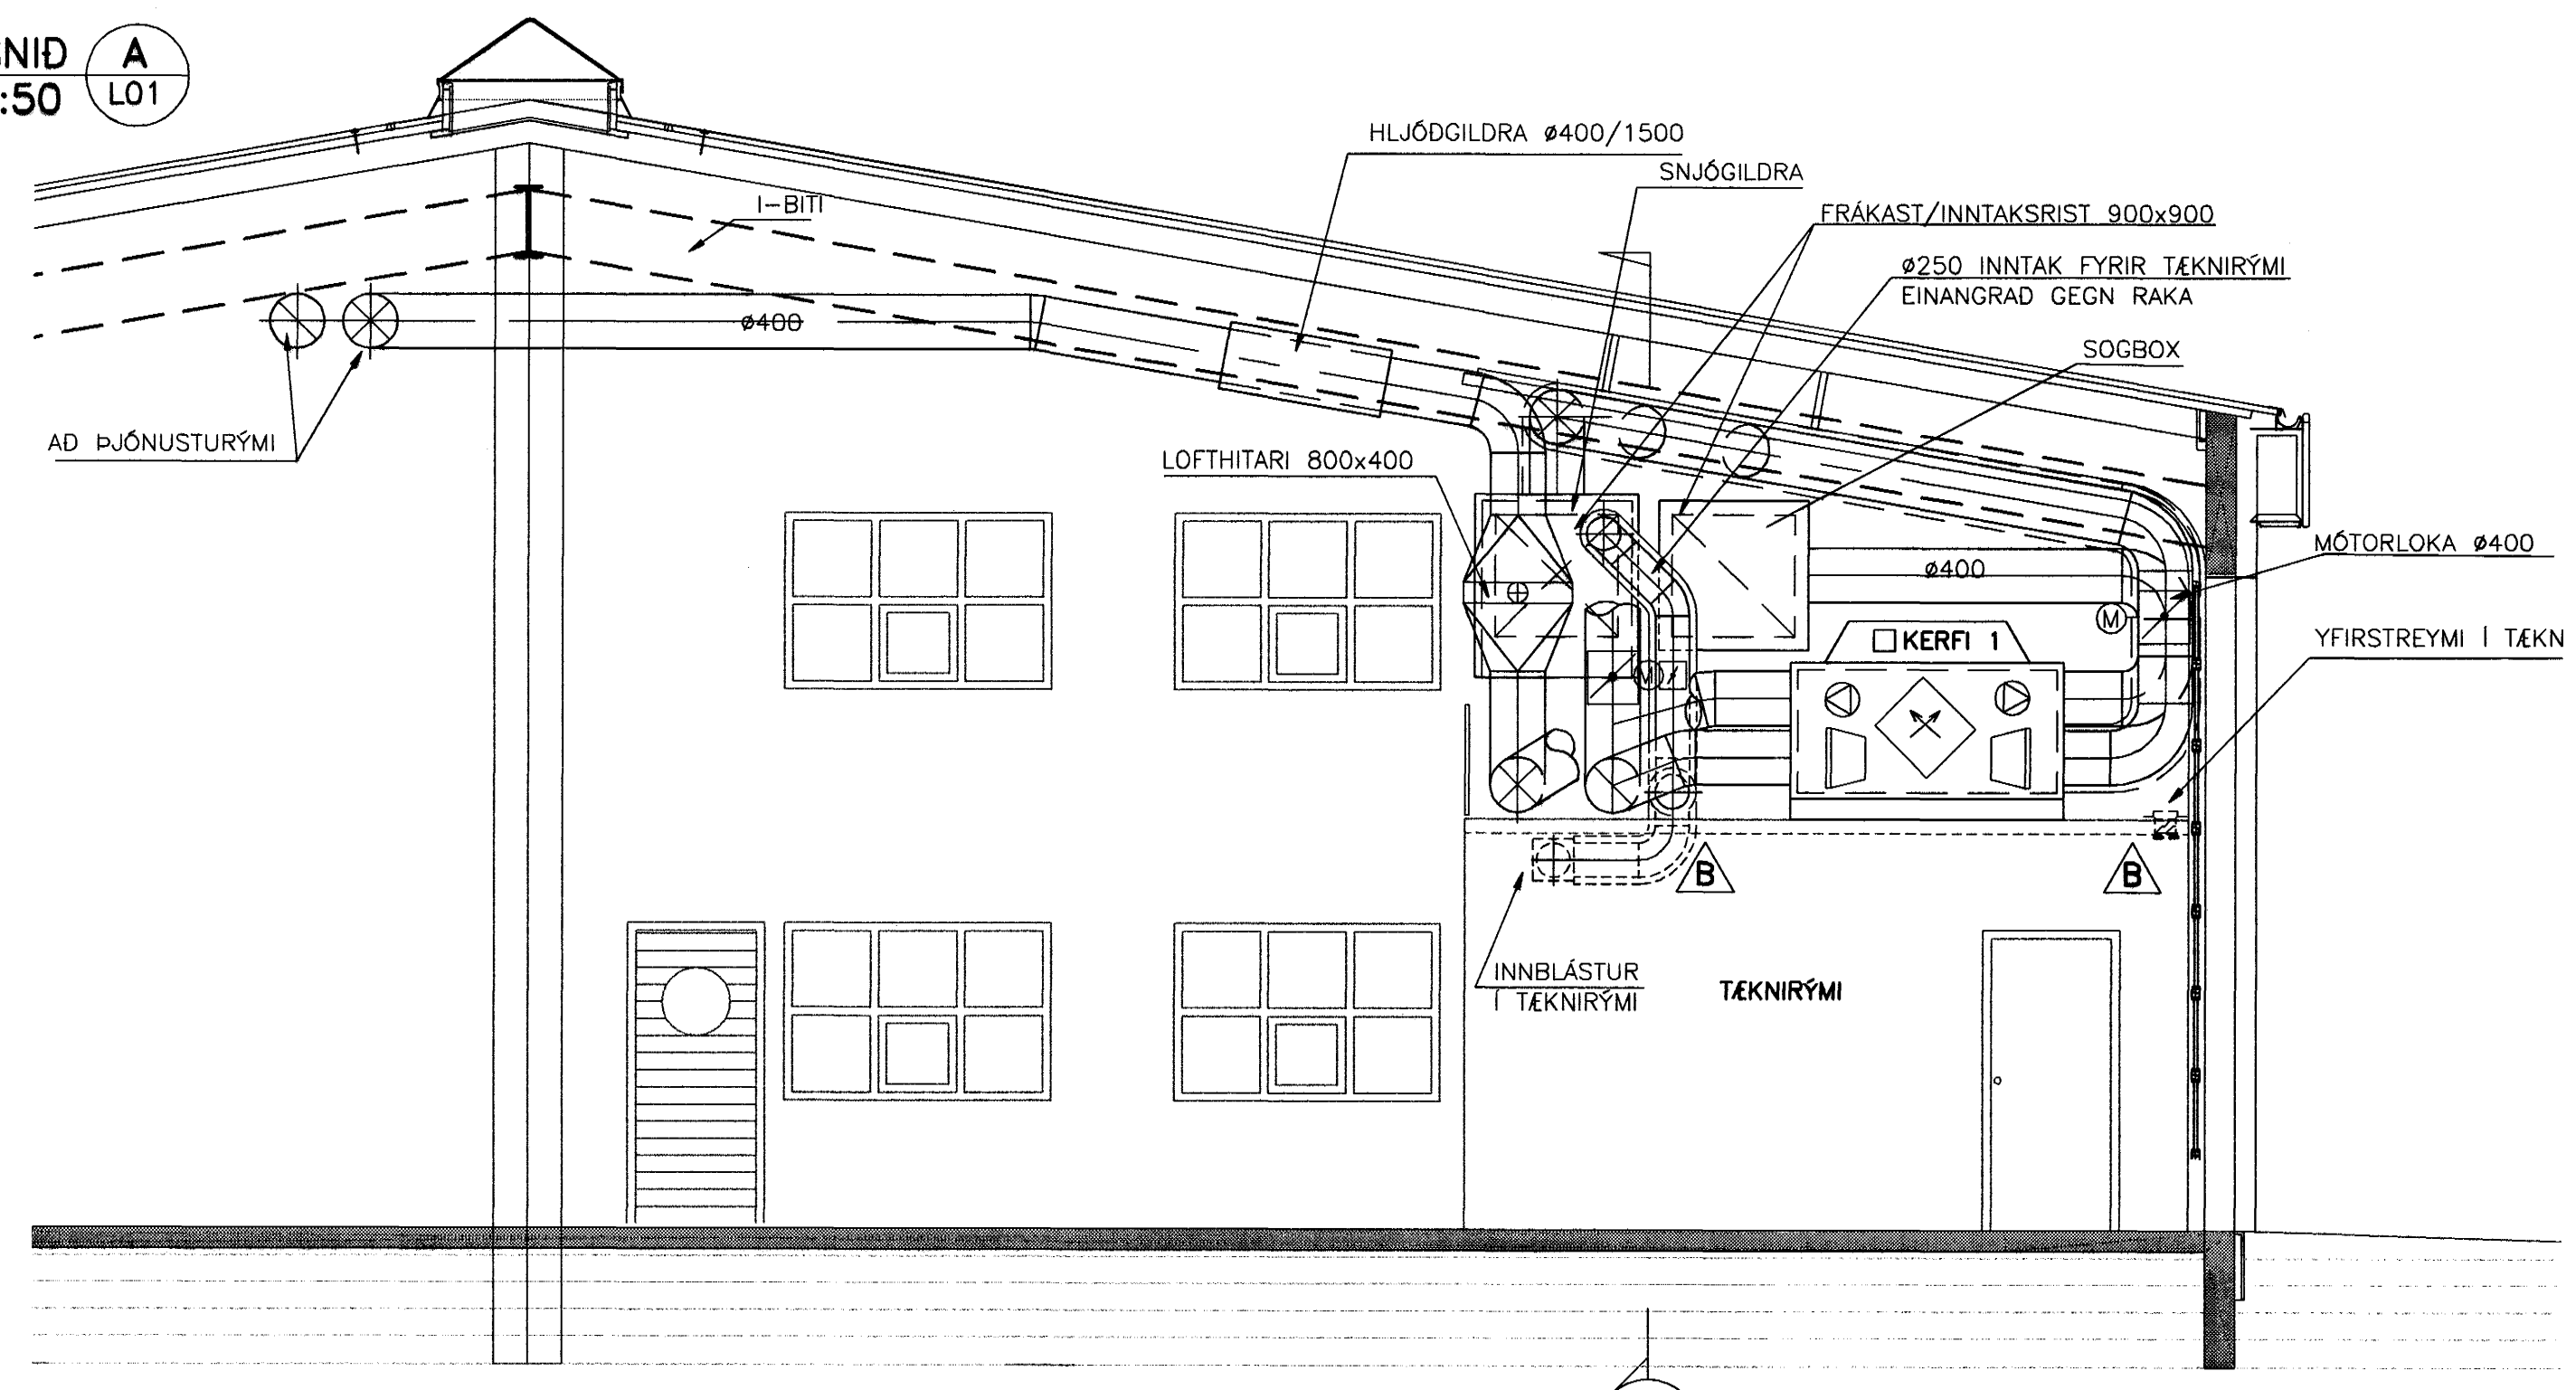


SNID B  
1:50 L04

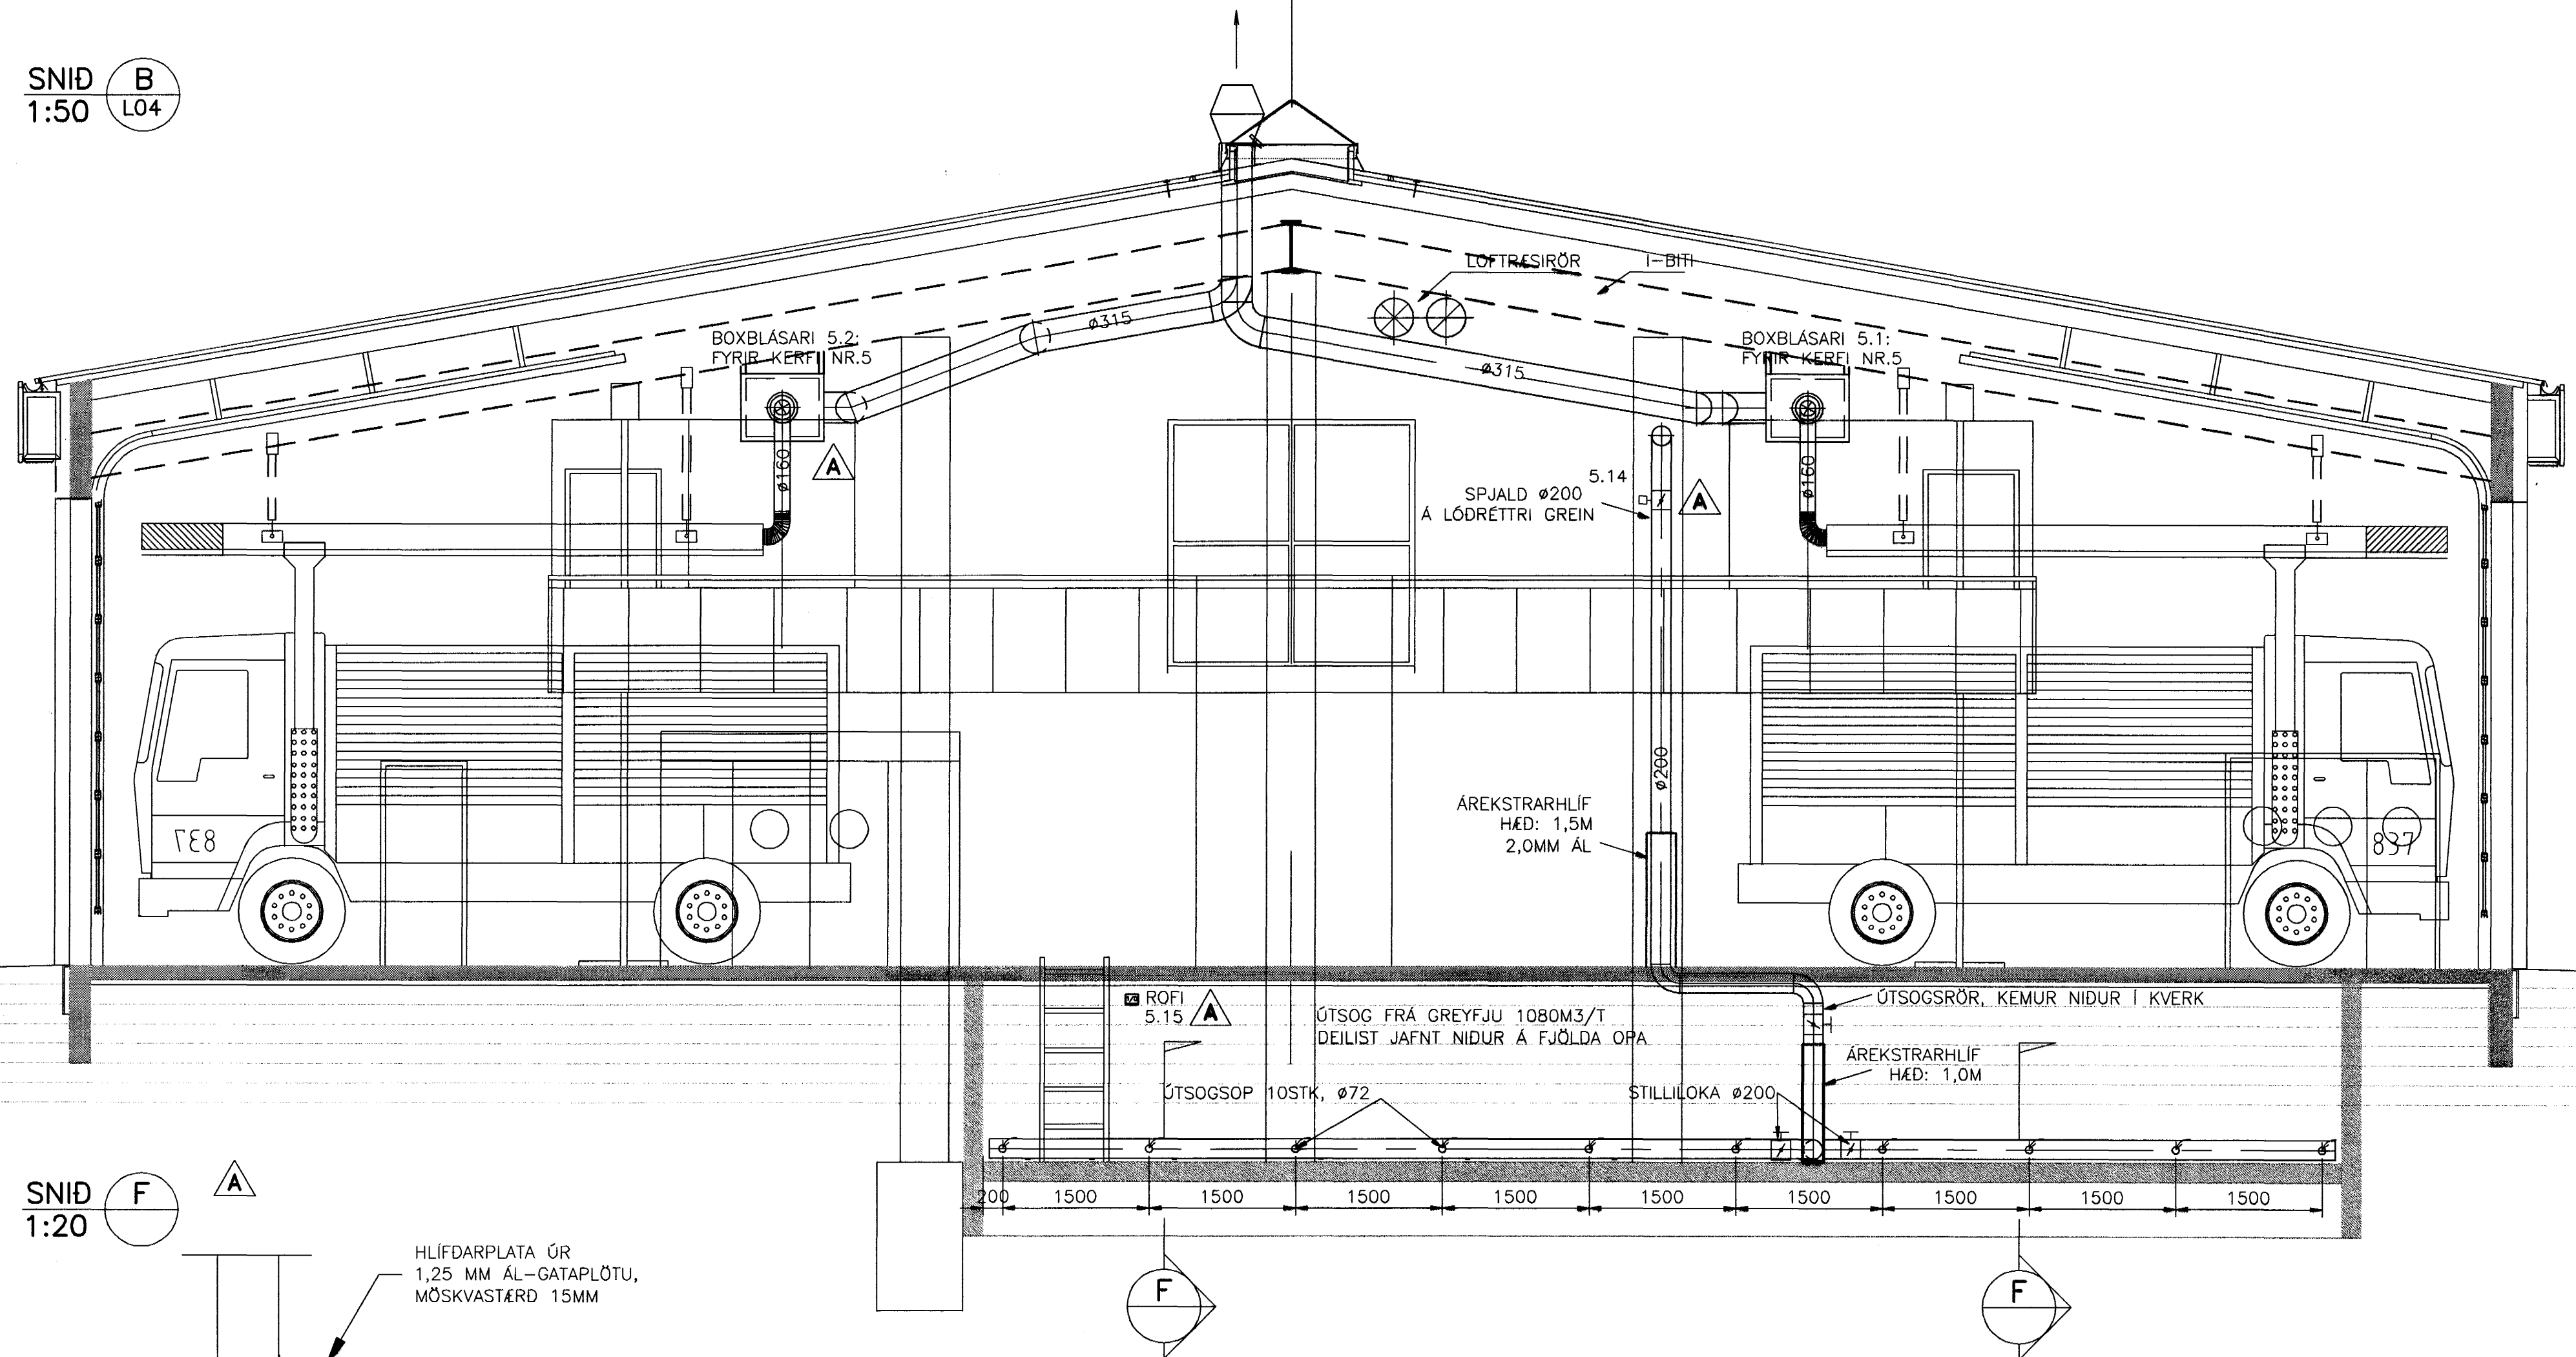

SNID C C  
1:50 L04 L02

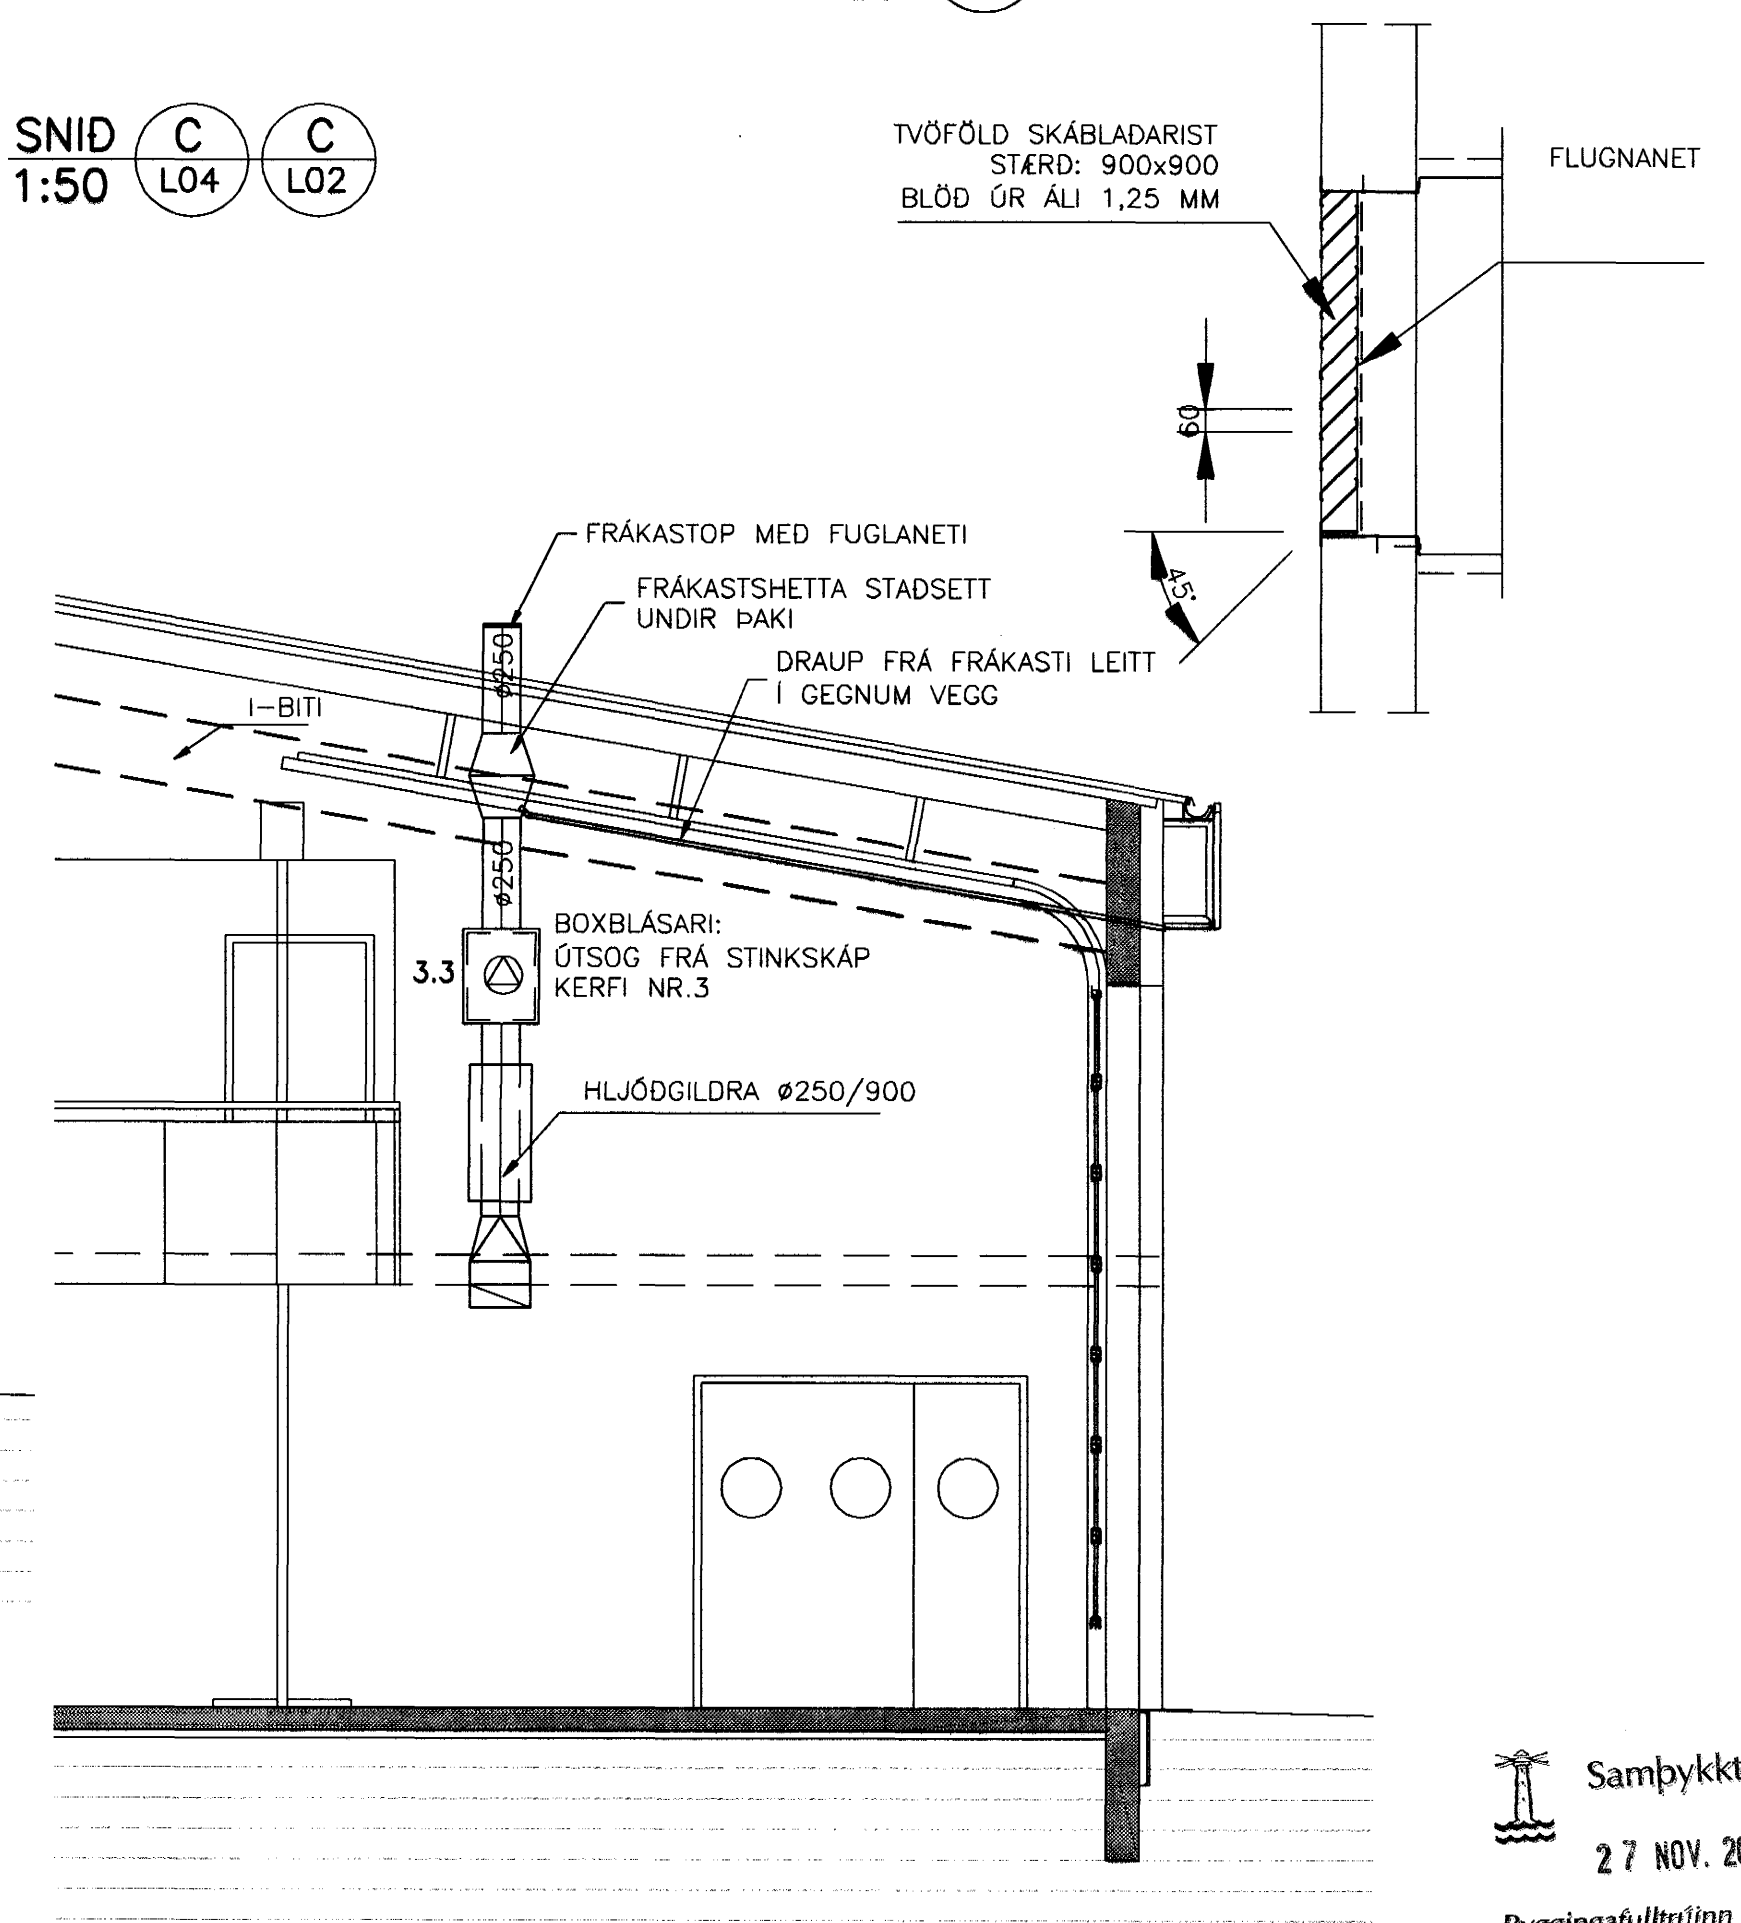

SNID F  
1:20

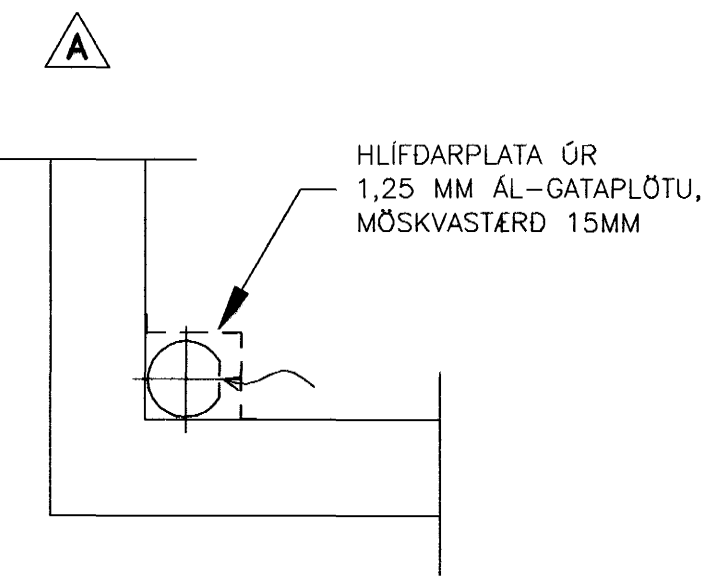

<b>SKÚTAHRAUN 6, HAFNARFIRÐI</b>	
LOFTRÆSING SNIDMYNDR	
<b>VSB</b> VERKFRÆÐISTOFA	B: 19.03.02 INNTAK F. TÆKNIRÝMI/FRÁKASTSRIST Breyting: A: 21.02.02 SNID B OG F
Samþ.: Björn Guðarsson	Kl.: 180550-4889
Mikr: 1:50	Tekni: GHJ
Daga: 16.03.01	Nr: 00812-L06B

Samþykkt þann  
27. NOV. 2003  
Byggingafulltrúinn í Hafnarfirði  
Eh. Sigurbjartur Halldórsson