


OFN NR.	STAÐUR HÁHOLT 19	HITAÞÖRF KCAL/H	MESTA LENGD	MESTA HÆÐ
101	ELDHÚS	1,460	1400	500
102	HJÓL/VAGNAR	1,170	1000	600
103	ANDD	790	800	600
104	HERB	980	1400	600
105	ÞVOTTUR	610	800	600
106	GEYMSLA	470	600	600
107	BILGEYMSLA	3,060	2200	600
108	HJÓN	1,910	1400	600
109	BAD	720	800	600
110	HERB	980	1400	600
111	STOFA	1,870	2200	400
112	STOFA	1,870	2200	400
113	VS	250	500	600
SAMTALS=		16,140		

GRUNNMYND 1:50

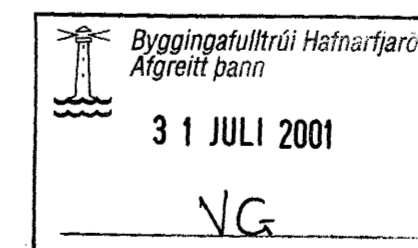

AM. 21/7/01
VG

01	JÚLÍ 01	HERBERGJASKIPAN BR G.H.	
Br.	Dags.	Eðli breytinga	Sign
HÁHOLT 19 HAFNARFIRÐI HITA-VATNS OG FRÁRENNSLISLAGNIR MKV. 1:50 DAGS. SEPT. 2000 VERK NR. 2042 TEIKN. NR. 2-02 HANNAÐ SIG. ÞORLEIFSS. KT. 241148-3009 TEIKNAD G.H. YFIRFARIÐ TEKNIÞJÓNUSTA SIGURDAR ÞORLEIFSSONAR ehf STRANDGÖTU 11 220 HAFNARFIRÐI Sími 555-4255 FAX 565-2875 E-mail taeknihjonusta@islandia.is			