


2. hæð

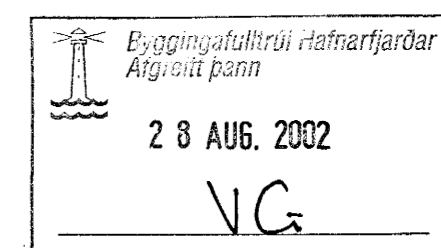

breytt
dags. 1 0.07.2002

AN2 Arkitektar

Teiknistofa Nethyl 2
Eyjólfur Bragason arkitekt fal

sm: 5874555 fax: 5874551 e-mail: eyj@an2.is heim: 50253-0389
GSM: 8978482

Ei: Eyrup

Klukkuberg 26

ris hæðar

mællivert
1:50

verk nr 379 1 - 1577

teikning nr. af