




SIDE VIEW, EAST WALL

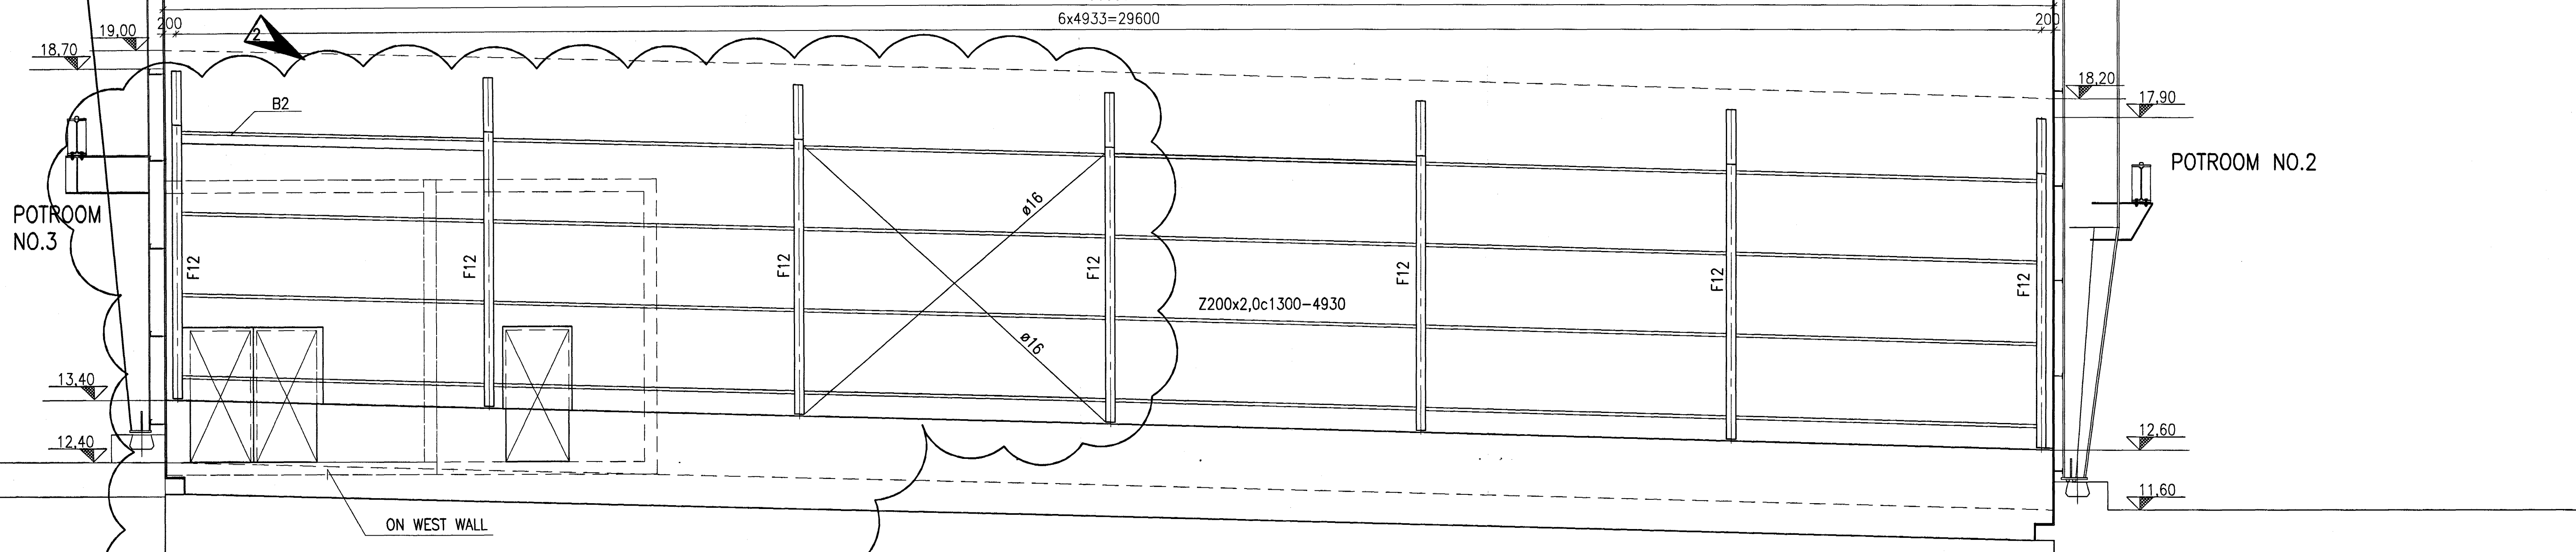

PLAN VIEW, ROOF

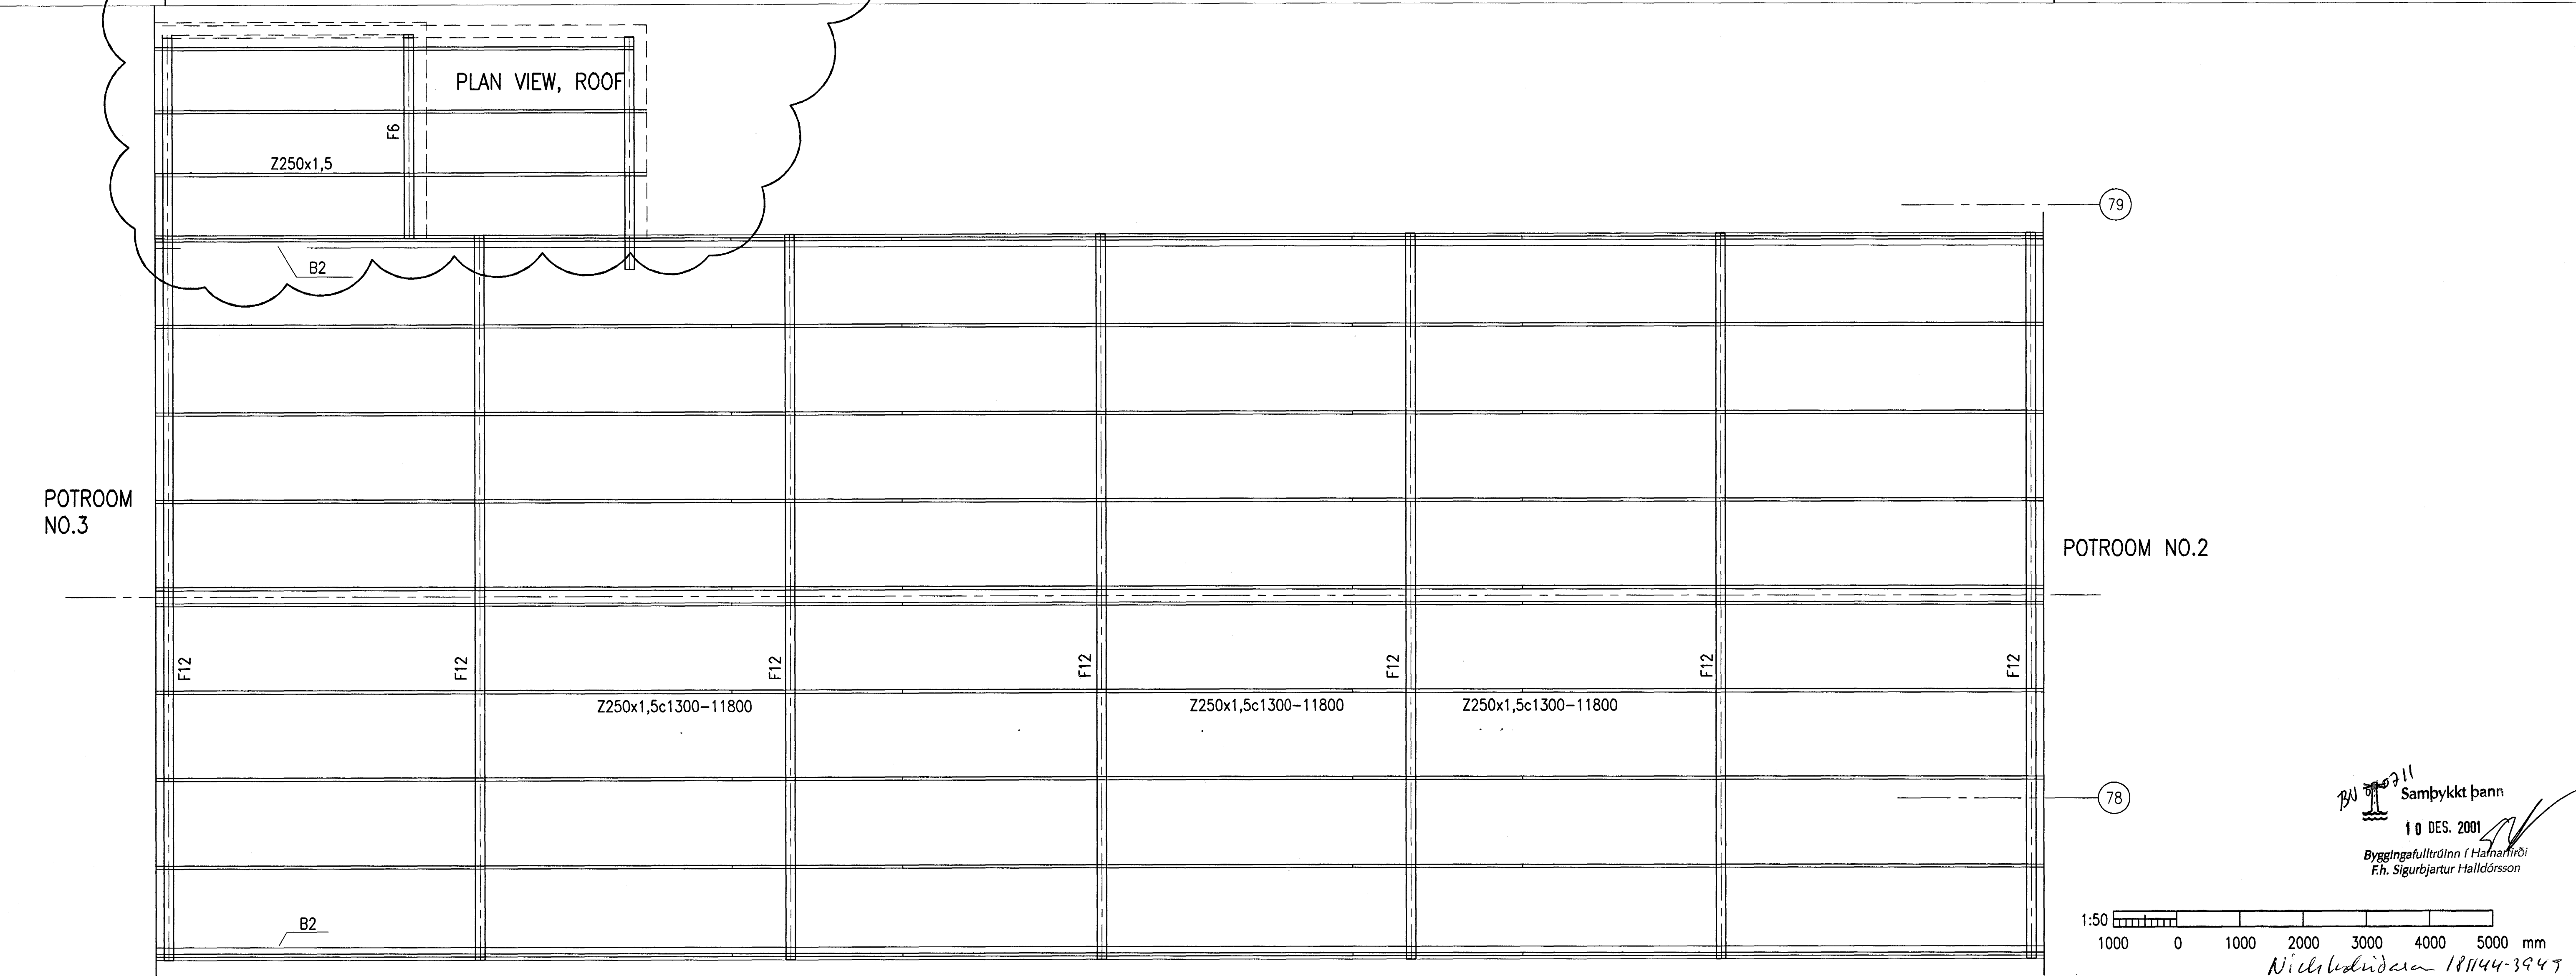

Samþykkt þann  
10 DES. 2001  
Byggingafulltrúinn í Hafnarfirði  
Fh. Sigurbjartur Halldórsson

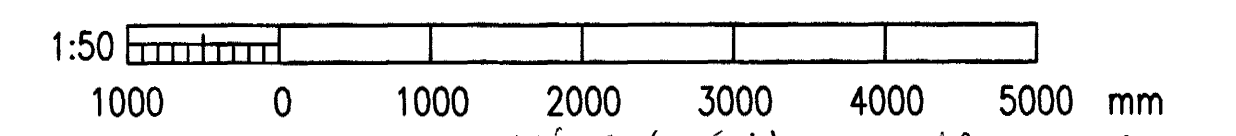

Nilsudridara 181144-3547

<b>VST CONSULTING ENGINEERS Ltd.</b> Armula 4 108 Reykjavik Iceland Tel:+354 569 5000 Fax:+354 569 5010	DRAWN 96.07.11 SGI APPROVED 96.07.11 NI PROCESS 96.07.11 NI PROJECT 96.07.11 NI SCALE 1:50 FORMAT AT	PASSAGEWAY BUILDINGS <b>STRUCTURAL STEEL</b> BUILDING 78-79 SIDE AND PLAN VIEW	95.120 - 28.155
	<b>ICELANDIC ALUMINIUM COMPANY LTD.</b>	ALESA ALUSUISSE ENGINEERING LTD. ZURICH SWITZERLAND	79000-35255
ISAL <b>ICELANDIC ALUMINIUM CO. LTD</b>		188.255	

REV. NO.	DATE	REVISION	BY	APP.	REV. NO.	DATE	REVISION	BY	APP.	NOTES	REFERENCE DRAWING	DRAWING NUMBER
2	2001.11.26	KELIADSTADA I TENGIBYGG. 78-79, M.L. 57		NI							B2	28.160
1	1996.08.22	APPROVED FOR CONSTRUCTION		NI							F6	28.159
											F12	28.158

This drawing is our property and given for personal use only. It may not be copied or made available to others without our permission. The receiver is responsible for any misuse.

