



SNID F-F 1:10

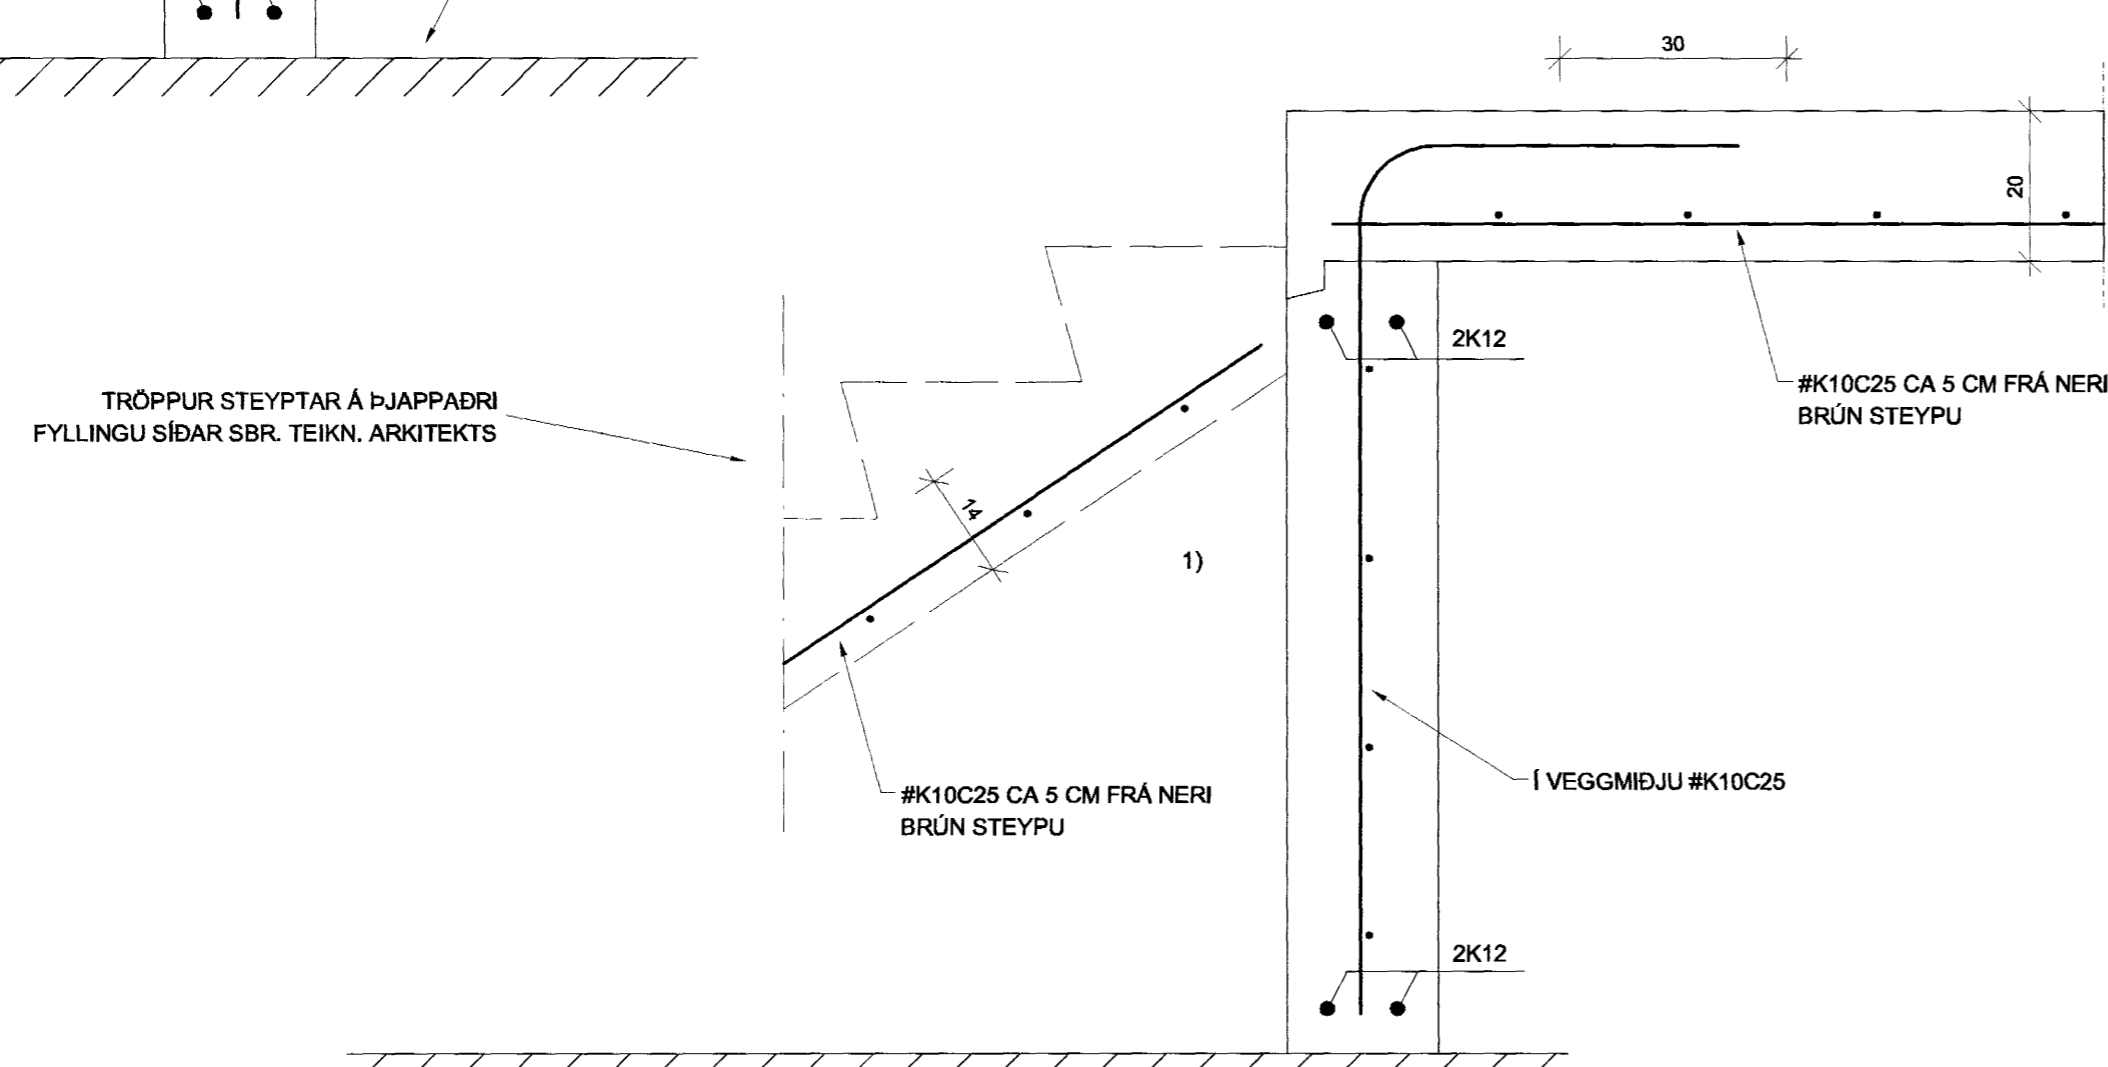

SNID G-G 1:10

Byggingafulltrúi Hafnarfjarðar  
 Afgreitt þann  
 05 MAI 2003

1) BREYTT 5/4 2003 ANDDYRISSÓKKLI BREYTT KMP

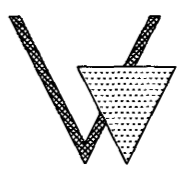AUSTURGATA 43		HAFNARFIRÐI	
VIÐBYGGING			
UNDIRSTÖÐUR OG BOTNPLATA			
SNID			
HANNAÐ: KMP	TEIKNAD: KMP	YFIRFI: KMP	DAGS.: JUNÍ 2002
SAMPYKKT: <i>Valdur Blar Þorsteinn</i>			KT.: 130257-2409
 <b>VERKFRÆÐISTOFA KÓPAVOGS</b> Hamraborg 7 200 Kópavogi Sími: 564-4422 Fax: 564-4433 Netfang: verkfop@arkverk.com		SKJAL: B-05	KVARDI: 1/10
		BLAD NR. B-05	ADALUPPDRAETTIR: <i>Sigrún Guðmundsdóttir</i>