

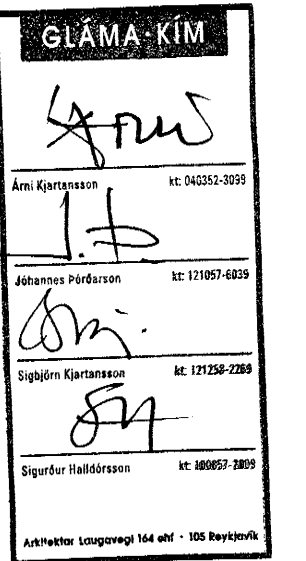


PLATA YFIR 1.HÆÐ, GRUNNMYND. 1:50

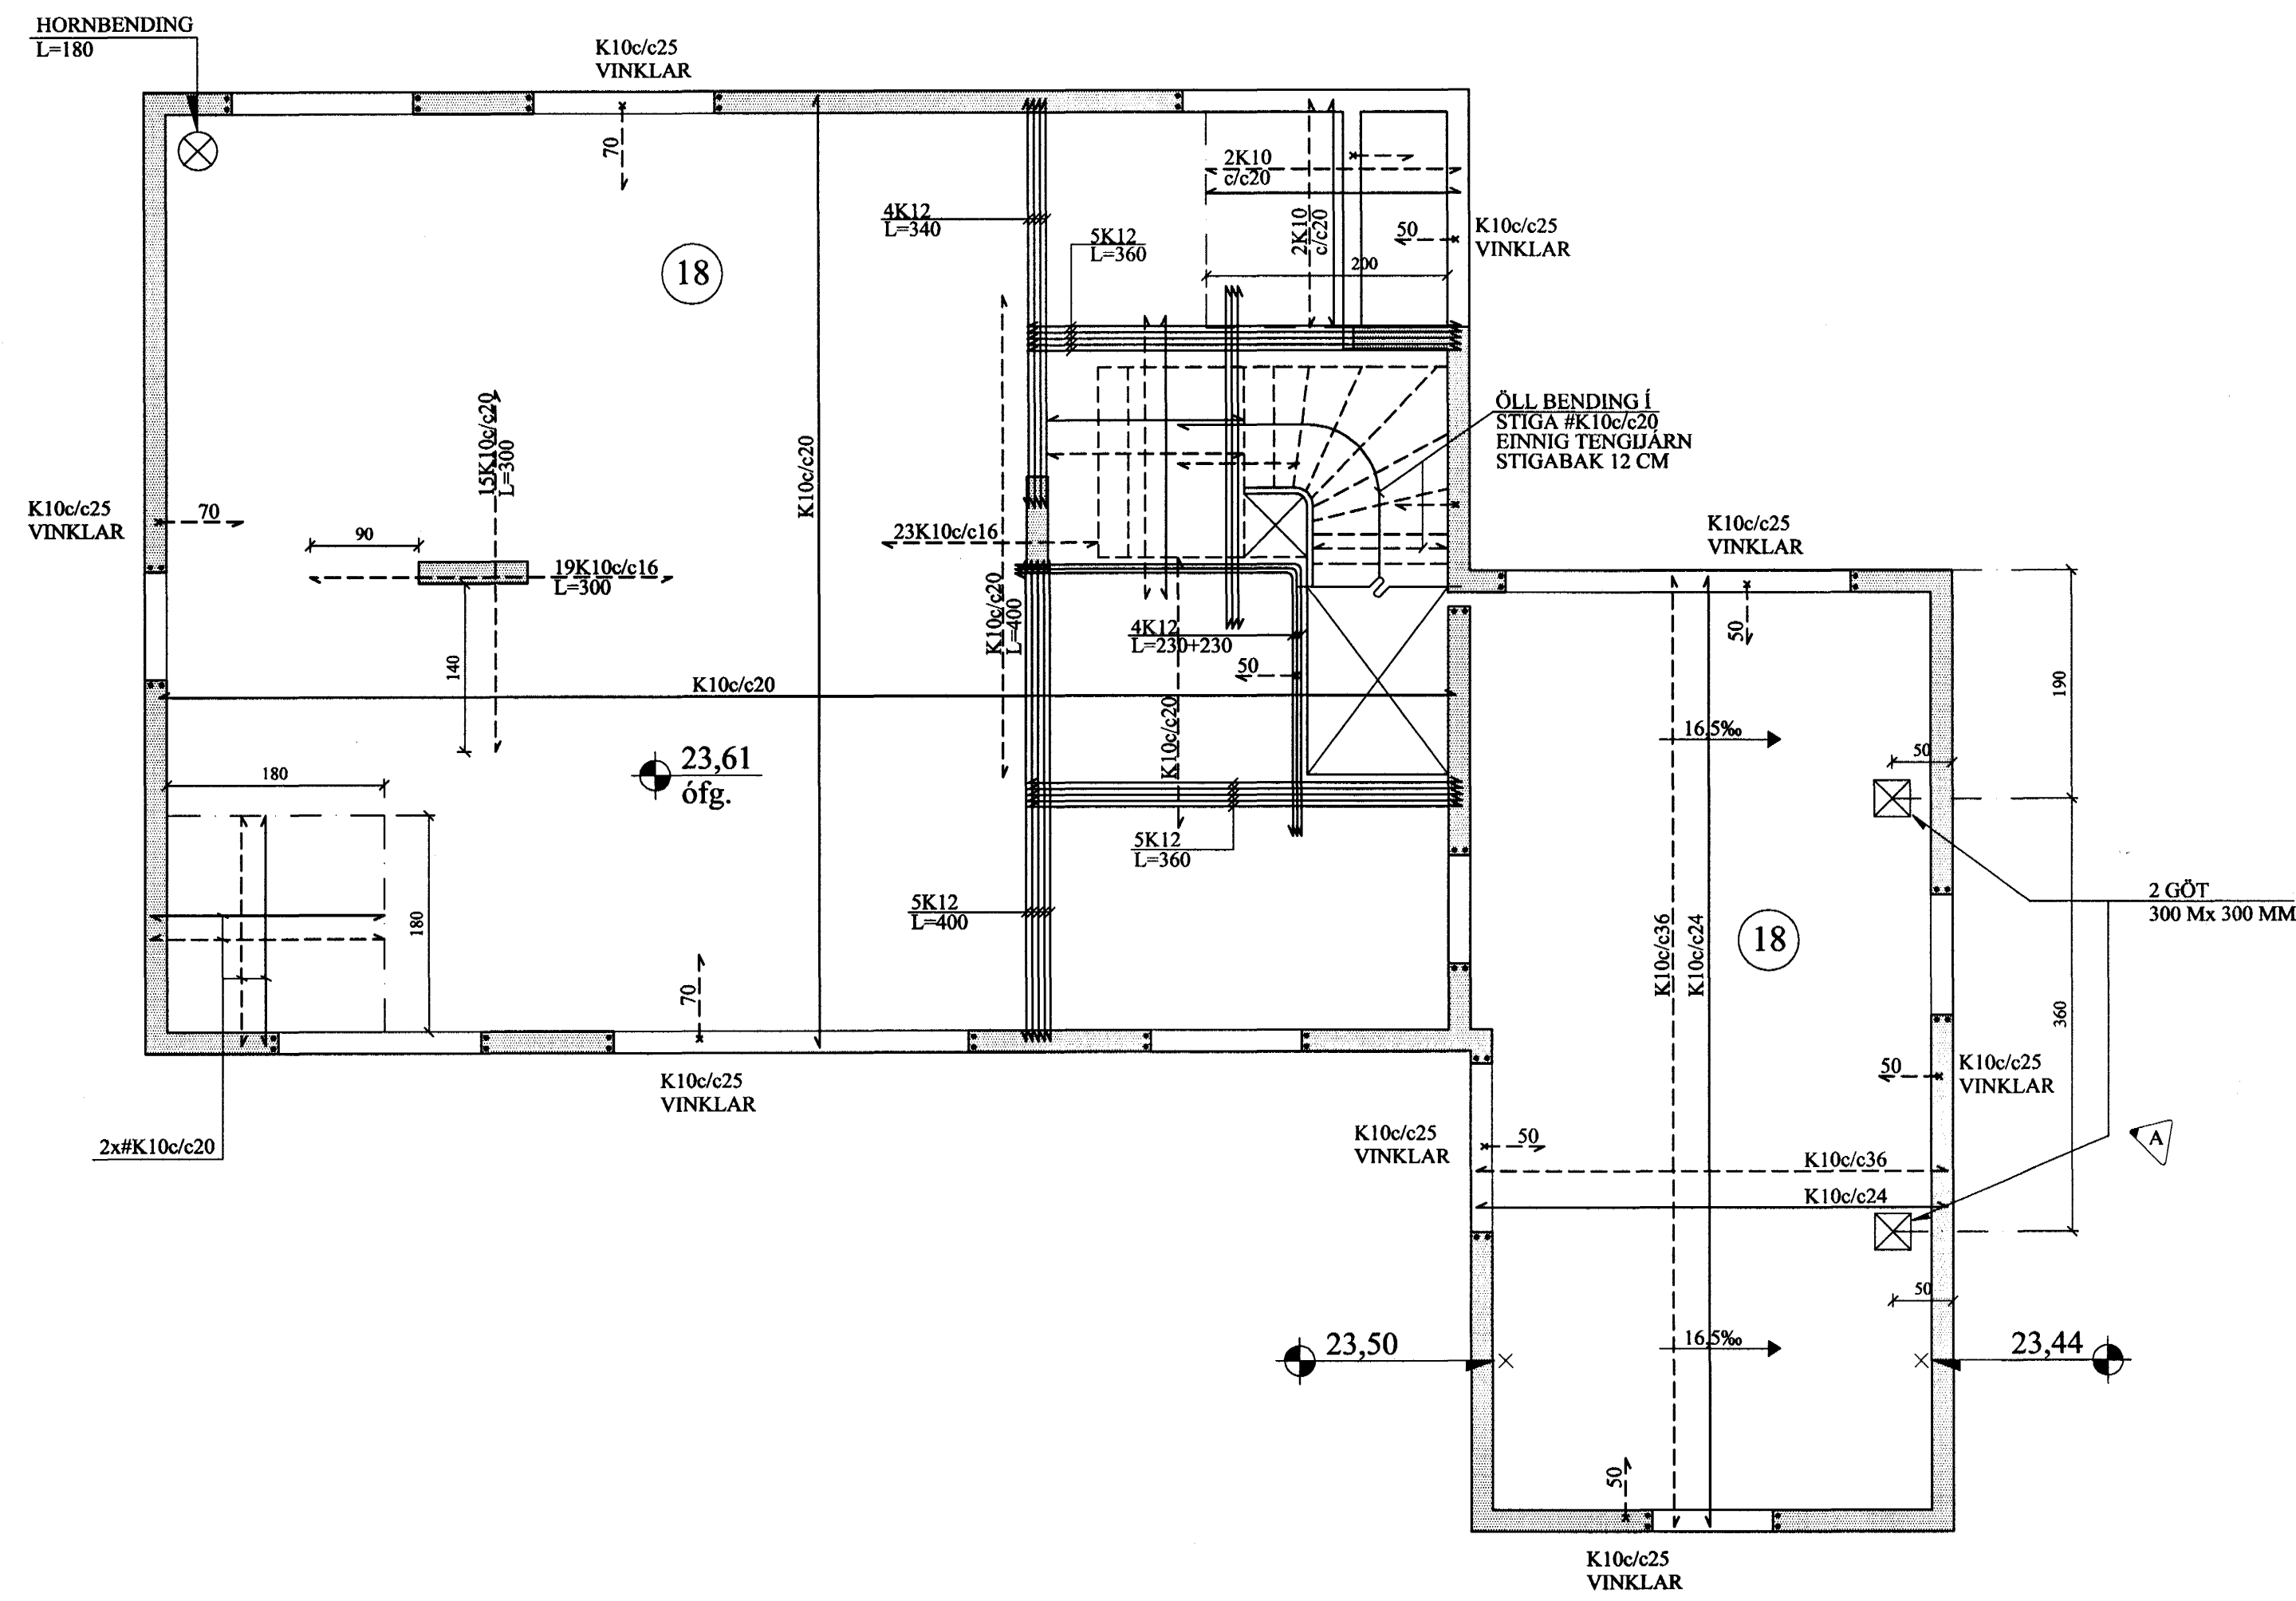

A 03.03.'03 GÖT V/ SN.		Jón Kr.
BREYTINGAR		

TILVÍSANIR:
SKÝRINGAR.....SJÁ TEIKN. NR. 1-01

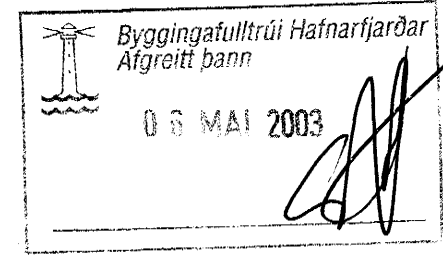

Jón Kr.

Reikn.	Jón Kr.	DES. '02	Útgefð:	07.01.2003
Teikn.	Jóhanna	DES. '02	Kvarði:	1:50
Ath.				1:10
Samþ.				
BLÓMVELLIR 18				Nr. 1-03
Verkluti PLATA YFIR 1. HÆÐ, GRUNNMYND.		Jón Kristjánsson Byggingarverktæðingur PVFI Hvításgata 76 101 Reykjavík Sími: 551-9820 Fax: 863-2154 Kt: 210754-4829 Netfang: jkris@simnet.is http://www.vk.is		