


Gólfefni	
	Vínýlfísar 608x608 mm (sjá verklýsingu)
	Keramíklífsar 200x100 mm (sjá verklýsingu)

(43)02 Gólfefni 3. hæð - skrifstofulma (partur)

ÖLL MÁL OG AÐSTÆTUR SKOGEYST Á STAÐNUM FYRIR SMÍÐ.
Ef ástæma er á milli málsetninga á teikningum og raunstarfum á verkstað skal það síðarmethá standi.

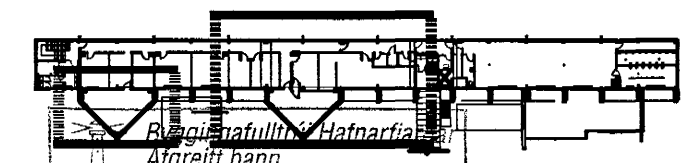

Skýringar:
Explanations:

ARK ÍS ehf
arkitektar ráðgjafar

Adalsteinn Skarvason arkitekt töl 161161-2769
Egill Guðmundsson arkitekt töl 270162-6669
Gísli Gíslason arkitekt töl 160667-4809

Skopavog 16 101 Reykjavík
sími 611 2060
fax 611 2066
netfang ark@ark.is

A Veggþykkt leiðrétt		Dags. Date	Smþ. Approved	Netk. heiml. Released
Breyt. Rev.	Breyting Revision			
Tilv. teikningar nr. ISAL Ref. drawing no. of ISAL		Samsetn. teikningar nr. ISAL Assembly drawing no. of ISAL		

This drawing is the property of the ICELANDIC ALUMINIUM CO. LTD. and handed out for personal use only. It may neither be copied nor made available to others without permission of the ICELANDIC ALUMINIUM CO. LTD. The receiver is liable for any misuse.

Fjöldi stúkkja Number of pieces	Mitur Object	Alnám Material	Enni Weight (kg)	Ísl. / h. / heild Dwg. / v. / total	Athugasemdir Remarks
IV III II I	1 6 APP	ALUMIN			
Stetypuskáli VG styrkingar / stækun					Mellivardi Scale 1: 50
ANNEX Gólfefnayfirlit 3h - skrifstofulma (partur)					Stærð Format of orig. A1
Verktali / Supplier					CCNo.-Ea.type-Eq.No. 6010 BA 1227
ARKIS ehf					Dr. of supp. / Dr. of ISAL / Tekn. ISAL
Teknað Drawn	AS MS JG KE29.11.02	Yfirfarið Checked	AS	Sambýkt Approved	(43)3.02
ALCAN PRIMARY METAL GROUP					166614
Alcan heild 115					A
Teknað Drawn					Notkun heimil Released