

Áritun samræmingarhönnuðar:


A 14.03.'03 UBJ G.G. 176

Lagnir lagðar nær bílajakjallara og oð þéjarkerfi

ÚTGÁFA DAGSETNING TEIKNAD YFIRFARID SAMÞYKKT

EDLI BREYTINGAR

LYKILMYND:

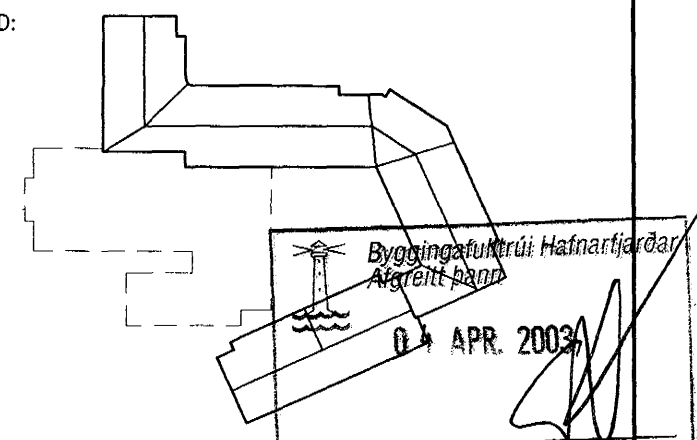

HANNAD: UBJ DAGS: 30.01.'03

TEIKNAD: SI/UBJ KVARDI: 1:200

YFIRF.: GG VERK NR.: 5220

SKRÁ: F-90-01 TEIKN.NR.: F-90-01

SAMP.: 210259-2529

FRUMSTÆRD BLADS A1 - BLADSTÆRD A3, MINNKUN 1:2

BURKNAVELLIR 17, HAFNARFIRÐI

Frérennsliskerfi
Yfirlitsmynd - Grunnlag्नir



BORGARTÓNI 17 - 105 REYKJAVIK NETFANG: fjarhitun@fjarhitun.is
SÍMI 562 8955 - FAX 562 8950 VEFSIDA: www.fjarhitun.is
KENNITALA: 700186-1649

Emp