


CONCRETE: C30/37-38-52

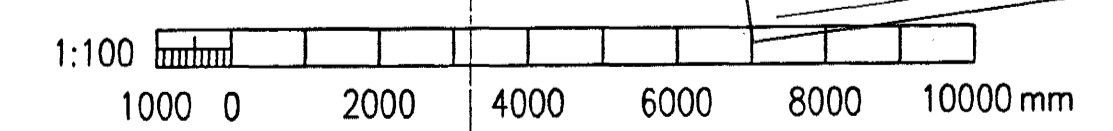

Byggingatútrúi Hatmarfjarðar
Algröftrétt þann
19 FEB. 2002

Níðsháid 81144-294c

REV. NO.	DATE	REVISION	BY	APP.	REV. NO.	DATE	REVISION	BY	APP.	NOTES	REFERENCE DRAWING	DRAWING NUMBER
3	2002.01.09	VEGGJUM BÉTT VÍÐ	HFB	<i>[Signature]</i>								
2	2001.12.10	SKAULLEIFASÖFNUN Í TENGBYINGU 56-57	HFB									
1	1996.08.22	APPROVED FOR CONSTRUCTION	NI									

VST CONSULTING ENGINEERS Ltd. Arnula 4 108 Reykjavík Iceland Tel: +354 569 5000 Fax: +354 569 5010	95.120 - 28.113	
	ICELANDIC ALUMINIUM COMPANY LTD.	DRAWN 96.07.09 SG APPROVED 96.07.09 NI PROCESS 96.07.09 NI PROJECT 96.07.09 NI SCALE 1:100 FORMAT A1
ALUSUISSE ENGINEERING LTD. ZÜRICH SWITZERLAND	79000-35213	3
ICELANDIC ALUMINIUM CO. LTD	188.213	

This drawing is our property and given for personal use only. It may not be copied or made available to others without our permission. The receiver is responsible for any misuse.