


KRAFTSPERRA SP-870-18-V7
1 STK.
MKV: 1:20

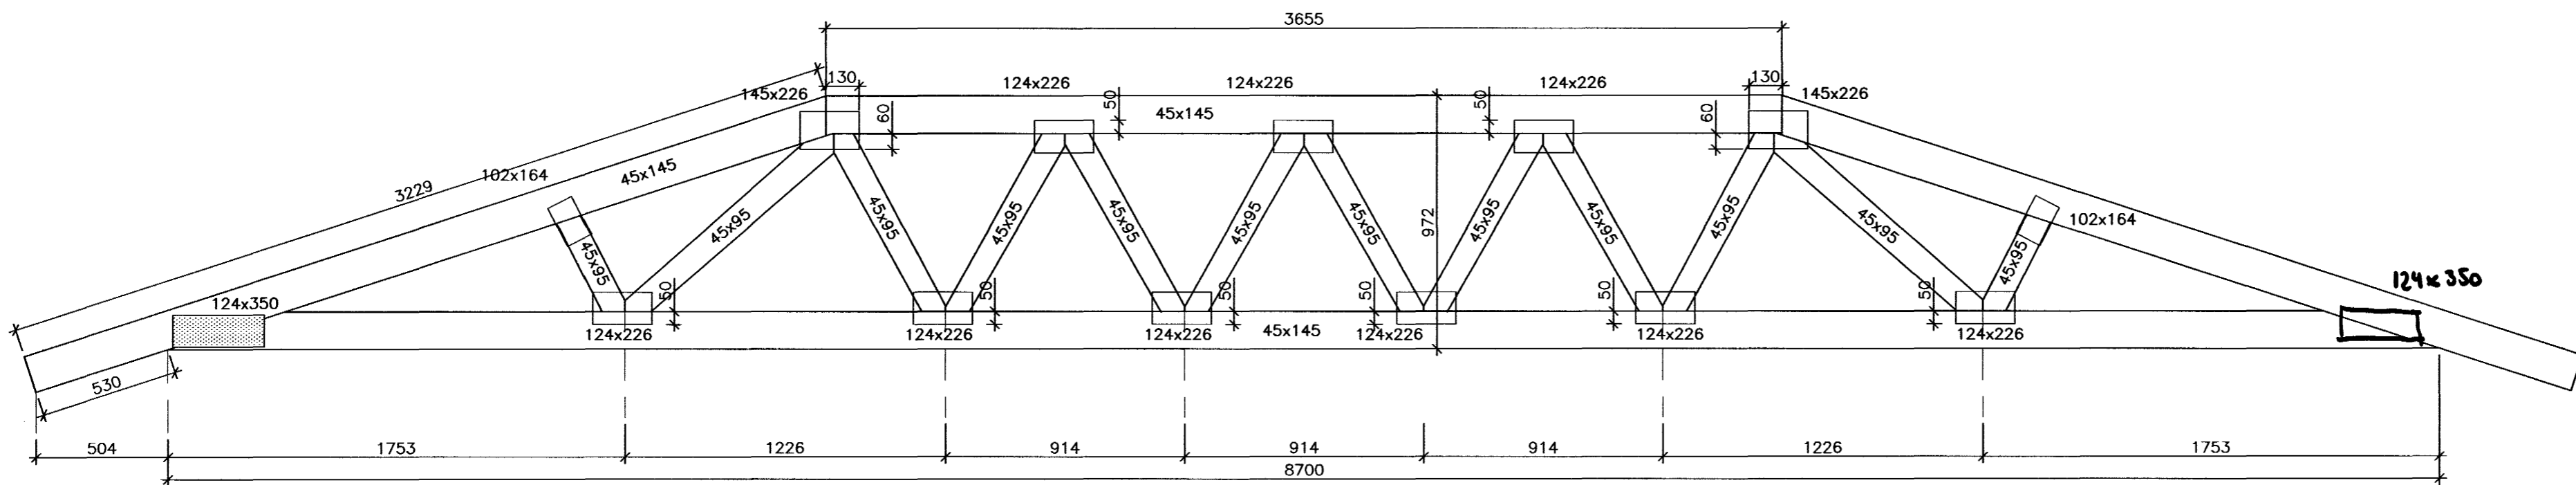

KRAFTSPERRA SP-870-18-V8
1 STK.
MKV: 1:20

Samþykkt þann
11 FEB. 2004
Byggingafulltrúinn í Hafnarfirði
F.h. Sigurbjartur Hallgrímsson

SGHUS			
AUSTURVEI 69 800 SELFOSS SM 482 3650 FAX 482 3651 VEFING: sghus@sghus.is VEFING: www.sghus.is			
FURUVELLIR 20, HAFNARFIRÐI			
BURDARVIRKI:			MKV:
KRAFTSPERRUR			MKV: 1:20
SPERRUKJÁLKAR			MKV: 1:20
HAUÐI:	TEIÐI:	DASETNING:	VERÐI:
T.ELLERT	T.ELLERT	12.01.2004	3134
SKÝRSLA:	SKÝRSLA:	TEIÐING NÚMÉR:	
3134-sp.dwg			216