




GRUNNMYND, 1:50

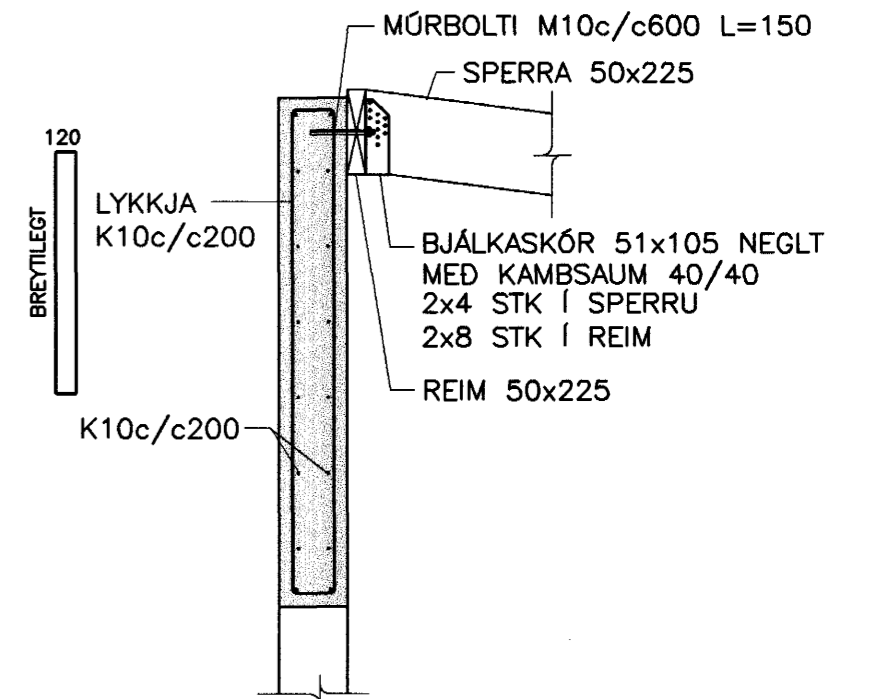

03 SNID YFIR GLUGGA
221 1:20

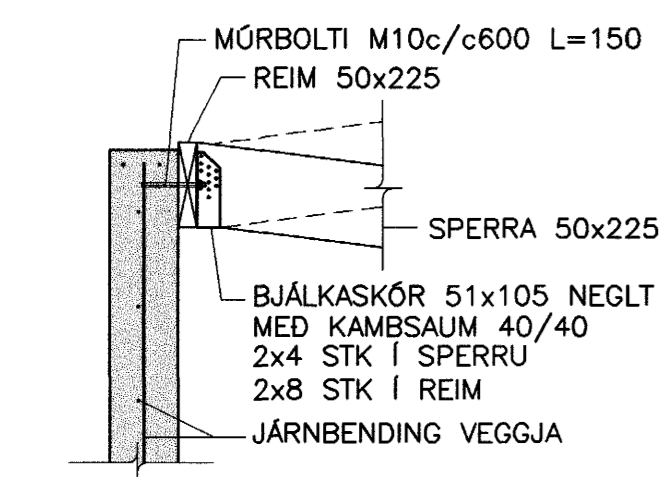

01 SNID
221 1:20


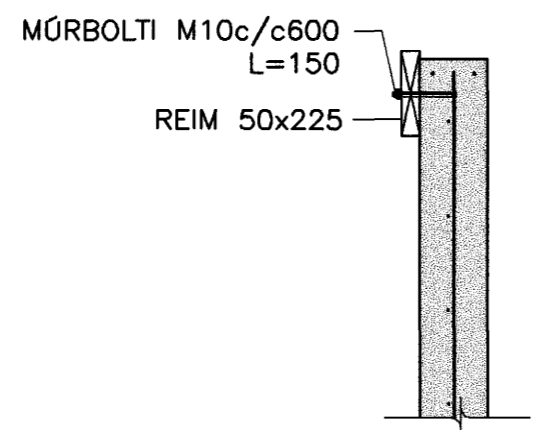


02 SNID
221 1:20

SKÝRINGAR:

Í VEGGI KEMUR EINFÖLD GRIND K10c/c200.
Í KRINGUM GLUGGA OG OP KOMA 2 K12 SEM NÁ
500mm ÚT FYRIR GLUGGA.

SKÝRINGAR SJÁ TEIKN. NR. 222

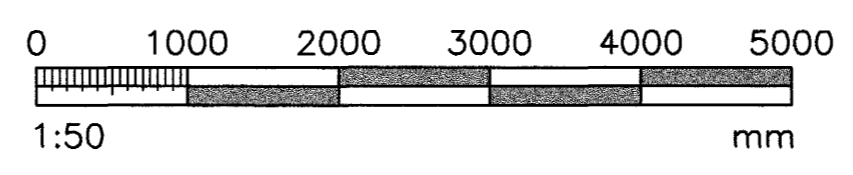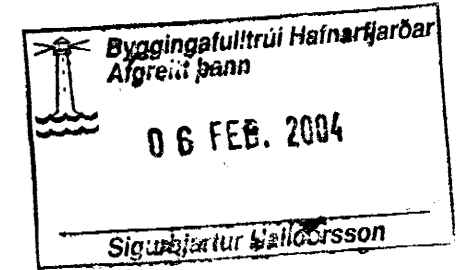

VERKFRÆÐIÞJÓNUSTAN EHF
 GARDATORG 7 · 210 GARDABER · SIMI: 544 8600 · FAX: 544 8601 · GSM: 862 8606, 694 3036 · NETFANG: jorg@vask.is

HEITI VERKS: BLÓMVELLIR 5 HAFNARFIRDI	VERKNUMER: 03.06	DAGS: 27.01.2004
HEITI TEIKNINGAR: BURÐARVIRKI ÞAKS: GRUNNMYND, SNID OG SKÝRINGAR	HÚSAGERNI: STEYPT HÚS	GETUSLÁNR: 221
HANNAÐ: GH	TEIKNAR: RR	MÆLT: YFIRFAR: <i>Jörgen</i>
	SAMPYKKT: Jón Guðmundsson 280255-4329	ÓTGAFAC: B1 MÆLV: 1:20/1:50 TEIKN.NR.: 221