


B1 19.10.2001 - Ýmsar lagfæringar
 B2 19.11.2001 - Mál-lagfæringar

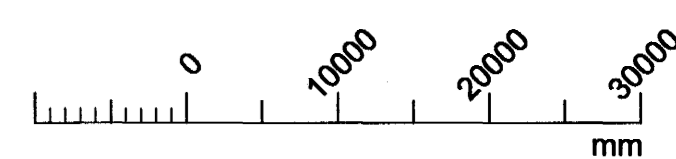

Byggingatvönnir Hafnarfjarðar
 Algjæfitt þann
 27. DES. 2001
 VG

TEIKNISTOFA
 HALLDÓRS
 GUÐMUNDSSONAR
 FAI
 BRÚLÁTUNÍ 8
 105 REYKJAVÍK
 Sími 545 1600
 Fax 545 1616

Halldór Guðmundsson
 Kennitala ábyrgðaraðila: 140545-2439

HRAFNISTA - HAFNARFIRDI
 FJÖLBÝLIHÚS V. GARDAVEG

HÚS 1
 GRUNNMYND KJALLARA

MÁL 1:50
 DABB 19.09.2001
 BR. B2 19.11.2001
 20-01
 ATH. TEIKN. NO