


B1 19.10.2001 - Ýmsar lagfæringar
 B2 19.11.2001 - Ýmsar lagfæringar

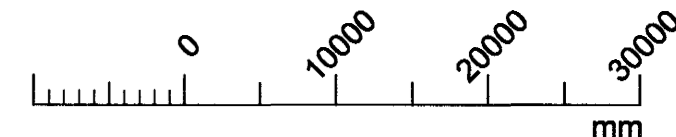

TEIKNISTOFA
 HALLDÓRS
 SUBMUNDBONAR
 FAI

SKÚLATÓNI
 105 REYKJAVÍK
 Sími 548 1800
 FAX 548 1816

Handwritten signature
 Kennitala Byggingaráða: 140548-2438

HRAFNISTA - HAFNARFIRÐI
 FJÖLBÝLISHÚS VIGARDAVEG

Byggingaáhrifur Heimárinu
 Klippirill þann
 27. DES. 2001
 VG

HÚS 1
 GRUNNMÝND 3.HÆÐ

MÁL 1:50
 DÁÐS 19.09.2001 20-33

B2 19.11.2001