




A 30-03 GLUGGI G8 2 stk.
MKV.1:20

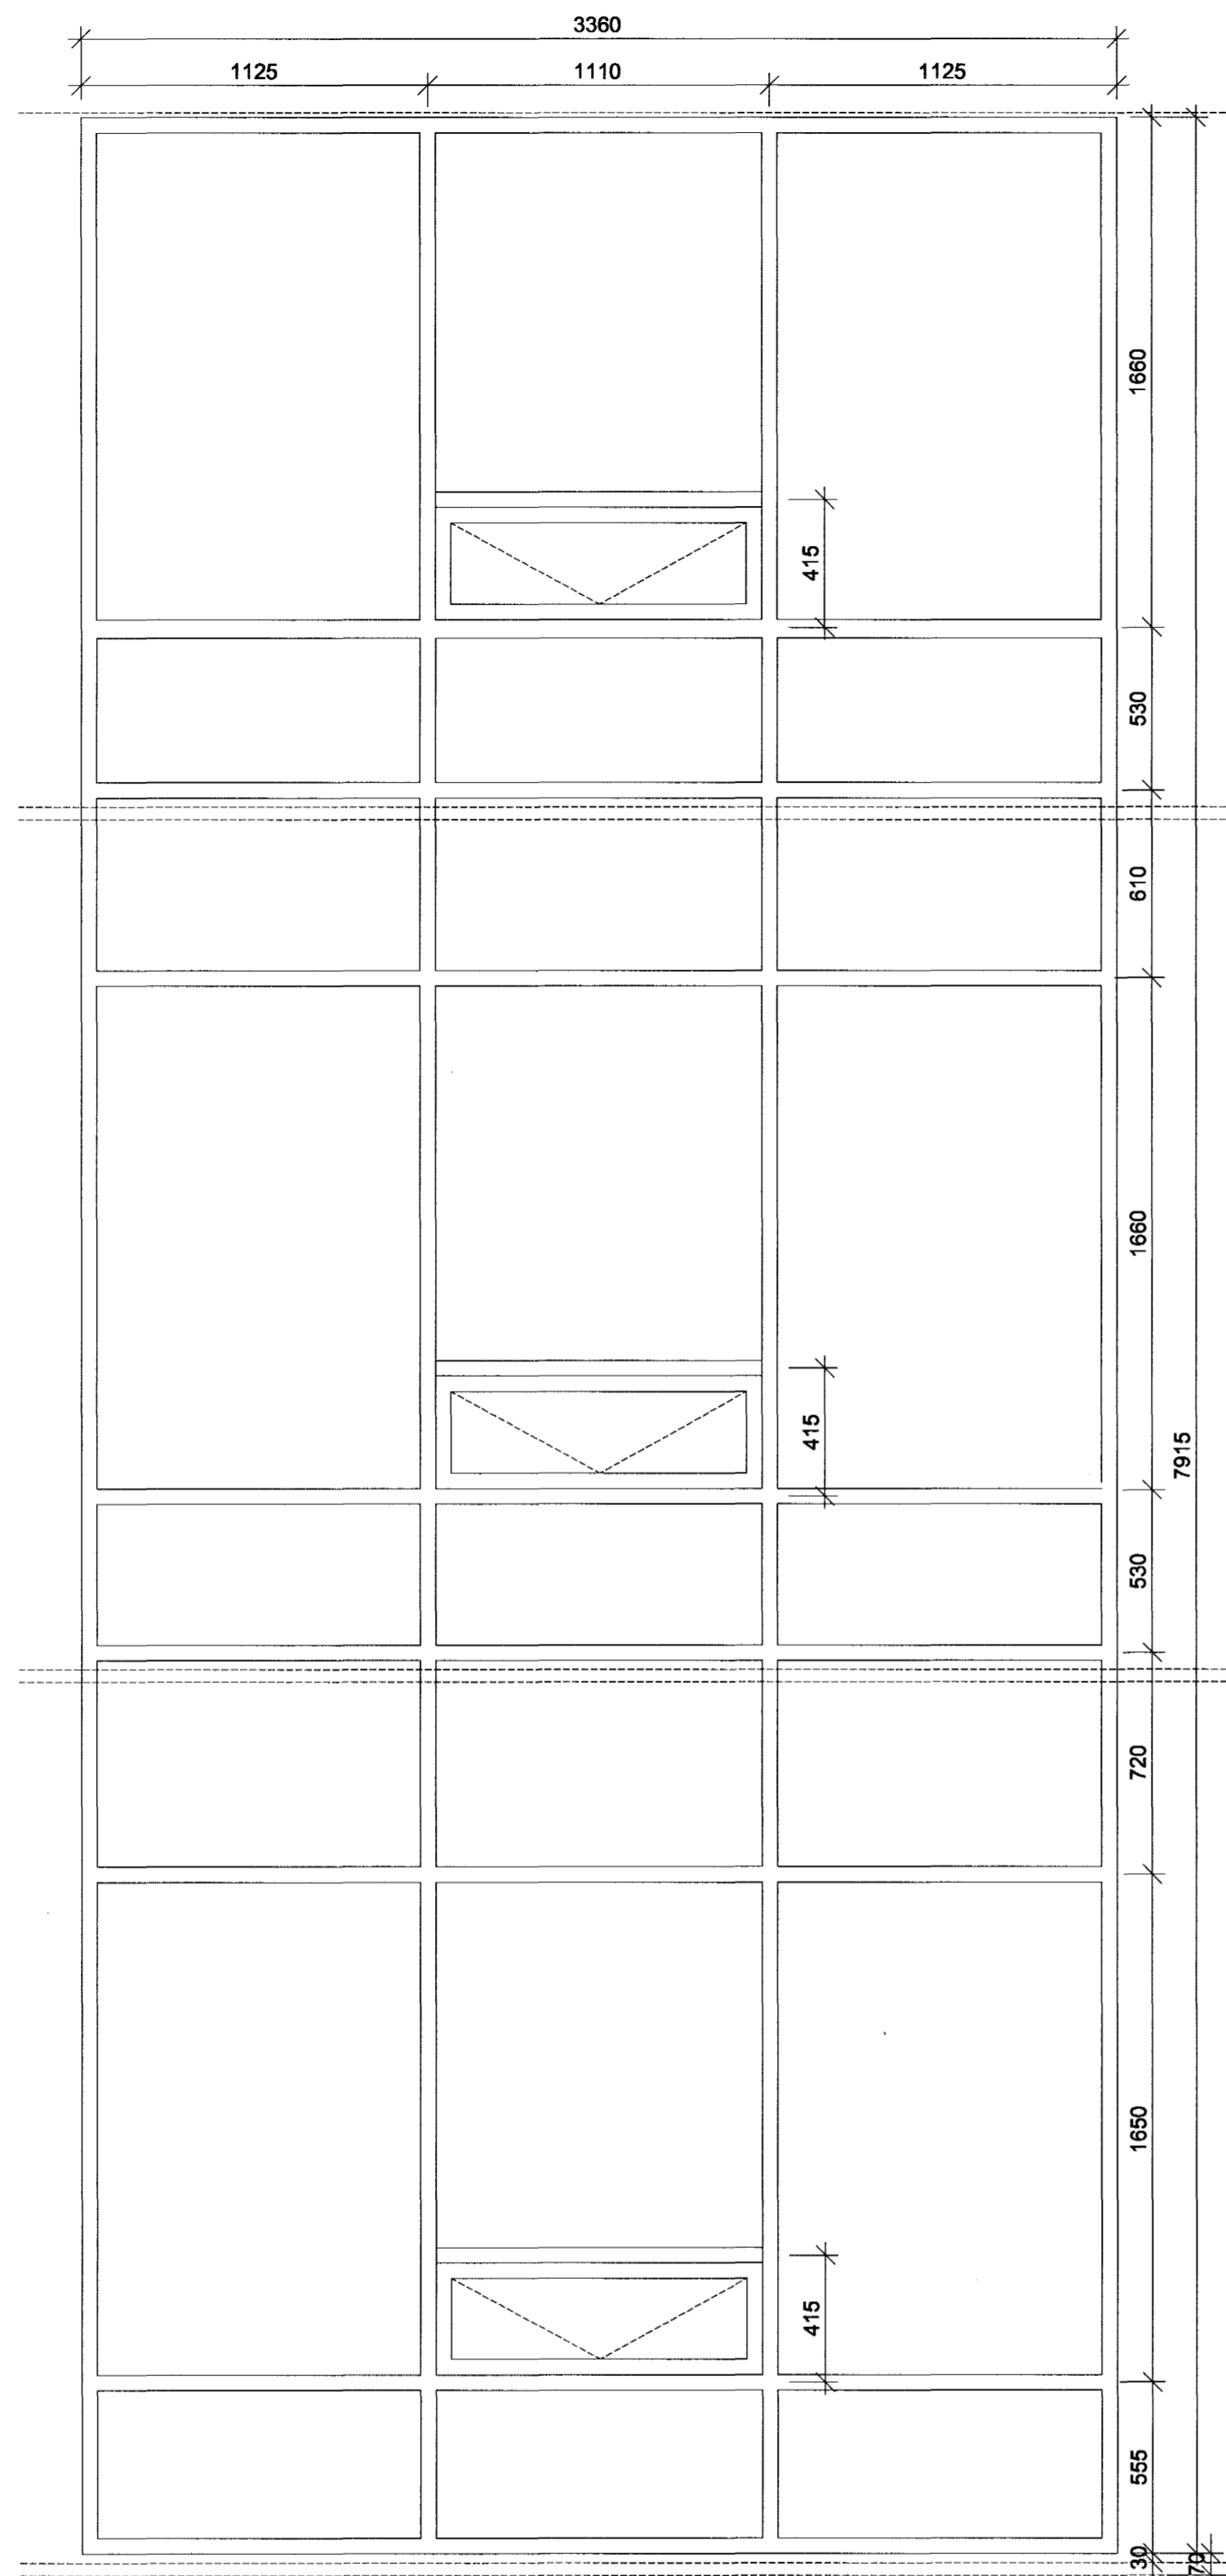


B 30-03 GLUGGI G12 2 stk.
MKV.1:20

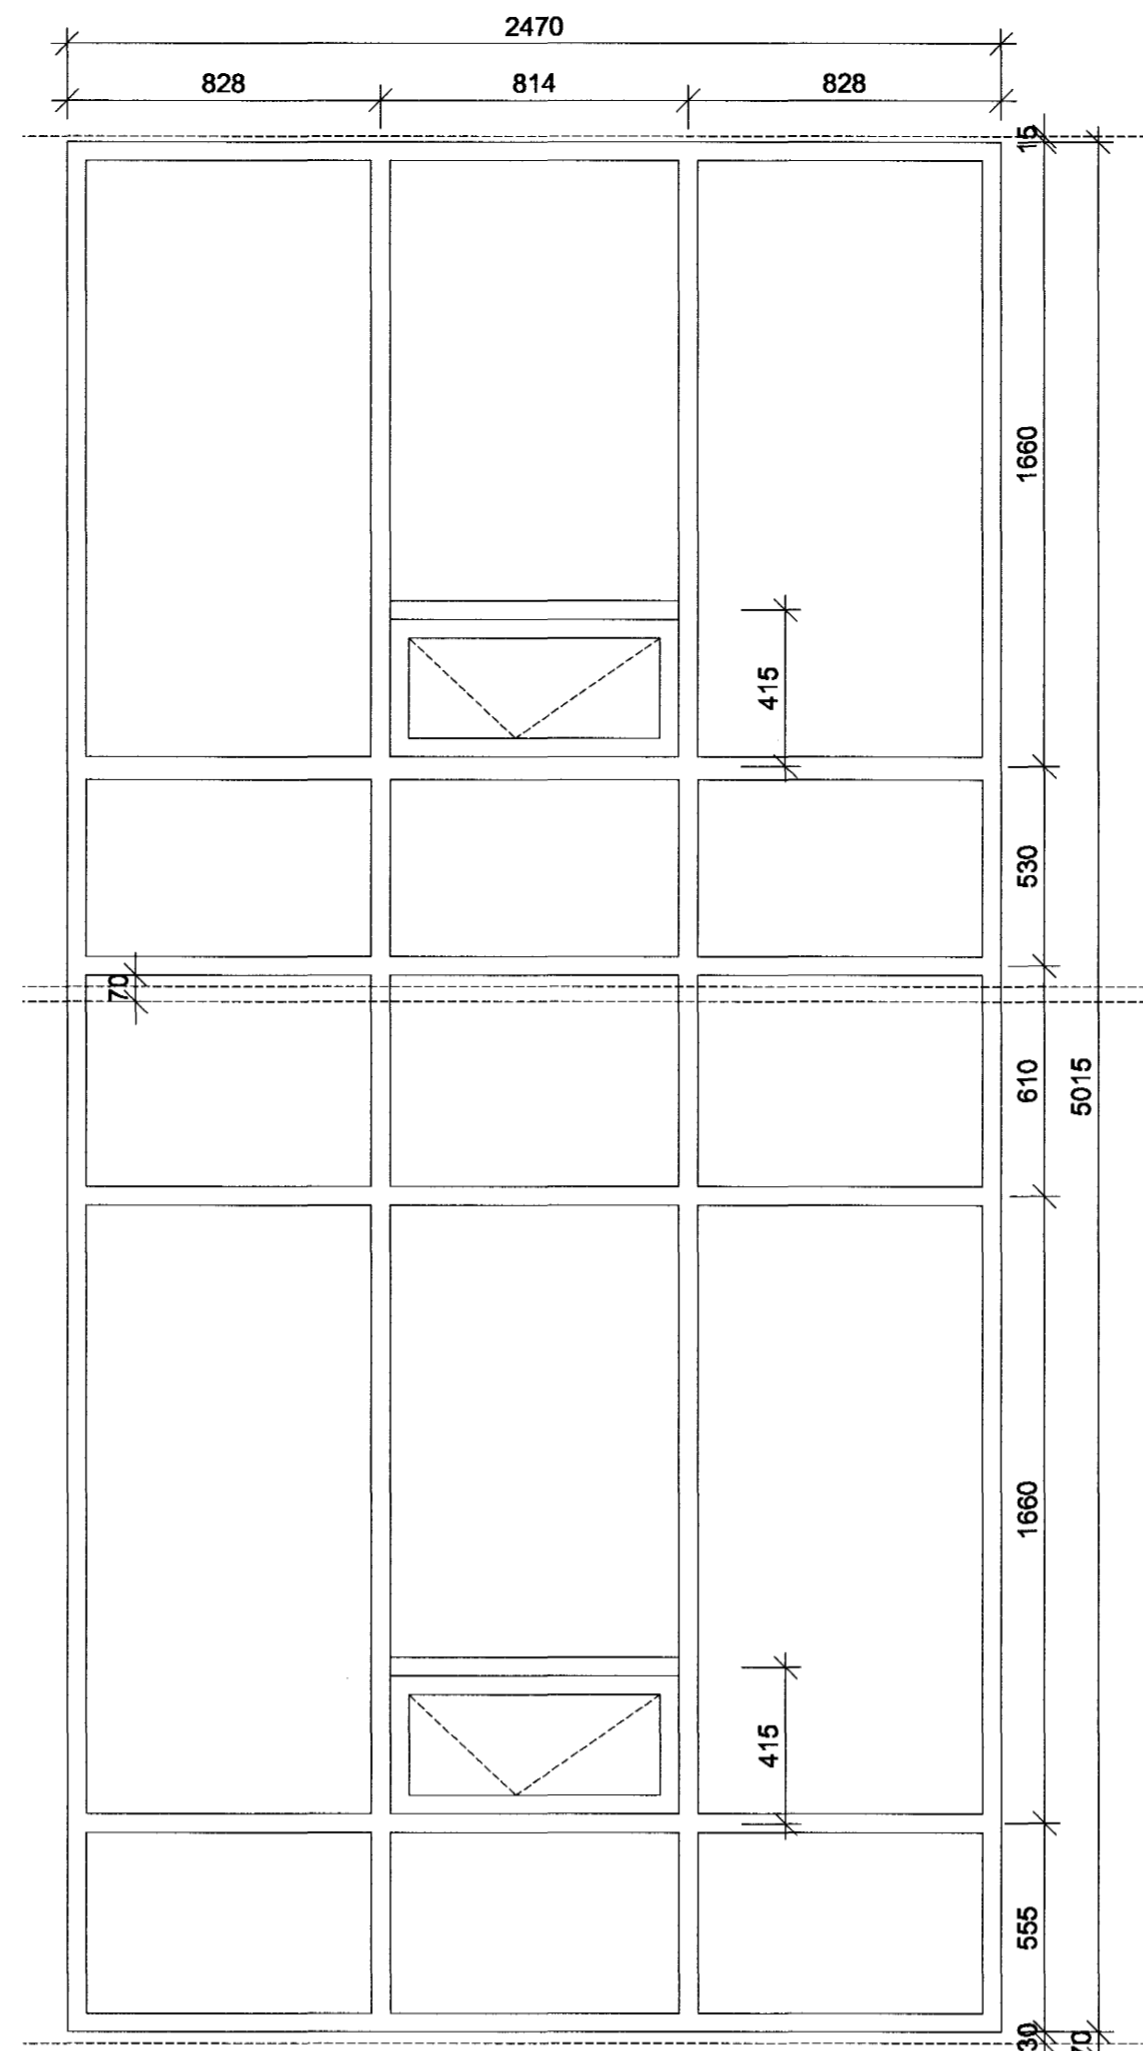

D 30-03 GLUGGI G17 2 stk.
MKV.1:20

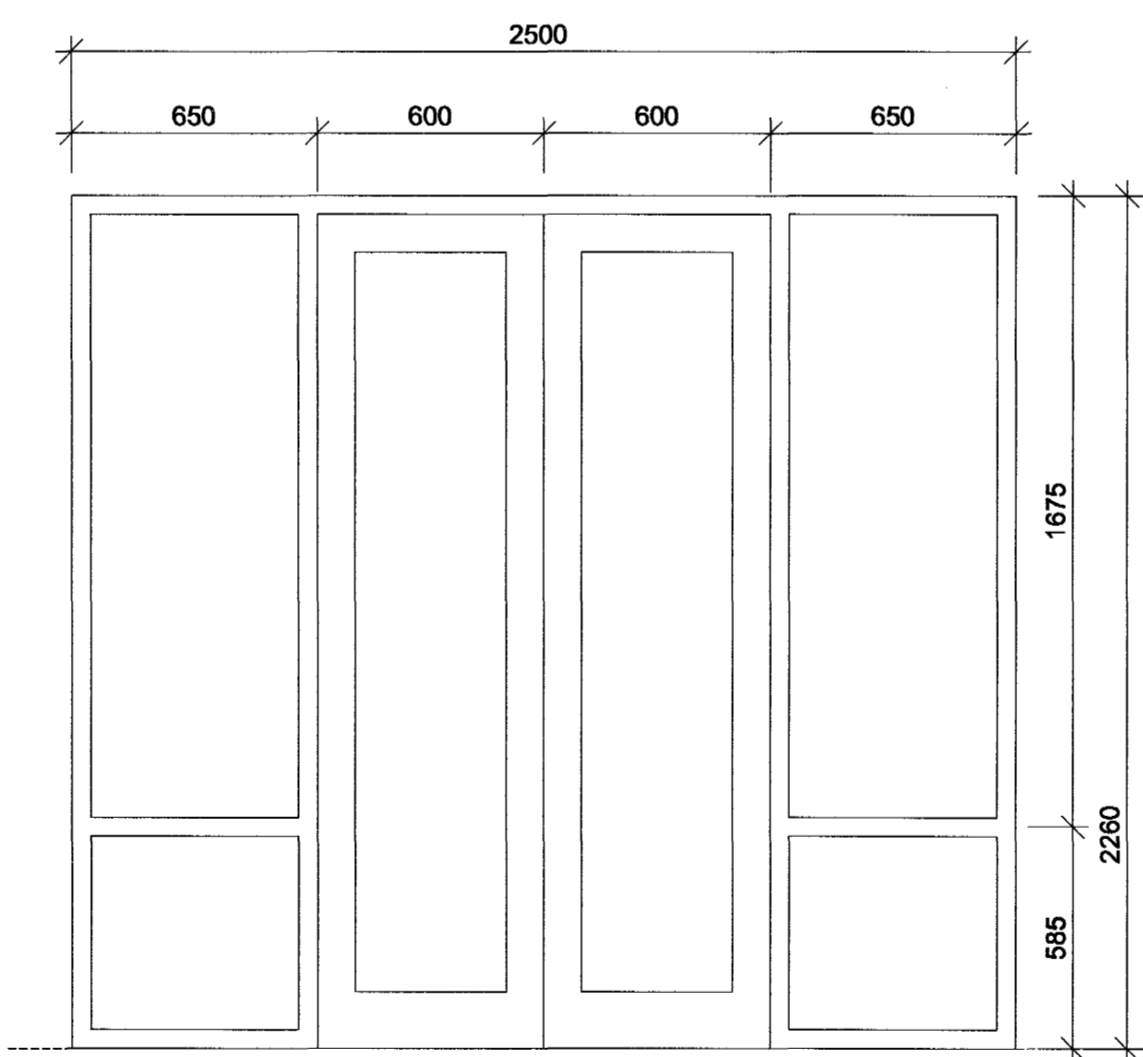

E 30-03 GLUGGI G18 2 stk.
MKV.1:20

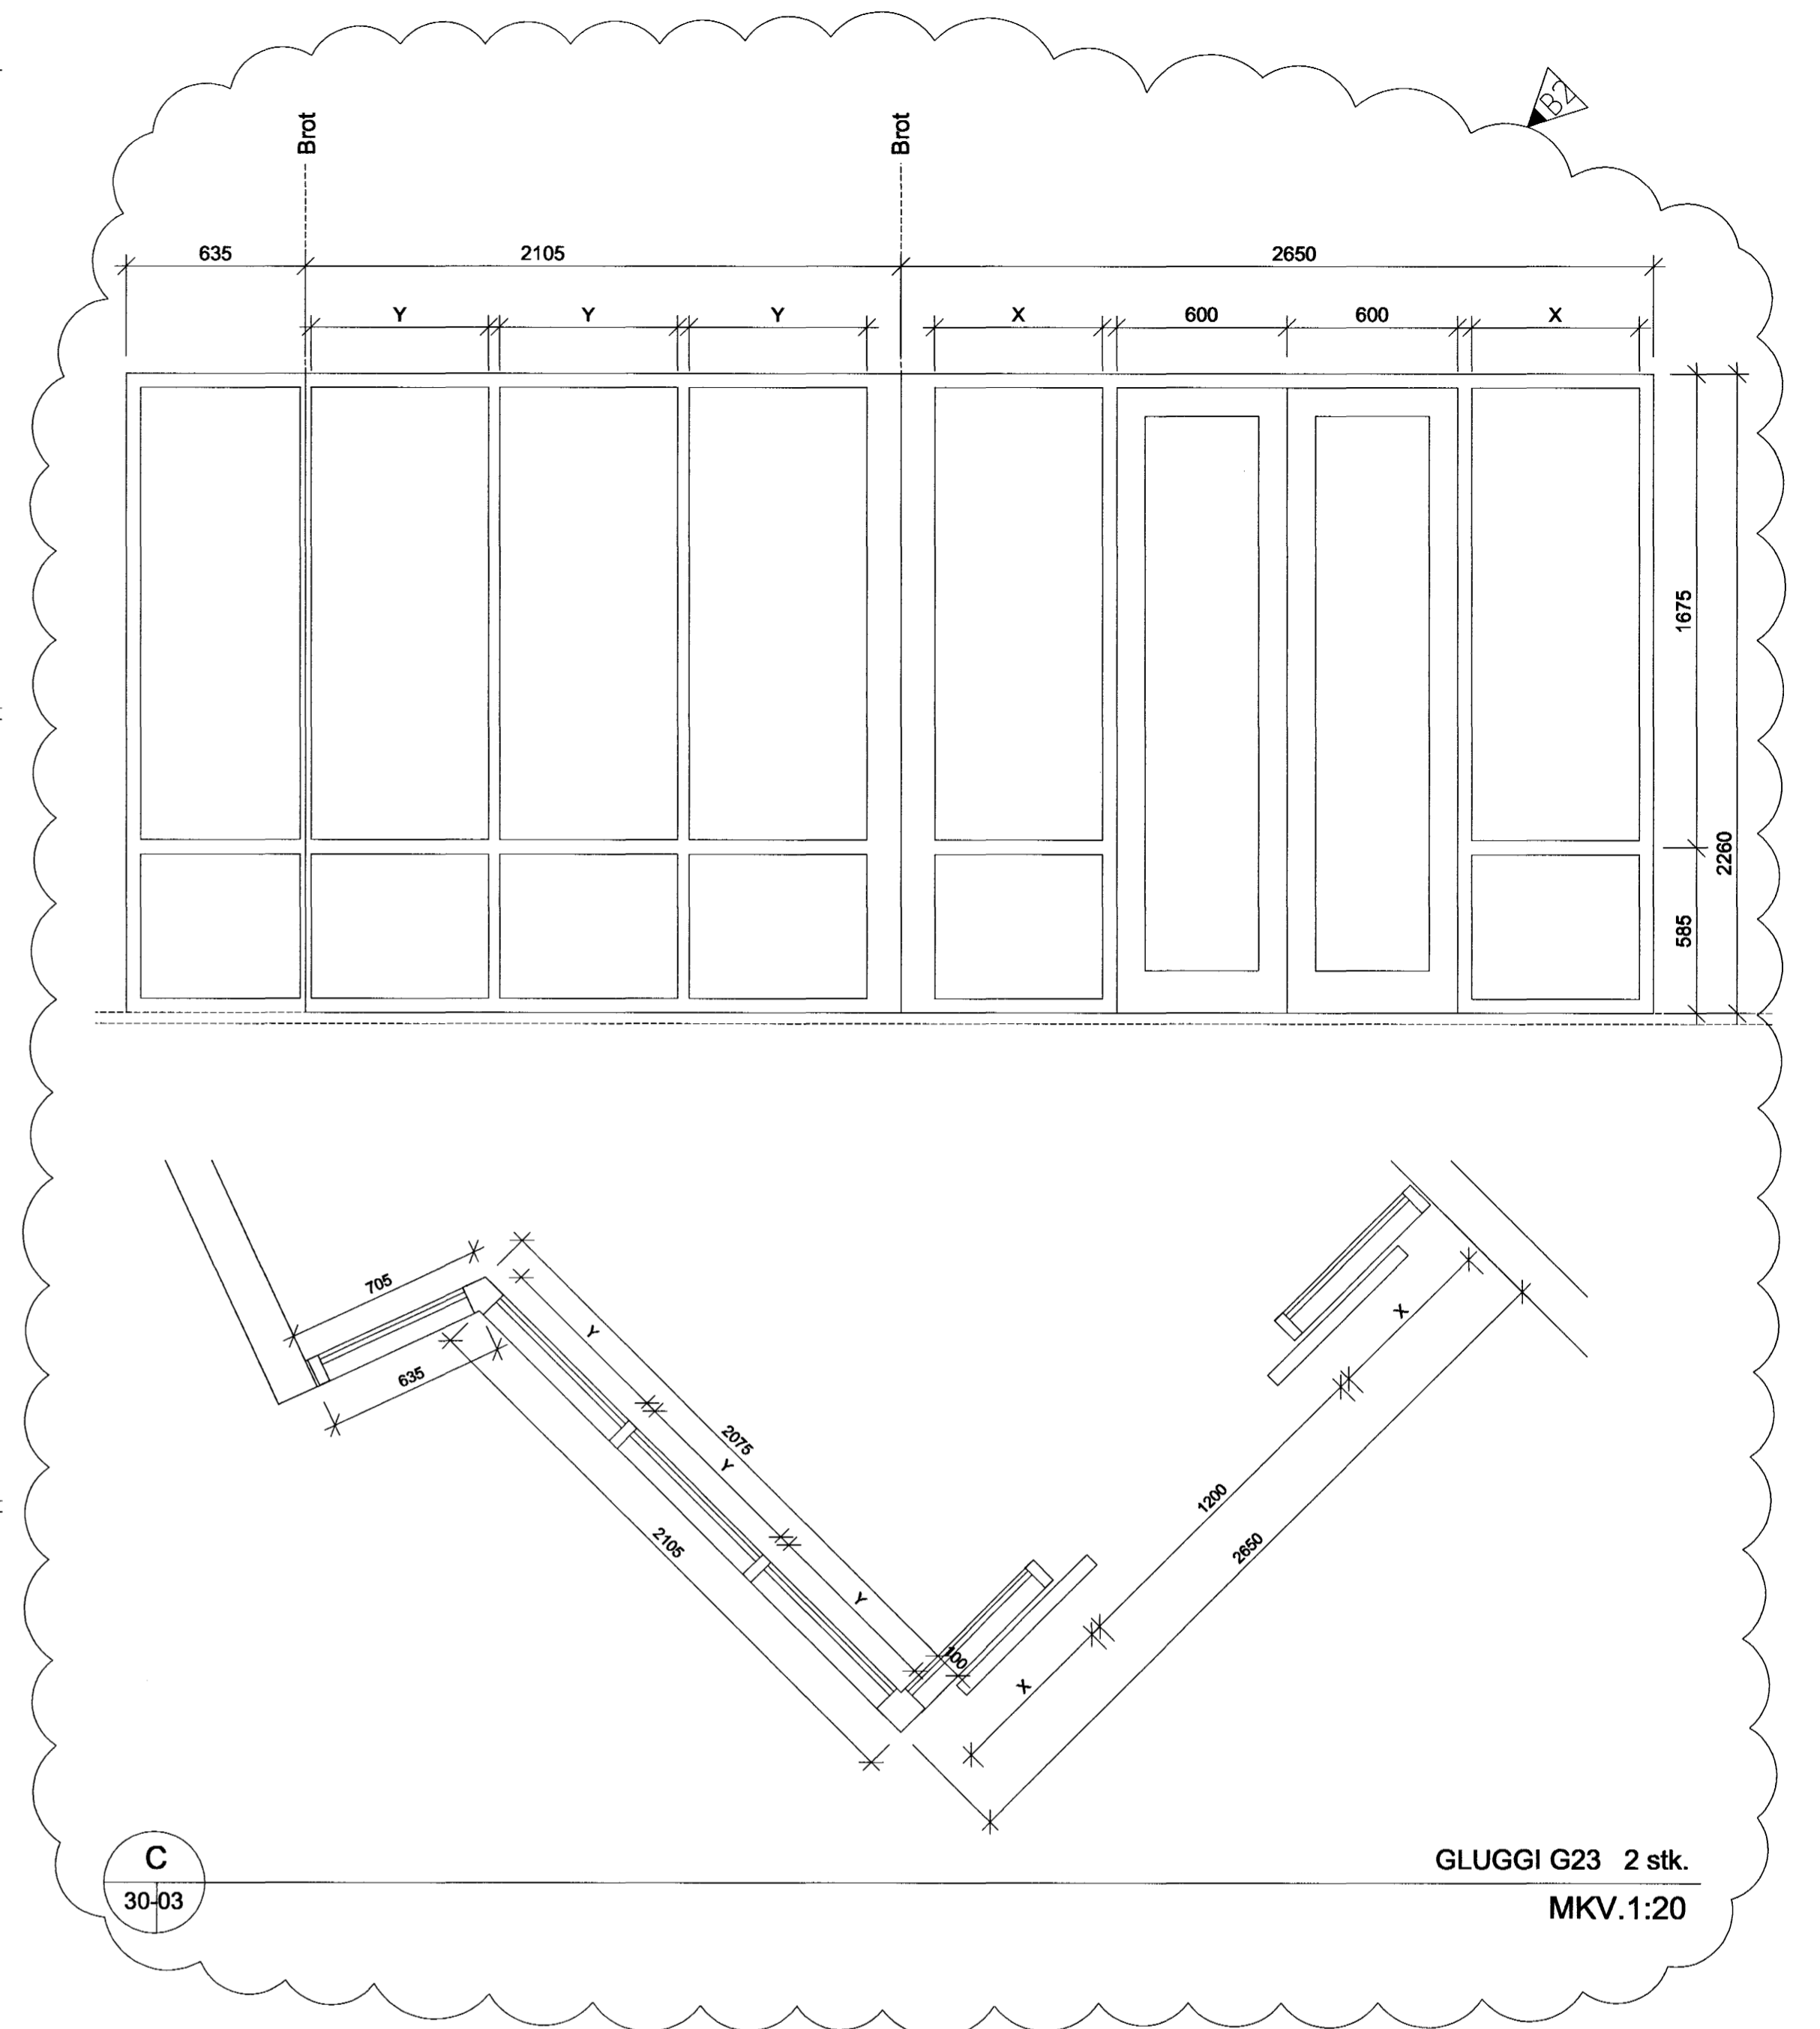

C 30-03 GLUGGI G23 2 stk.
MKV.1:20



B1 19.11.2001. Lagfæring pósta og mála,
G23 bætt við G6 fluttur á 30-04

TEIKNISTOFA
HALLDÓRS
GUDMUNDSSONAR
FAI

SKÚTUVOGI 106
104 REYKJAVÍK
SÍMI 588 4995
FAX 588 7595

Hallgrímur
Kannitala & byggingaröðla : 140548-2439

HRAFNISTA HAFNARFIRDI
FJÖLBÝLISHÚS V/GARDAVEG

LYKILMYND GLUGGA

MÁL 1:20
DAGB. 19.09.2001 30-03
BRL 19.11.2001 ATHL. TEIKN. Vn. Jb

Bygginguflutturú Hainarfjarðar
Afgreitt þann
27 DES. 2001
VG