



A  
78-01 ÁSÝND VEGGJAR Í ANDDYRI A-A 1:20

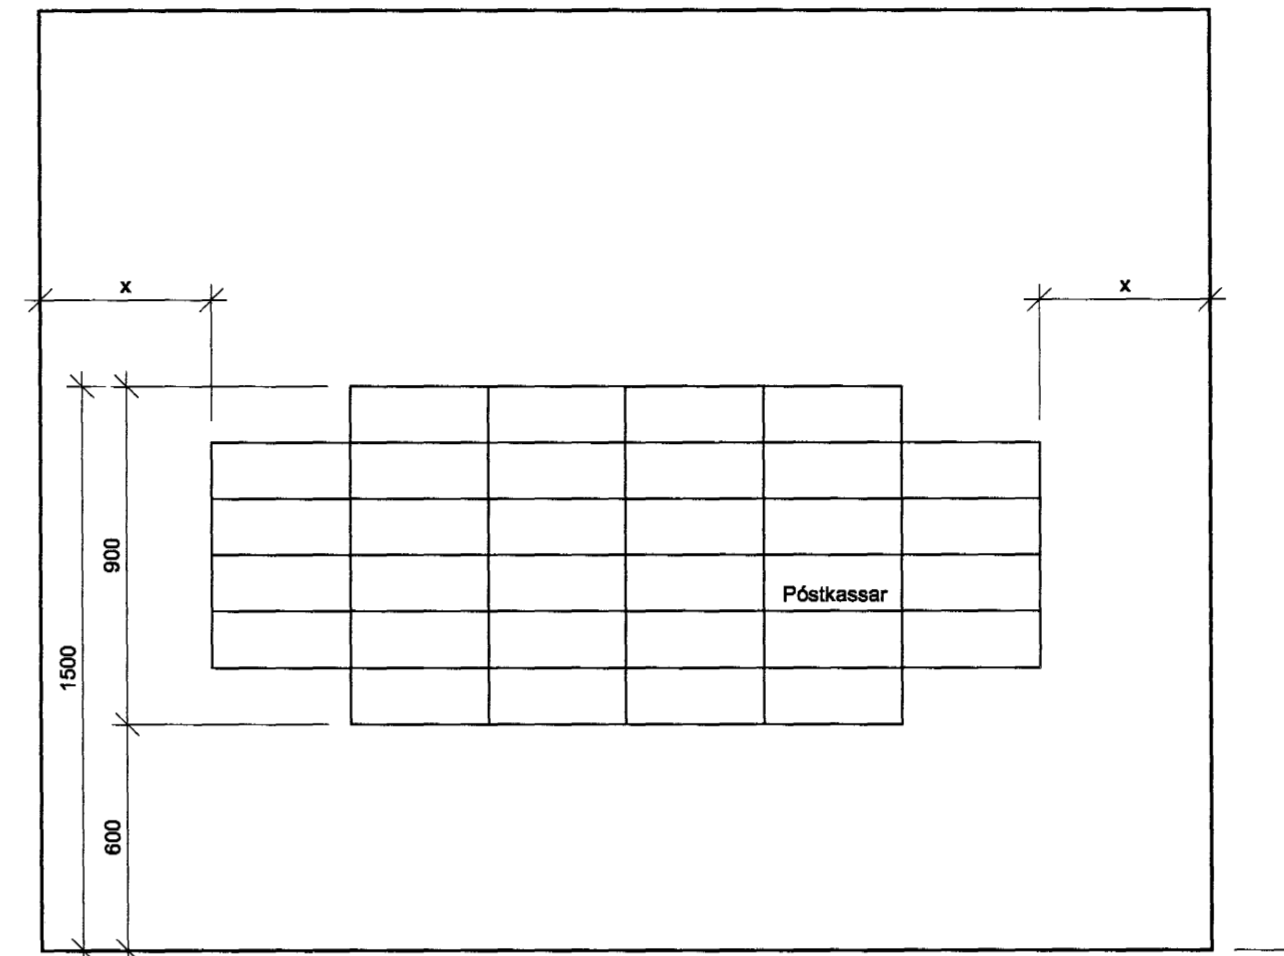

B  
78-01 ÁSÝND VEGGJAR Í ANDDYRI B-B 1:20

HÚS 1


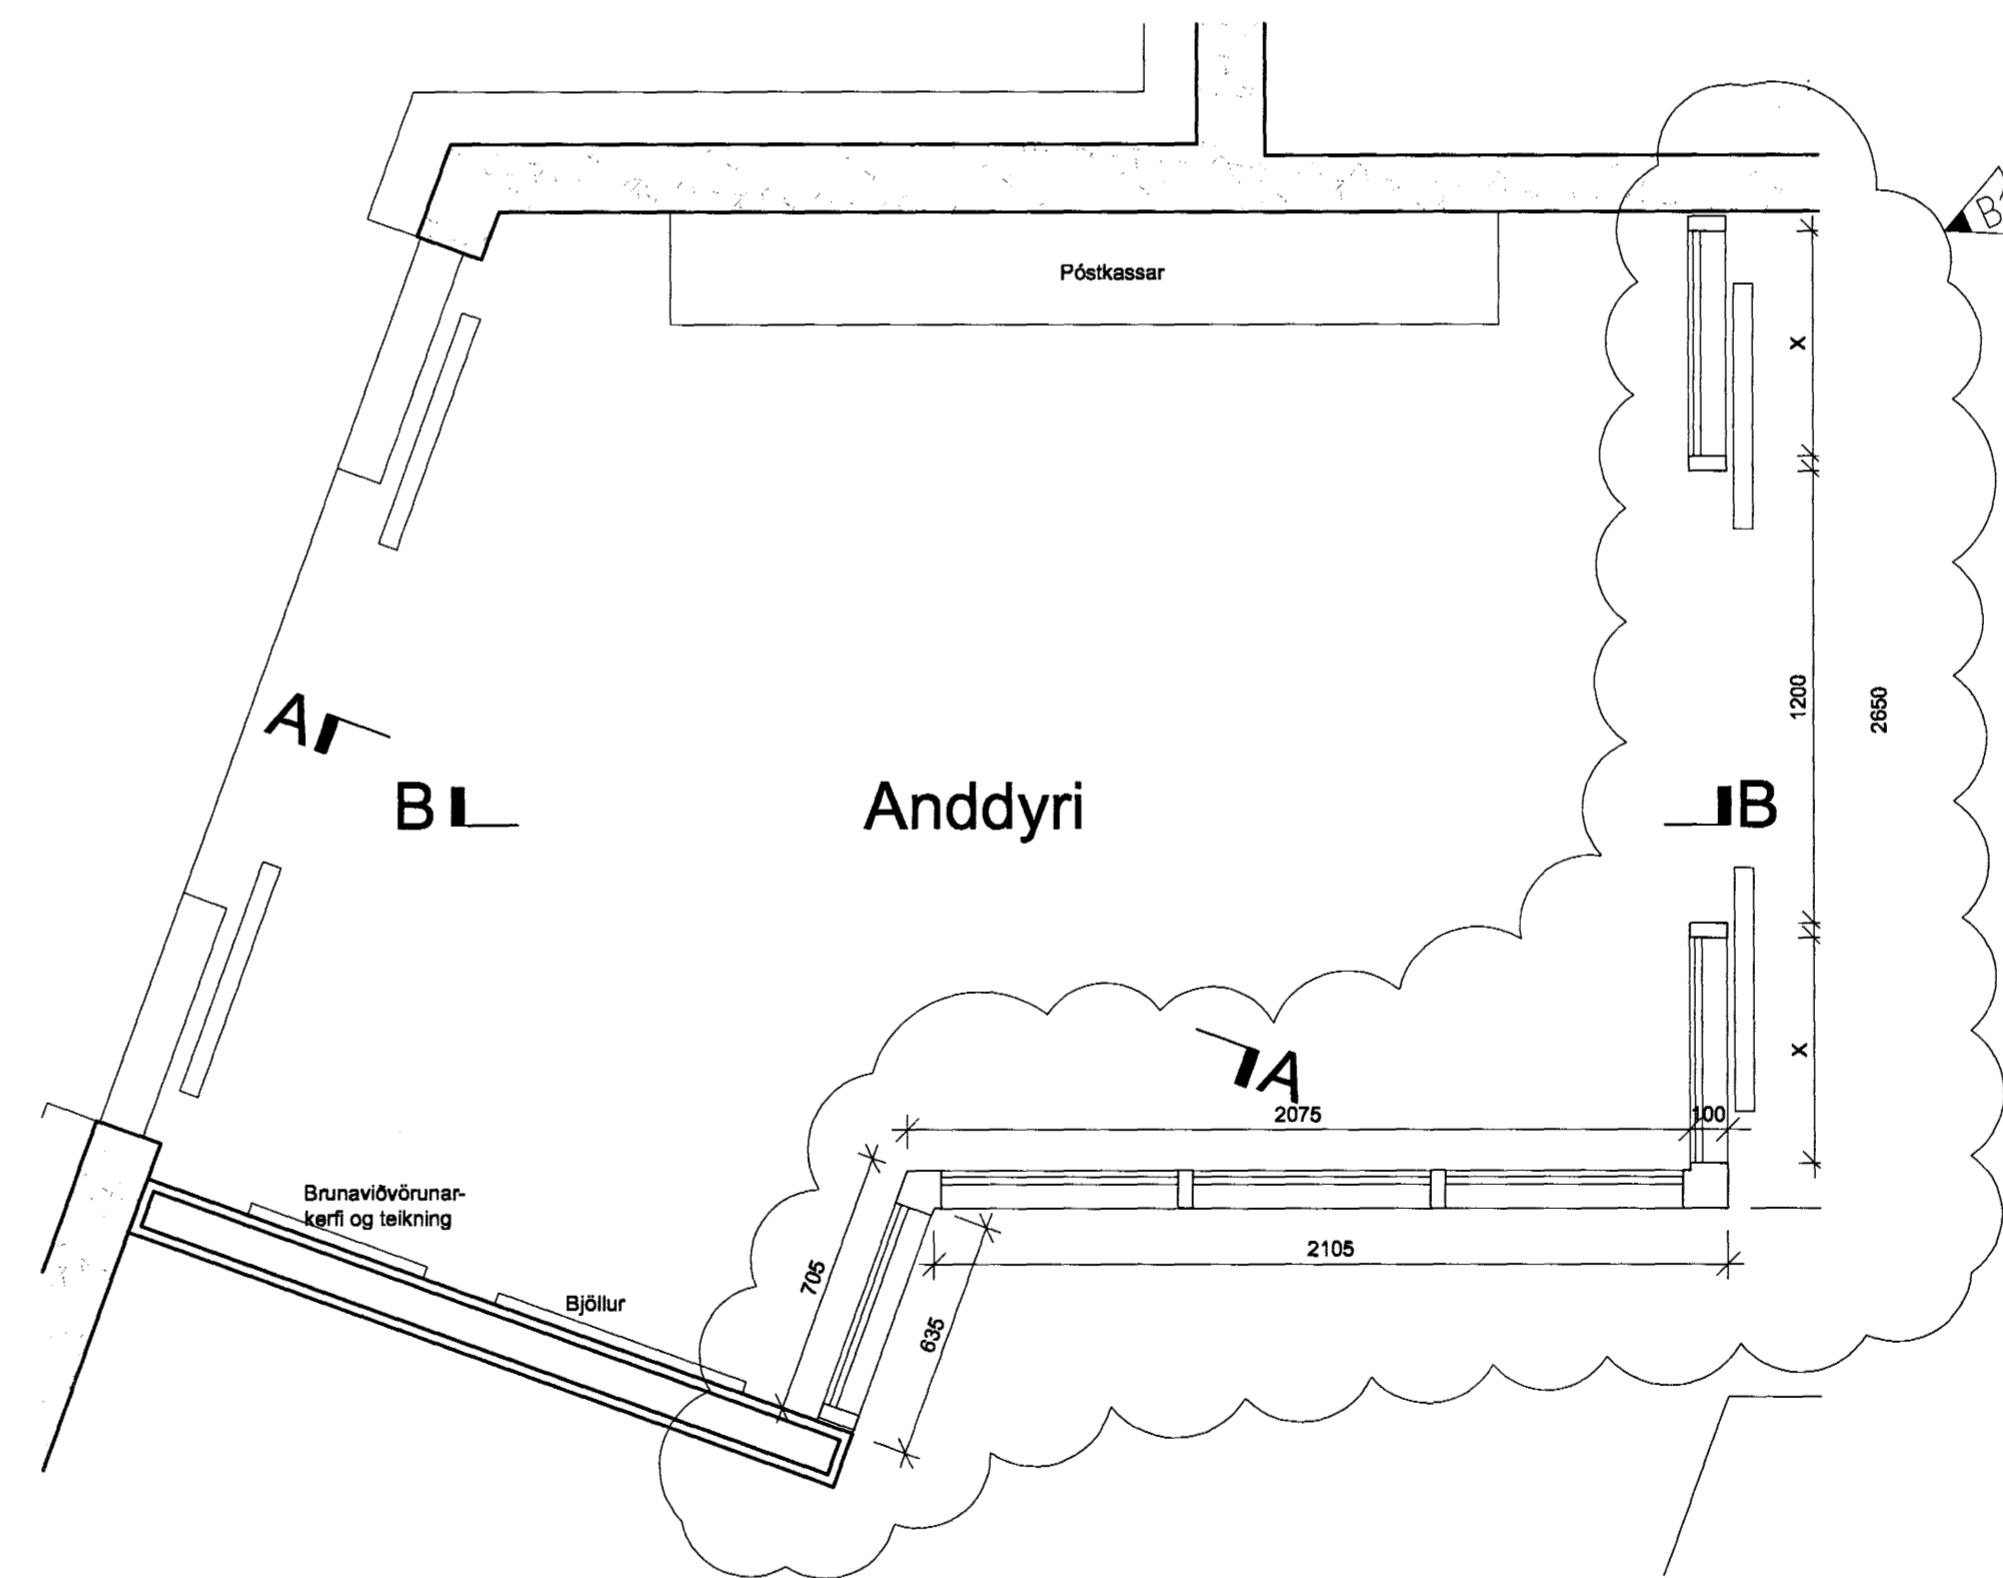

78-01 GRUNNMYND ANDDYRIS 1:20

Bygginguáttíðni Halmartjénar  
Afgreitt fyrir  
27. DES. 2001  
VG

TEIKNISTOFA  
HALDÓRS  
GUÐMUNDSSONAR  
FAI  
REGLATÓNI 6  
105 REKJAVÍK  
SÍMI 548 1400  
FAX 548 1618

Kennitala í byggingaáttíðni: 700994-2449

HRAFNISTA - HAFNARFIRÐI  
FJÖLBÝLISHÚS V / GARÐAVEG

HÚS 1 OG 2  
VEGGMYNDIR ANDDYRI

MÁL 1:20  
DAGUR 19.09.2001 78-01  
BR. B1 19.11.2001

19.11.2001. glerveggur lagfærður,  
brunakerfi lækkað niður