






SNID A
1:20 P21

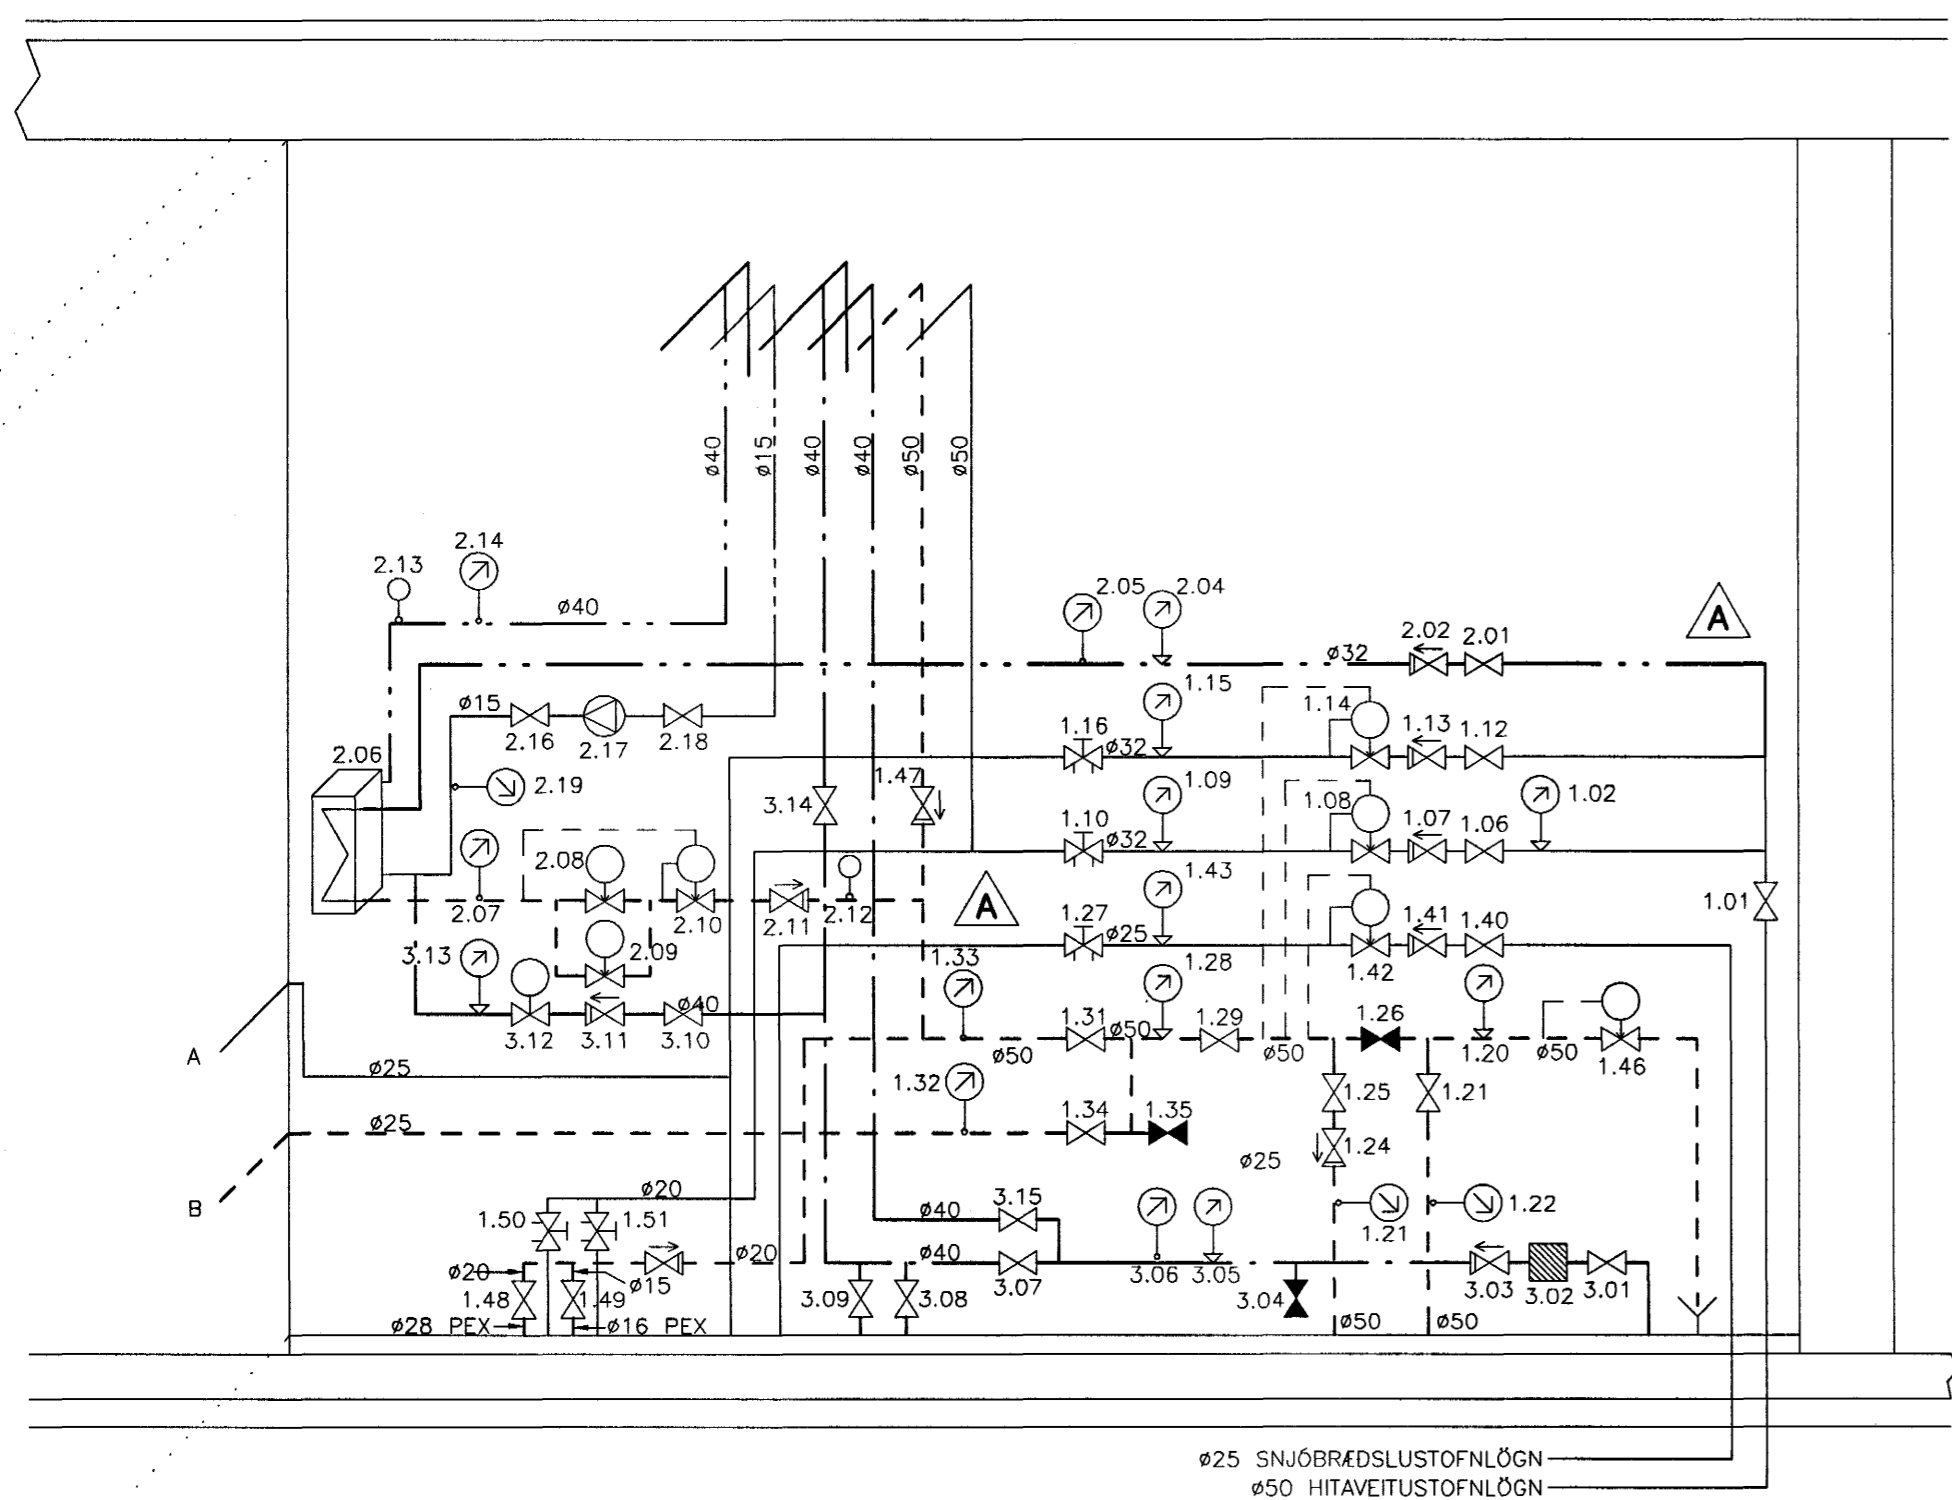

SNID C
1:20 P23

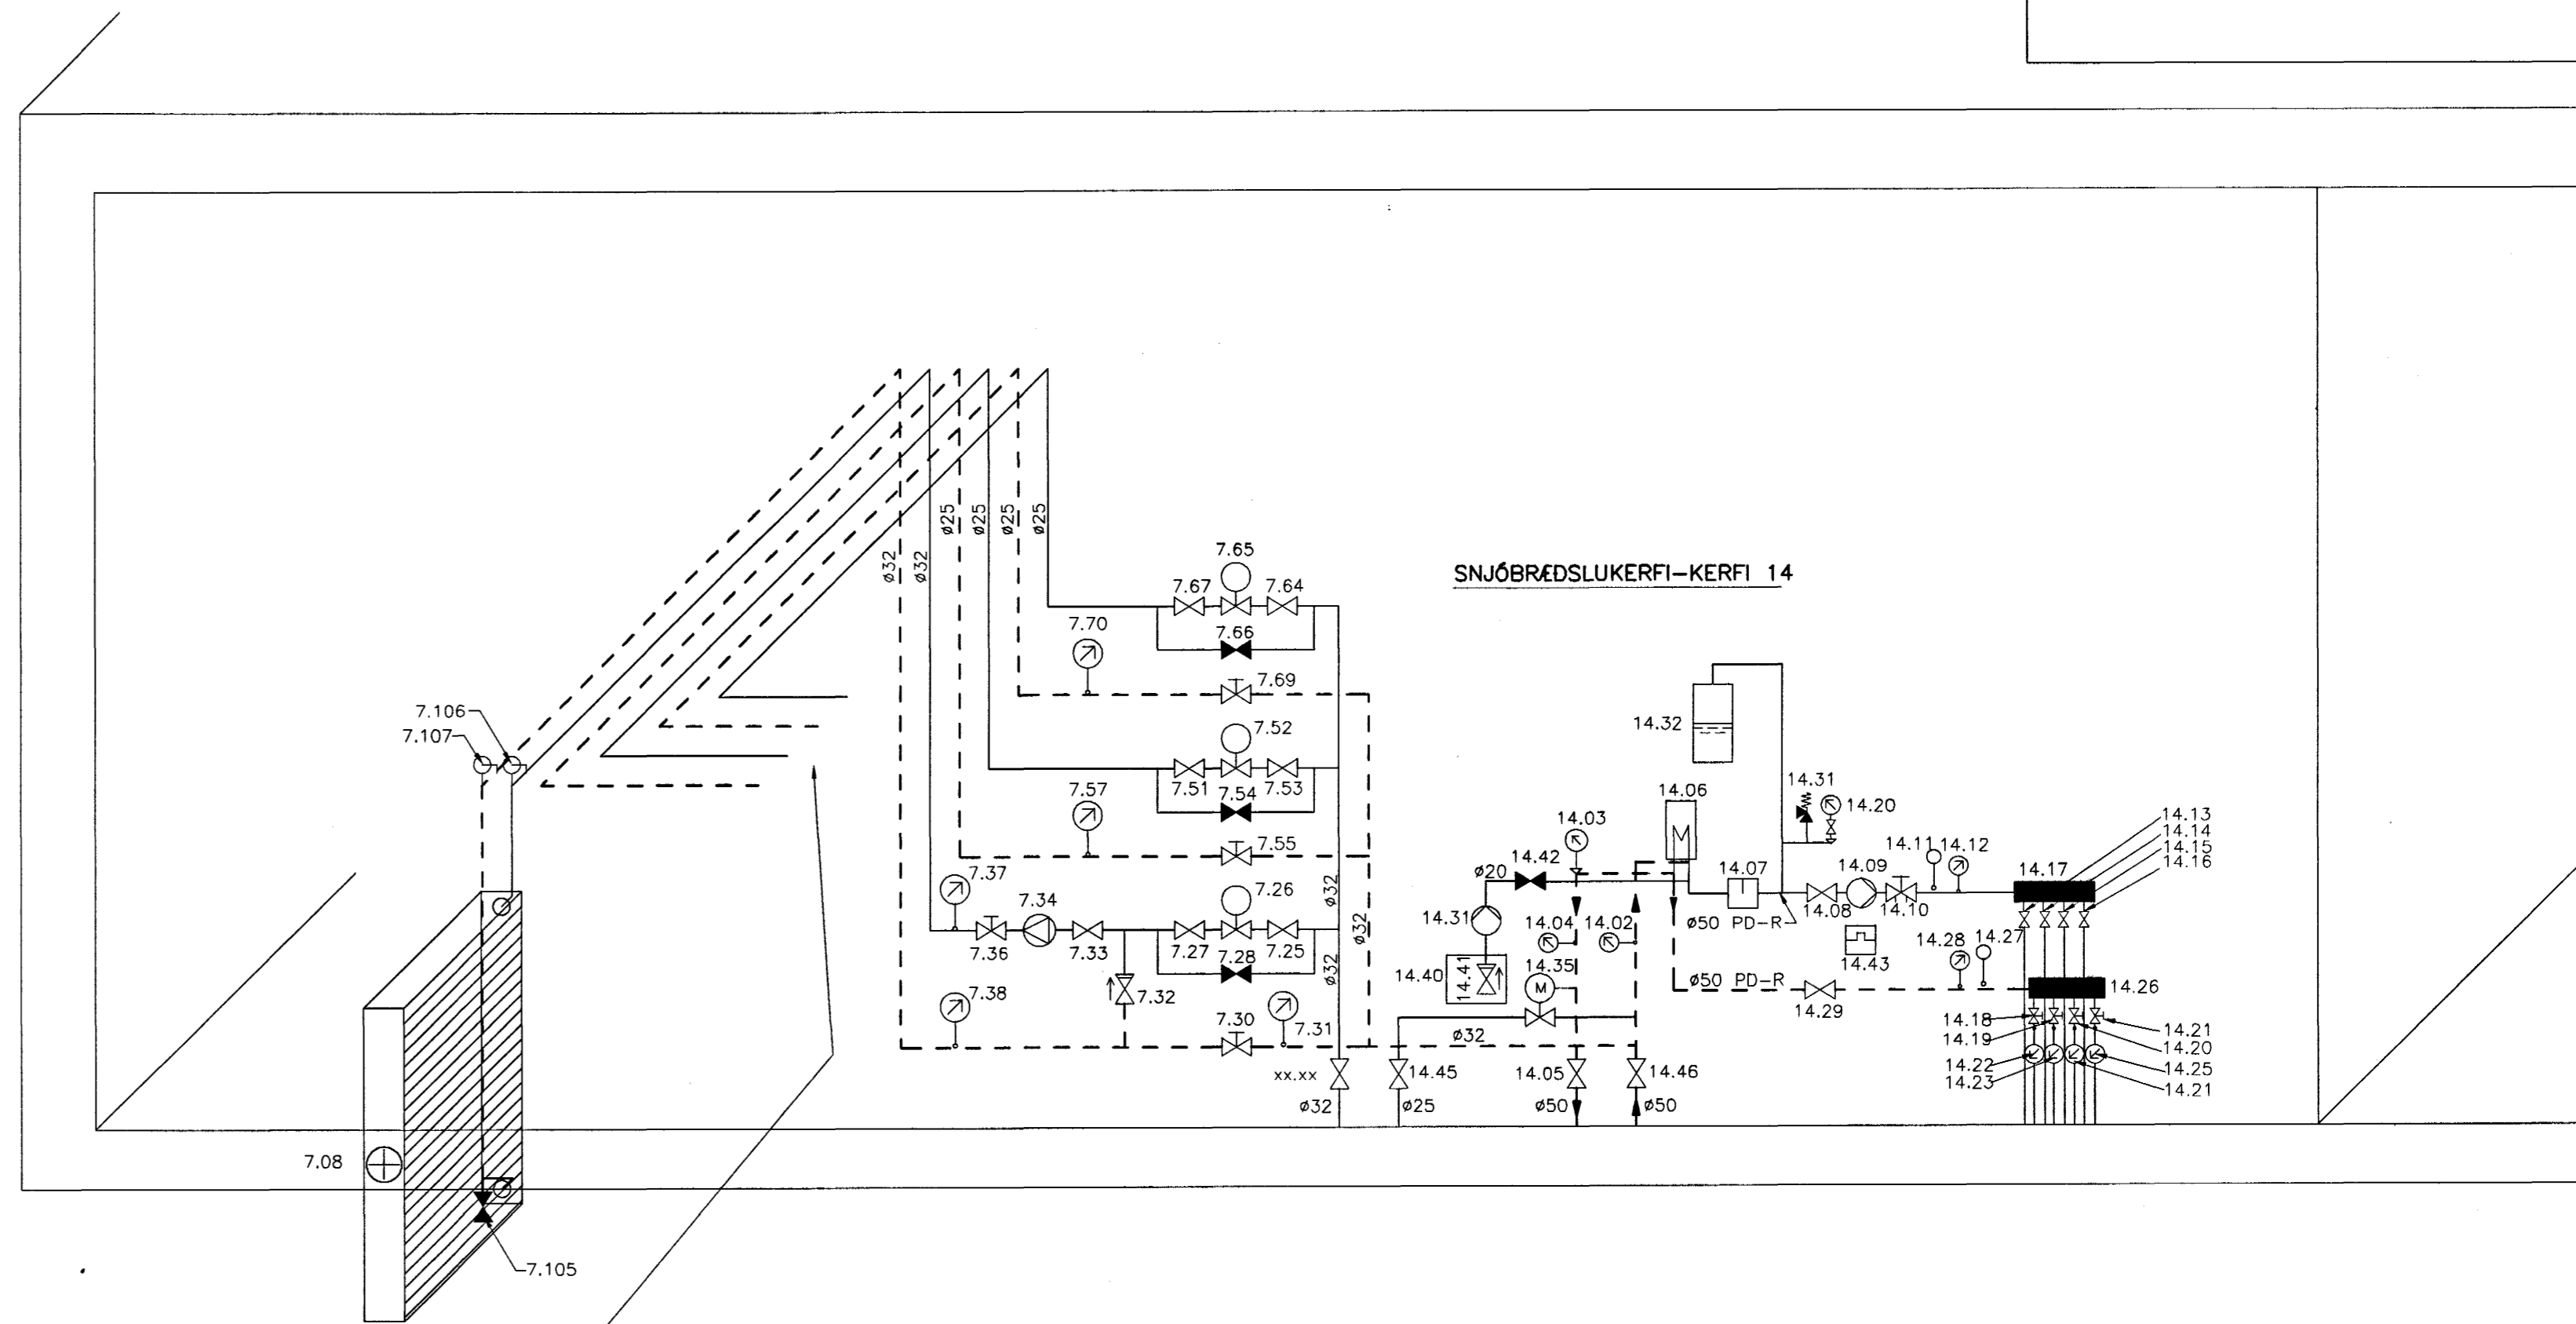

SNID B
1:20 P21

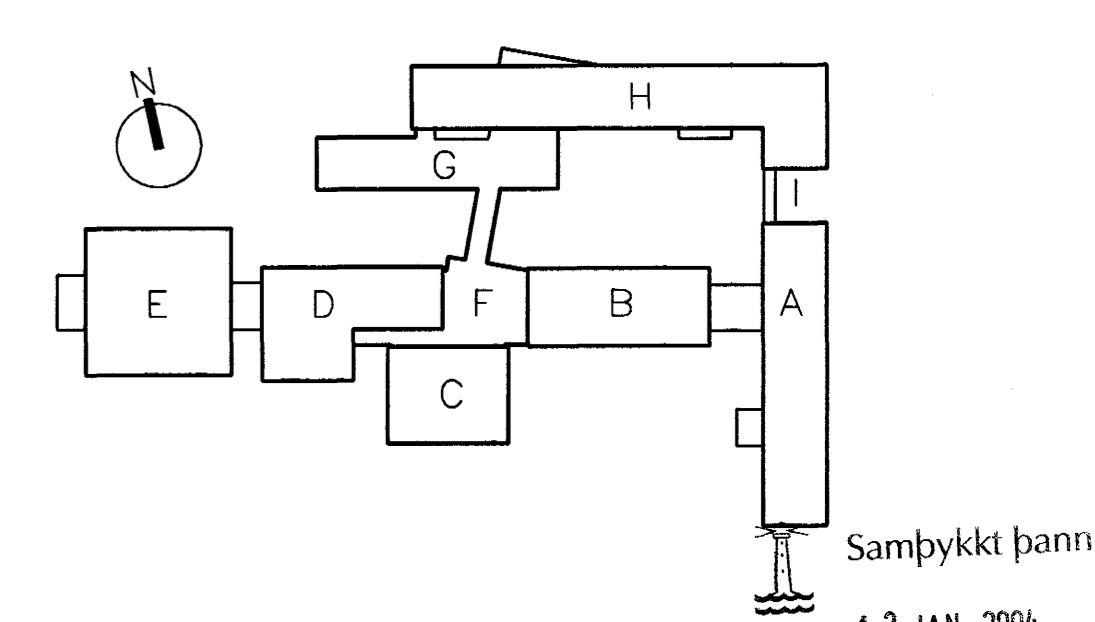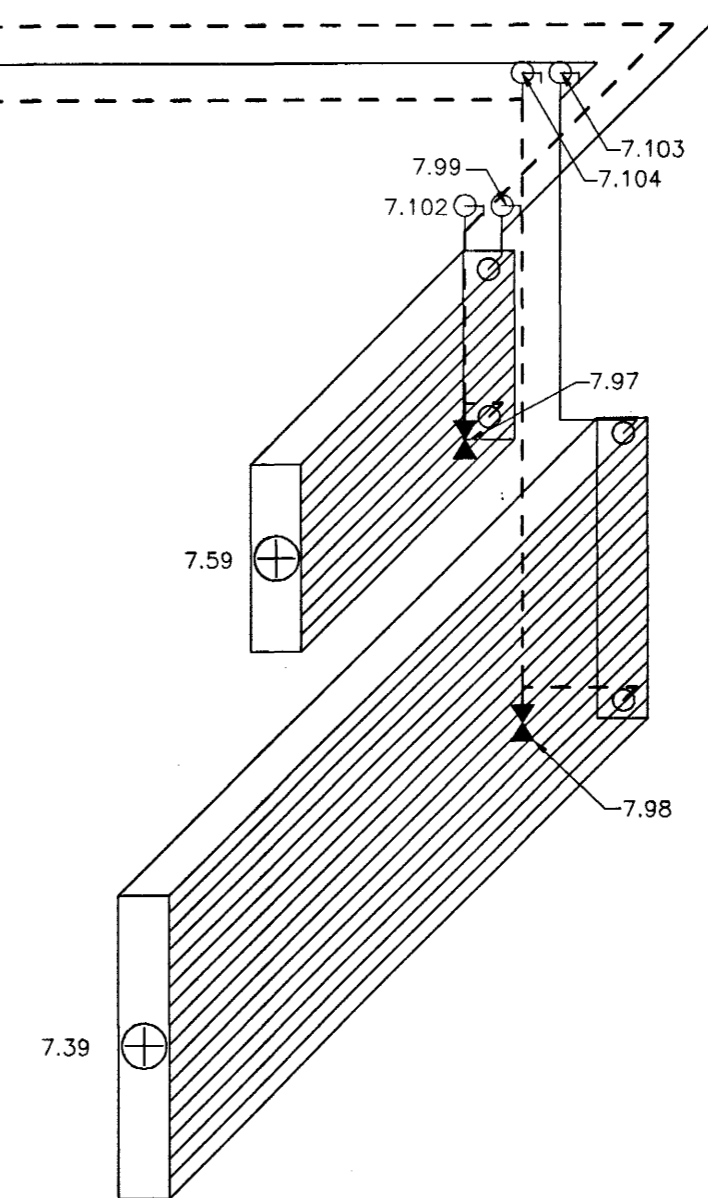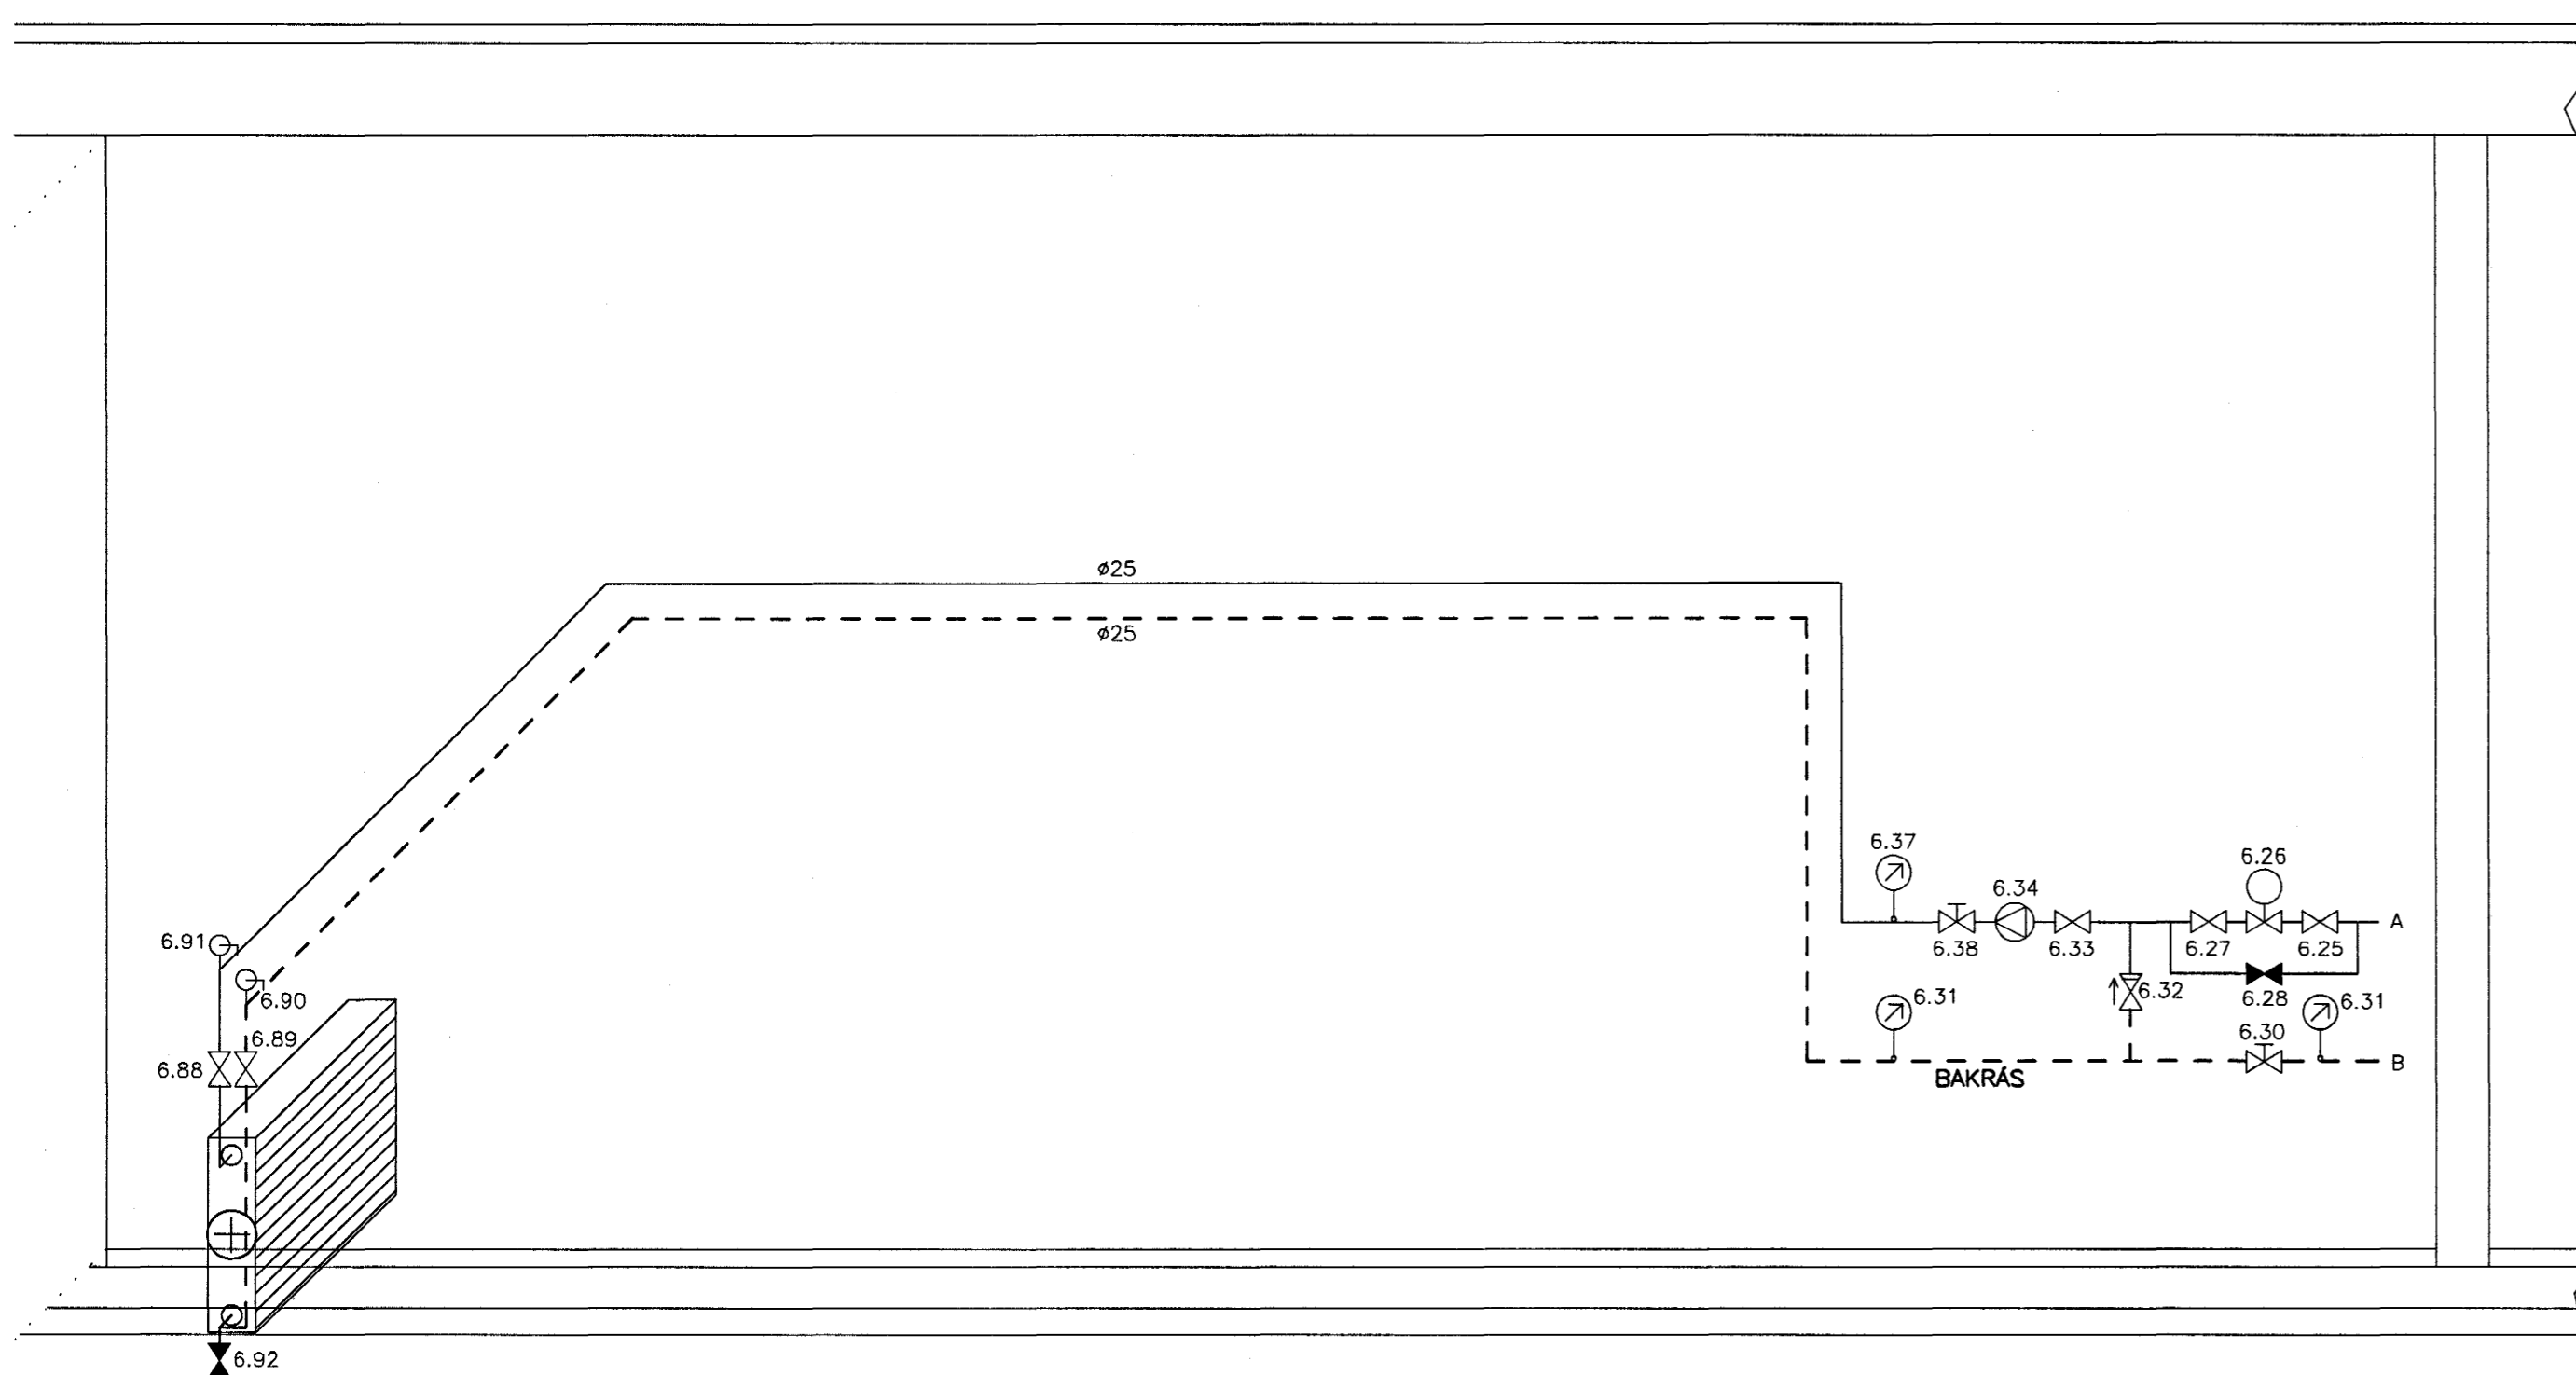

VINNUTEIKNING
26 NOV 2003

FASTEIGNAFÉLAG HAFNARFJÖRDAR

BATTERIÐ

Abtönnunur Sigurbjör Einarsson
Kvæðing 110557-789
Kt. 110457-2789

ALLAR ALMENNAR SKÝRINGAR SJÁ TEIKN. PÓO

A	14.10.03	INNTAKSRIND I SNIDI A OG SNIDMERKINGAR	HSS	SÁS
ÓTG.	DAGS.	BREYTING:	HANNAD	SAMP.
HRAUNTUNGA 7, VÍDISTADASKÓLI VÍDBYGGING		HITALAGNIR KERFISMYNDIR, VEGGMYNDIR		
VSB VERKFRÆDISTOFA		Arinn Rægg, hönnuðar		
BEIARHRAUNI 20•220 HAFNARFJÖRDUR Helmasíða: www.vsb.is • Netfang: vsb@vsb.is Sími: 585-8600 Fax: 585-8610 • Kt. 710796-2899		Sími: 585-8600 Fax: 585-8610 • Kt. 710796-2899		
FRV		Dags: 14.03.03 Nr: 02830-P45A		