



SIDEWALL FRAMING AT LINE A (SHOWN)
SIDEWALL FRAMING AT LINE G (OPP. HAND)

F.B. COL. - 8 x 1/2 (0.2032 x 0.0095) FLANGES / 20" x 1/8 (0.5080 x 0.0048) WEB

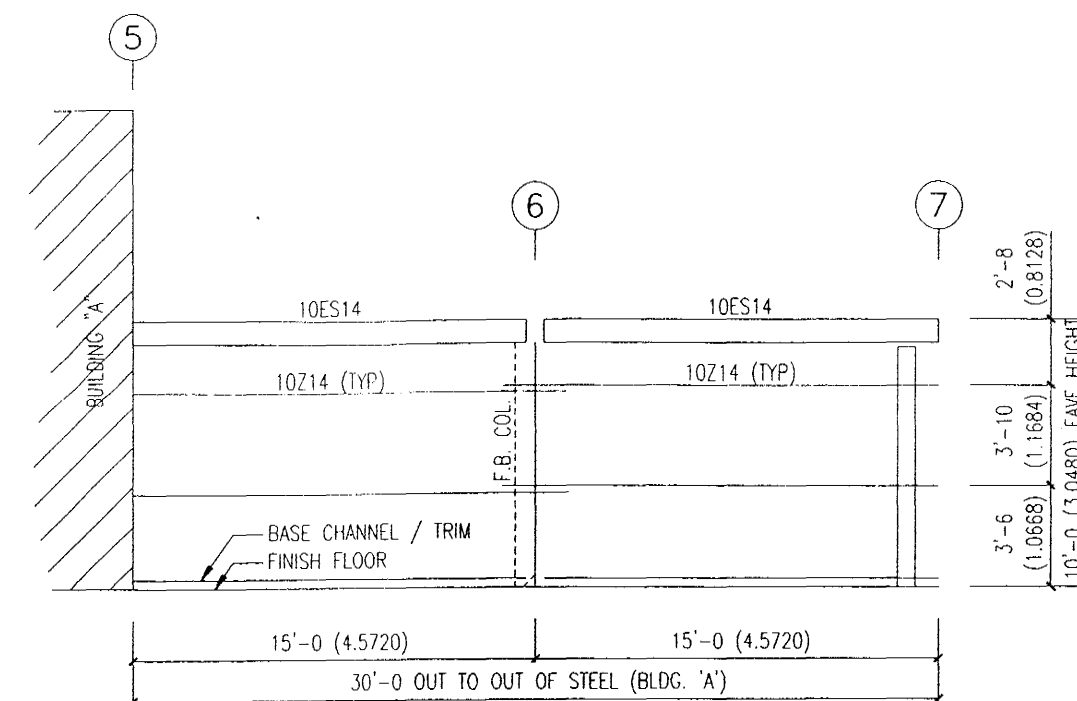


SIDEWALL FRAMING AT LINE B (SHOWN)
SIDEWALL FRAMING AT LINE F (OPP. HAND)

F.B. COL. - 6 x 1/2 (0.1524 x 0.0063) FLANGES / 12" x 1/8 (0.3048 x 0.0048) WEB

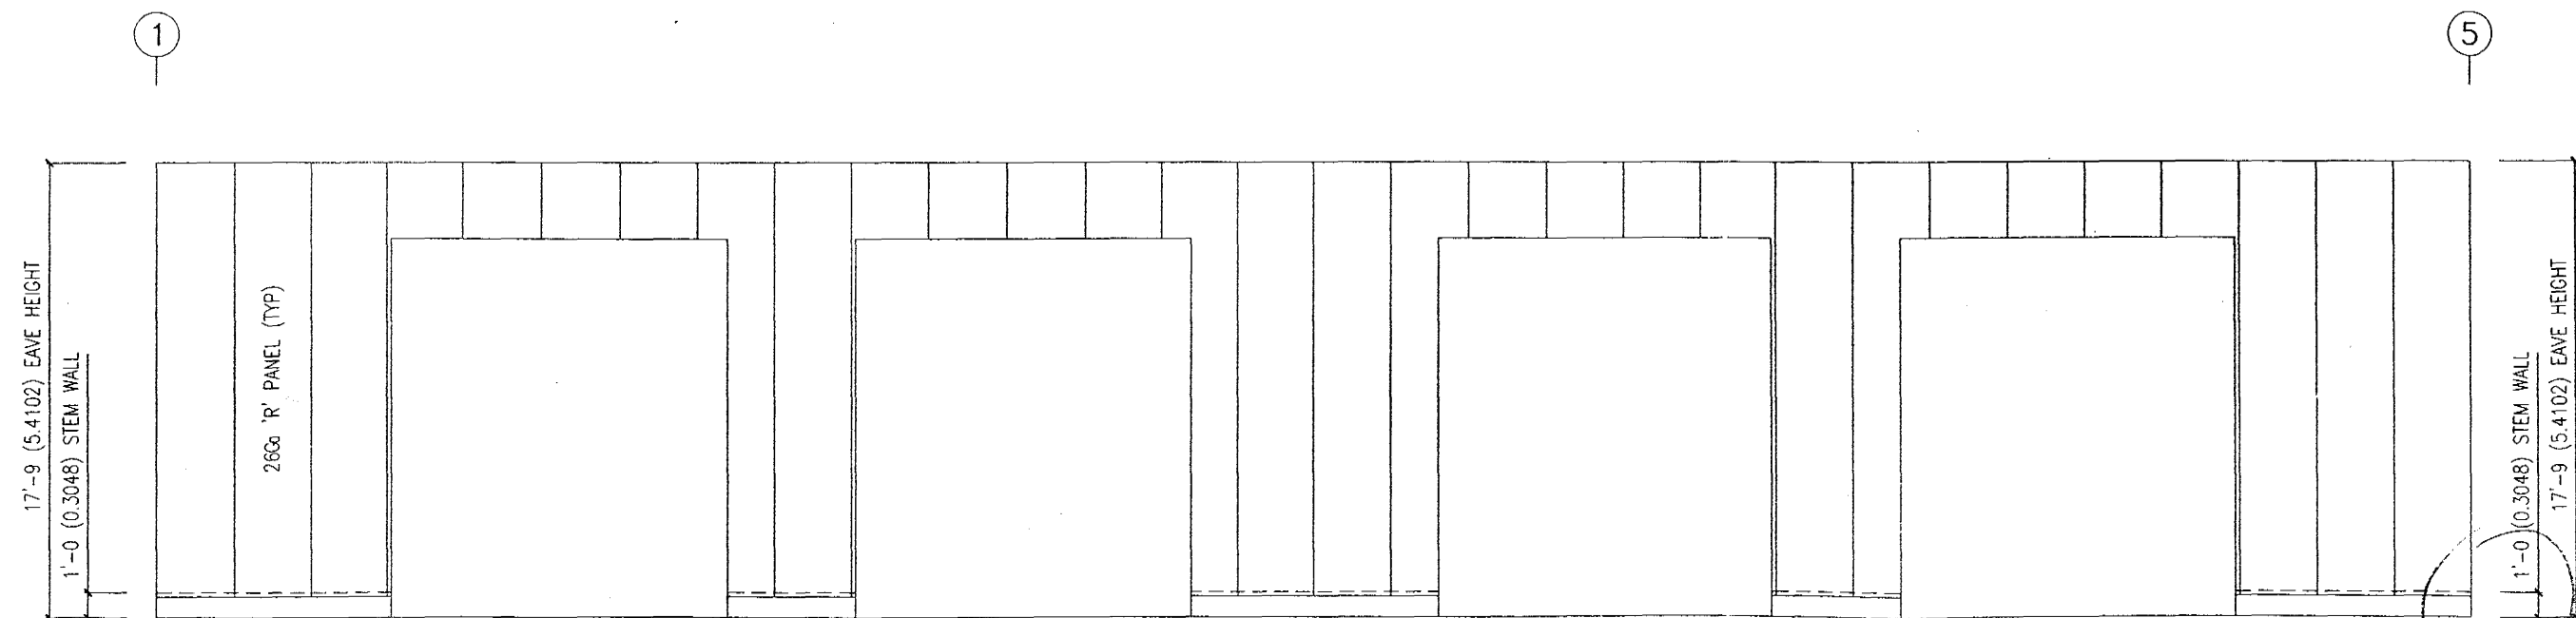

SIDEWALL SHEETING AT LINE A (SHOWN)
SIDEWALL SHEETING AT LINE G (OPP. HAND)

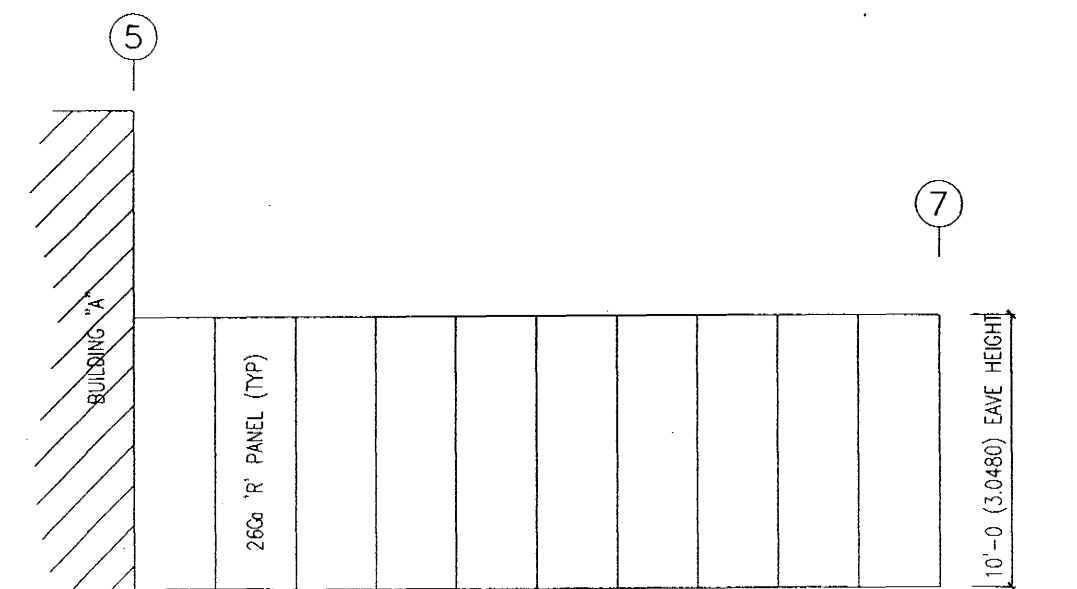

SIDEWALL SHEETING AT LINE B (SHOWN)
SIDEWALL SHEETING AT LINE F (OPP. HAND)

HRINGHELLA 4, HAFNARFJÖÐI

Breyting 26/3-2002
Bætt við langdaga r. vegg
þar sem 6" voru á milli - voru þær
3' fet í sýðinn

() - DENOTES METRIC

QTY	SIZE	JAMB ("+3")	HEADER ("+4")	SILL ("+4")	JAMB COVER	HEAD COVER
8	13'x14'-9" O.H. DOOR					
4	7'-5" x 3'-2"					
8	3'-4" x 7'-2"					

SIDEWALL FRAMING BOLTS			
MARK	QTY	DESCRIPTION	SIZE
A		GIRT LAP BOLTS	1/2" DIA. x 1" MB
B		GIRT TO FRAME	1/2" DIA. x 1" MB

DRAWING STATUS	
<input type="checkbox"/>	FOR APPROVAL - THESE DRAWINGS, BEING FOR APPROVAL, ARE BY DEFINITION NOT FINAL AND ARE FOR CONCEPTUAL REPRESENTATION ONLY. THEIR PURPOSE IS TO CONFIRM PROPER INTERPRETATION OF THE PROJECT DOCUMENTS. ONLY DRAWINGS ISSUED "FOR CONSTRUCTION" CAN BE CONSIDERED AS COMPLETE.
<input checked="" type="checkbox"/>	FOR PERMIT - THESE DRAWINGS, BEING FOR PERMIT, ARE BY DEFINITION NOT FINAL IN THAT, AS A MINIMUM, PIECE MARKINGS ARE NOT IDENTIFIED. ONLY DRAWINGS ISSUED "FOR CONSTRUCTION" CAN BE CONSIDERED AS COMPLETE.
<input checked="" type="checkbox"/>	FOR CONSTRUCTION - FINAL DRAWINGS.

REVISIONS			
NO.	DATE	DESCRIPTION	BY
A	11-7-01	FOR PERMIT	JWC

metallic building company
7301 FAIRVIEW • HOUSTON, TEXAS • P.O. BOX 40338
ZIP 77041 (713) 465-7788 ZIP 77240

DESCRIPTION: SIDEWALL ELEVATIONS / HLIÐARMYNDER LANGVEGGJA OG KLÆÐNINGAR
SIZE: SEE BUILDING DESCRIPTION SHEET C1
CUSTOMER: SCAN-STEEL INTERNATIONAL TRUCKSTATION
LOCATION: ICELAND
DRN BY: CK'D BY: DATE: SCALE: NONE JOB NO: 0105-197484 PH: BLDG. DESC: A SHEET NO: E2 of 7 ISSUE: BB

NOTE: THE UNDERSIGNED IS NOT THE ENGINEER OF RECORD FOR THE OVERALL PROJECT.

DESIGN: APR 1 DATE: APR 1 DATE: APR 1 DATE: APR 1

Byggingarfulltrúi Hamarjardar Atgrettur Þann
18 APR 2002