



ENDWALL FRAMING AT LINE 1

BU1 - 5 x 1/4 (0.1270 x 0.0063) FLANGES / 12 x 3/8 (0.3048 x 0.0048) WEB  
 BU2 - 6 x 1/4 (0.1524 x 0.0063) FLANGES / 12 x 3/8 (0.3048 x 0.0048) WEB

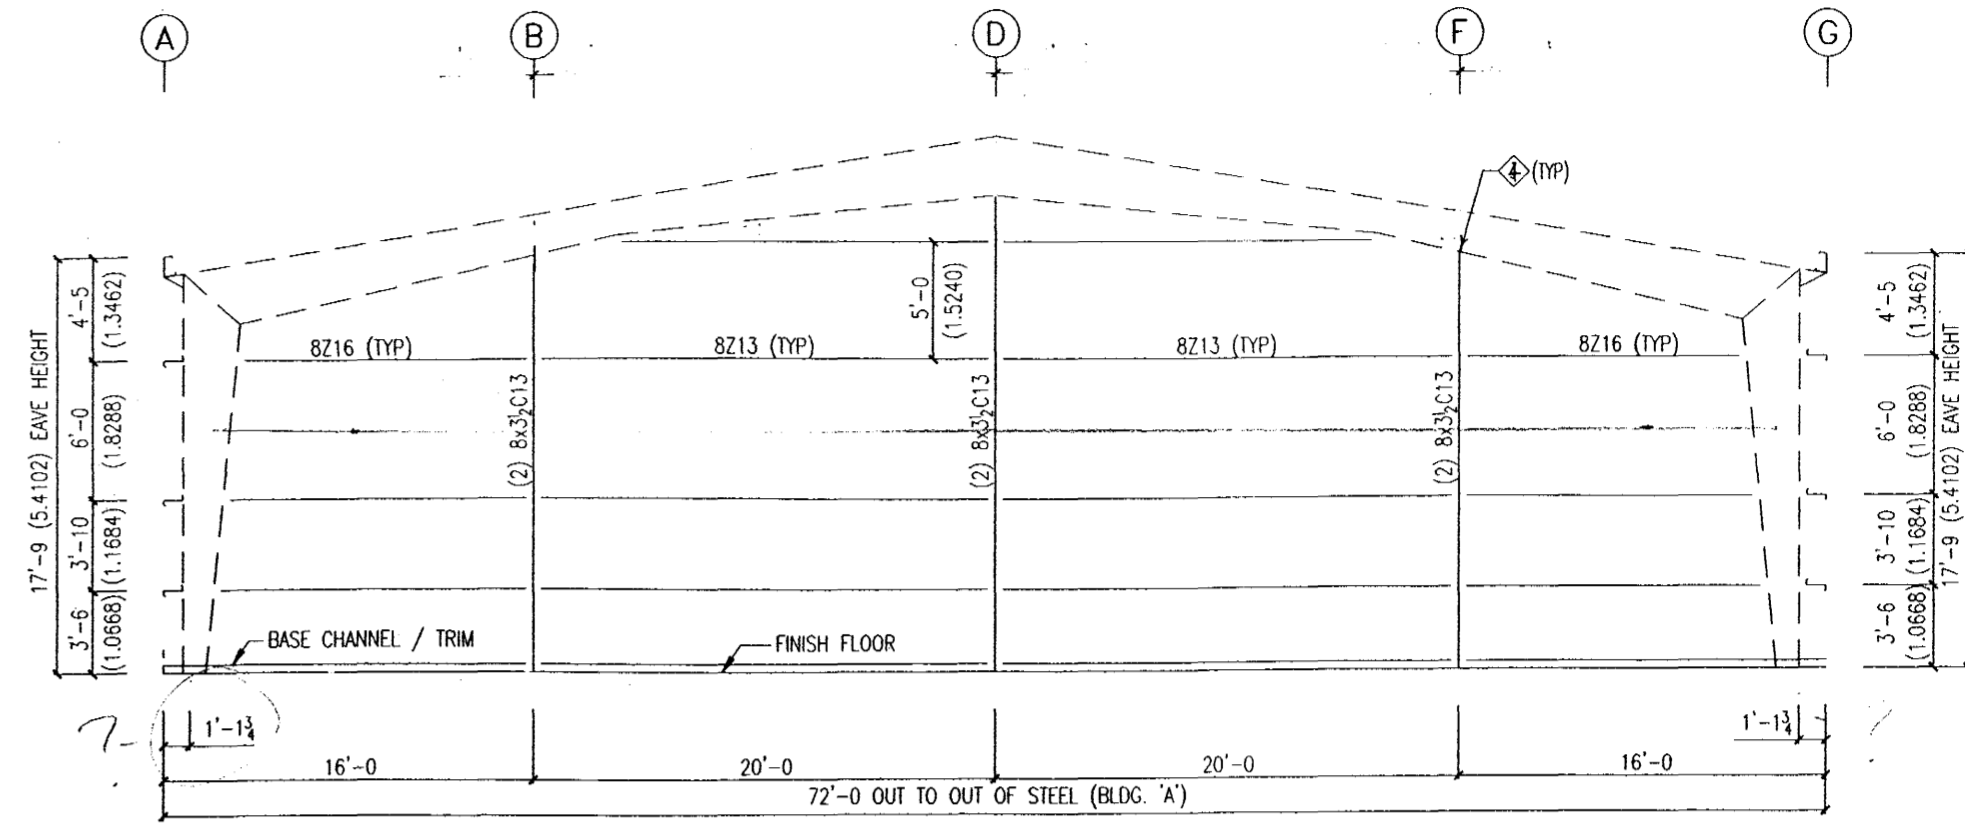


PARTITION WALL FRAMING AT LINE 4

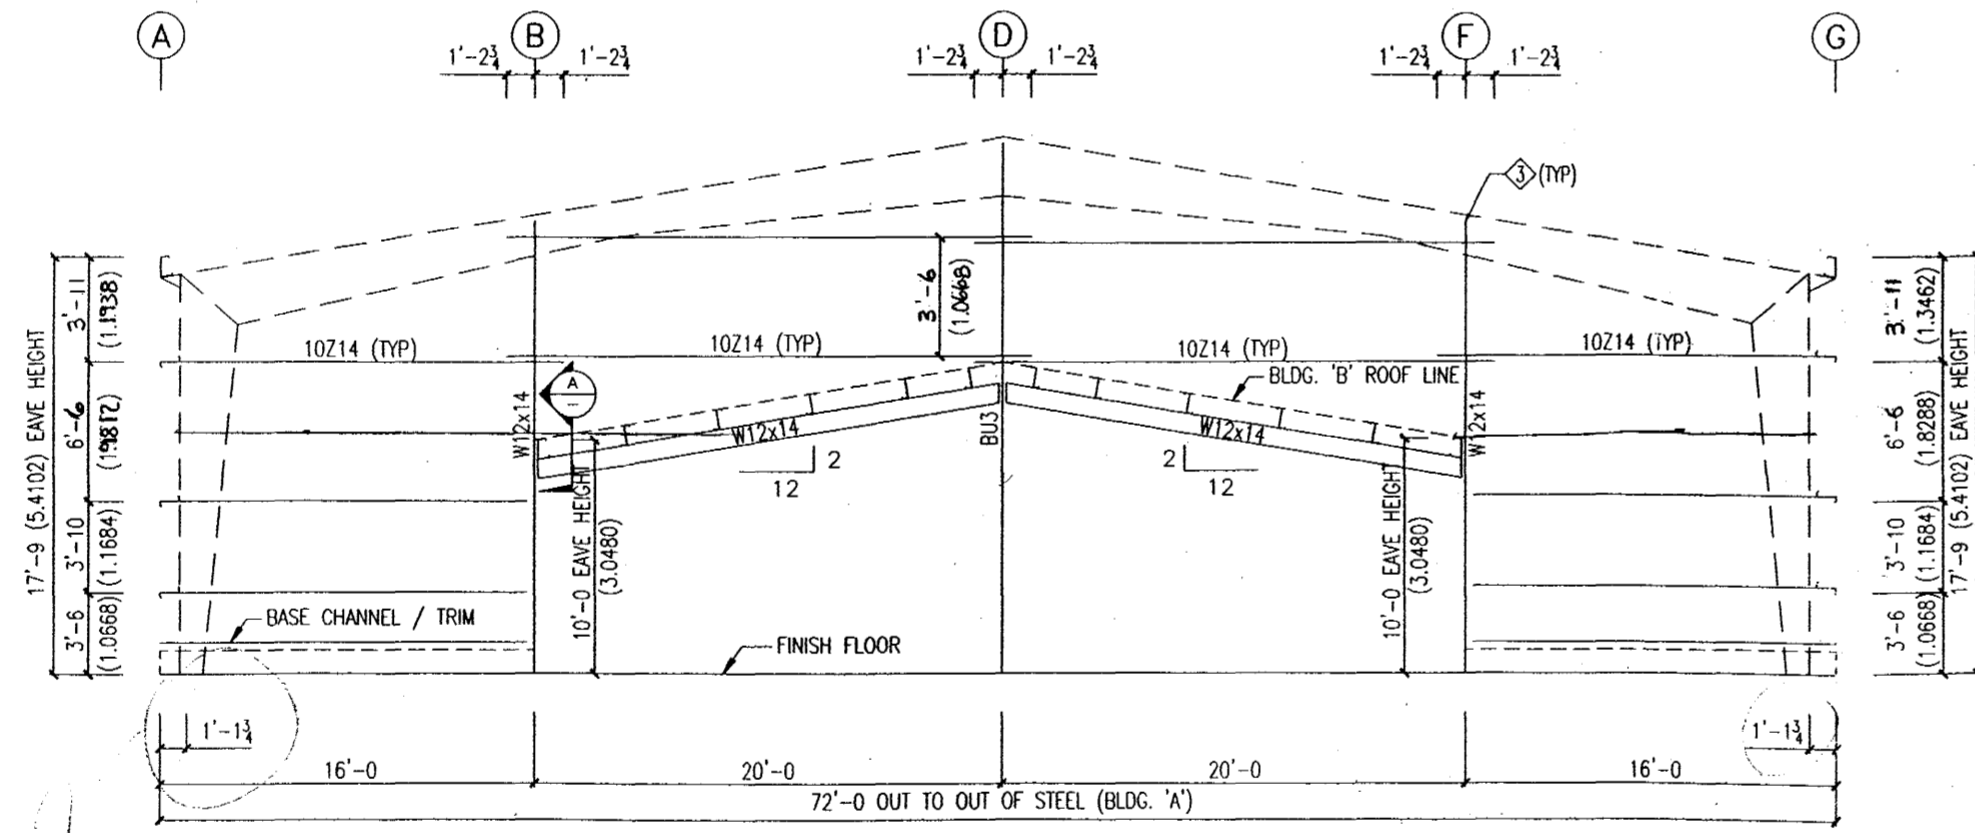

ENDWALL FRAMING AT LINE 5

BU3 - 6 x 3/8 (0.1524 x 0.0079) FLANGES / 12 x 3/8 (0.3048 x 0.0048) WEB

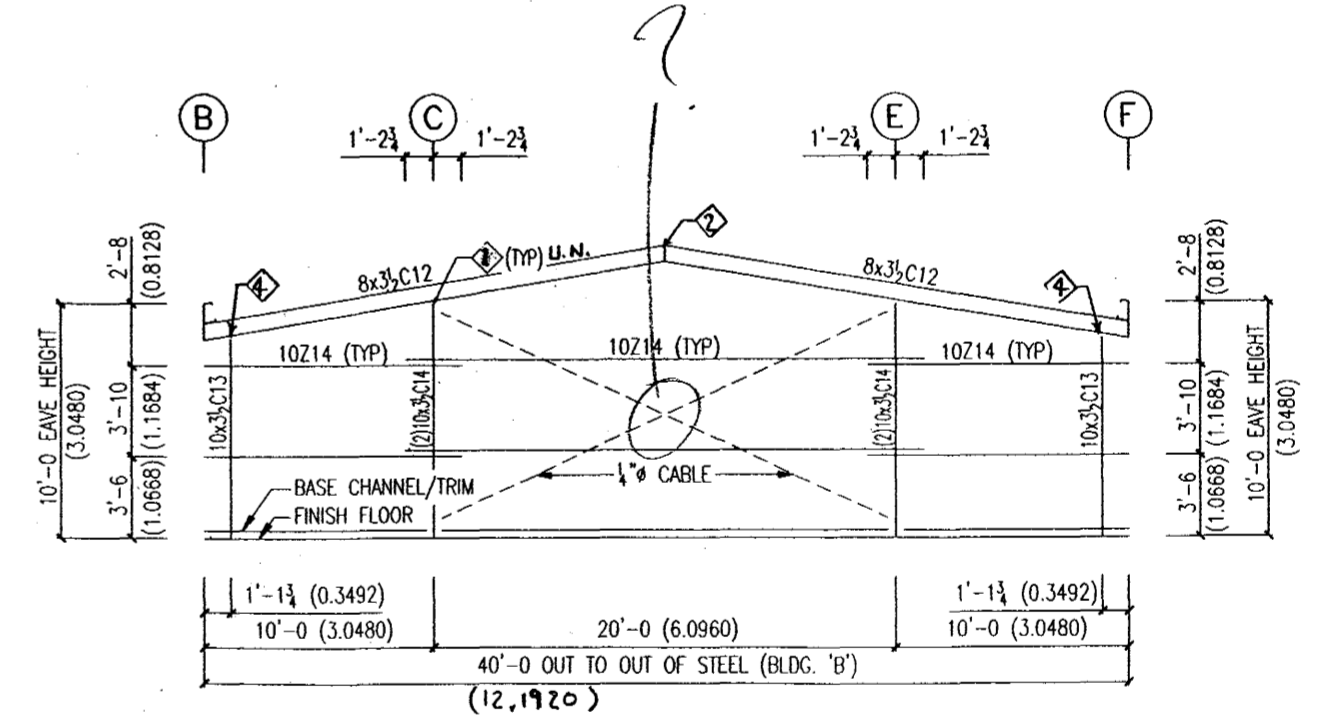

ENDWALL FRAMING AT LINE 7

( ) - DENOTES METRIC

MARK	QTY	DESCRIPTION	SIZE
A		GIRT LAP BOLTS	1/2" DIA x 1" MB.
B		GIRT TO FRAME	5/8" DIA x 1" MB.
C		COL. TO RAFT.	5/8" DIA x 1 1/4" A325 BLTS
D		RAFT. TO RAFT.	5/8" DIA x 1 1/4" A325 BLTS

SYMBOL	QTY.	LOCATION	DESCRIPTION
1	4	COL. / RAF.	5/8" DIA. X 1 1/4" A325 BOLTS WITHOUT WASHERS
2	4	RAF. / RAF.	5/8" DIA. X 1 3/4" A325 BOLTS WITHOUT WASHERS
3	8	COL. / RAF.	5/8" DIA. X 1 1/4" A325 BOLTS WITHOUT WASHERS
4	2	COL. / RAF.	5/8" DIA. X 1 1/4" A325 BOLTS WITHOUT WASHERS

**DRAWING STATUS**

FOR APPROVAL: THESE DRAWINGS, BEING FOR APPROVAL, ARE BY DEFINITION NOT FINAL AND ARE FOR CONCEPTUAL REPRESENTATION ONLY. THEIR PURPOSE IS TO CONFIRM PROPER INTERPRETATION OF THE PROJECT DOCUMENTS. ONLY DRAWINGS ISSUED "FOR CONSTRUCTION" CAN BE CONSIDERED AS COMPLETE.

FOR PERMIT: THESE DRAWINGS, BEING FOR PERMIT, ARE BY DEFINITION NOT FINAL IN THAT, AS A MINIMUM, PIECE MARKINGS ARE NOT IDENTIFIED. ONLY DRAWINGS ISSUED "FOR CONSTRUCTION" CAN BE CONSIDERED AS COMPLETE.

FOR CONSTRUCTION: FINAL DRAWINGS.

NO.		DATE	DESCRIPTION	BY	CHK'D
A		11-7-01	FOR PERMIT	JUC	

**METALLIC** metallic building company  
 7301 FAIRVIEW • HOUSTON, TEXAS • P.O. BOX 40338  
 ZIP 77041 (713) 466-7788 ZIP 77240

DESCRIPTION	ENDWALL FRAMING / HLIÐARMYNDER GAFLVEGGJA
SIZE	SEE BUILDING DESCRIPTION SHEET C1
CUSTOMER	SCAN-STEEL INTERNATIONAL TRUCKSTATION
LOCATION	ICELAND
DRN. BY	CK'D BY
DATE	SCALE
JOB NO.	PH. BLDG. DESC.
0105-197484	A
SHEET NO.	ISSUE
E3 of 7	A

*Breyting 26/3-2002*  

Byggingarhlutur Hafnarfjarðar  
 Hannart  
 18. NOV. 2002

NOTE: THE UNDERSIGNED IS NOT THE ENGINEER OF RECORD FOR THE OVERALL PROJECT.