


Byggingafræðingur  
Algrætt barn  
14 FEB. 2003

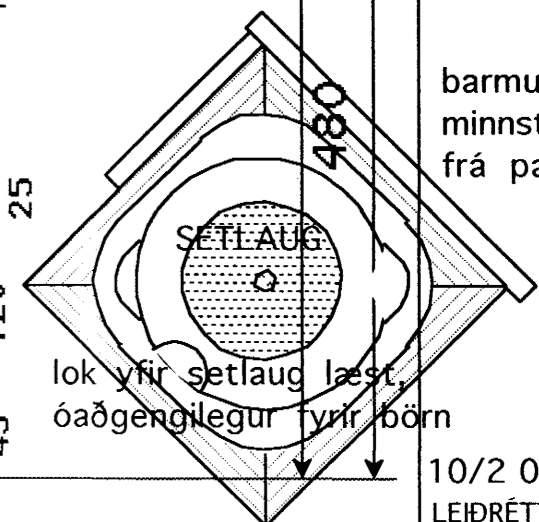

TEIKNISTOFAN	Verkefni	GAUKSÁS 57
	Heiti	HAFNARFIRÐI
		GRUNNMYND 1 HÆÐ
kvarði	1:50	verk.nr
dags.	okt. 02"	dags br.
hönnun	G.G.	teikn nr
teikn	G.G.	V-2

Hringbraut 17 220 Hafnarfjörður.  
S. 555 2020 FAX 555 2021  
N.F. kvardi@vortex.is