


GRUNNMYND 1 HÆÐ

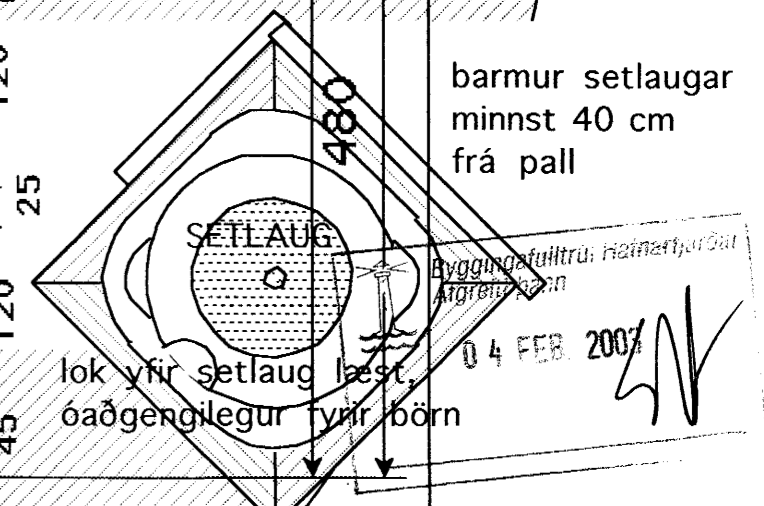

	TEIKNISTOFAN	Verkefni
		GAUKSÁS 57 HAFNARFIRÐI
	Heiti	GRUNNMYND 1 HÆÐ
kvarði	1:50	verk.nr
dags.	okt. 02"	dags br.
hönnun	G.G.	teikn nr
teikn	G.G.	V-2

Hringbraut 17 220 Hafnarfjörður.
S. 555 2020 FAX 555 2021
N.F. kvardi@vortex.is