



HÁHOLT

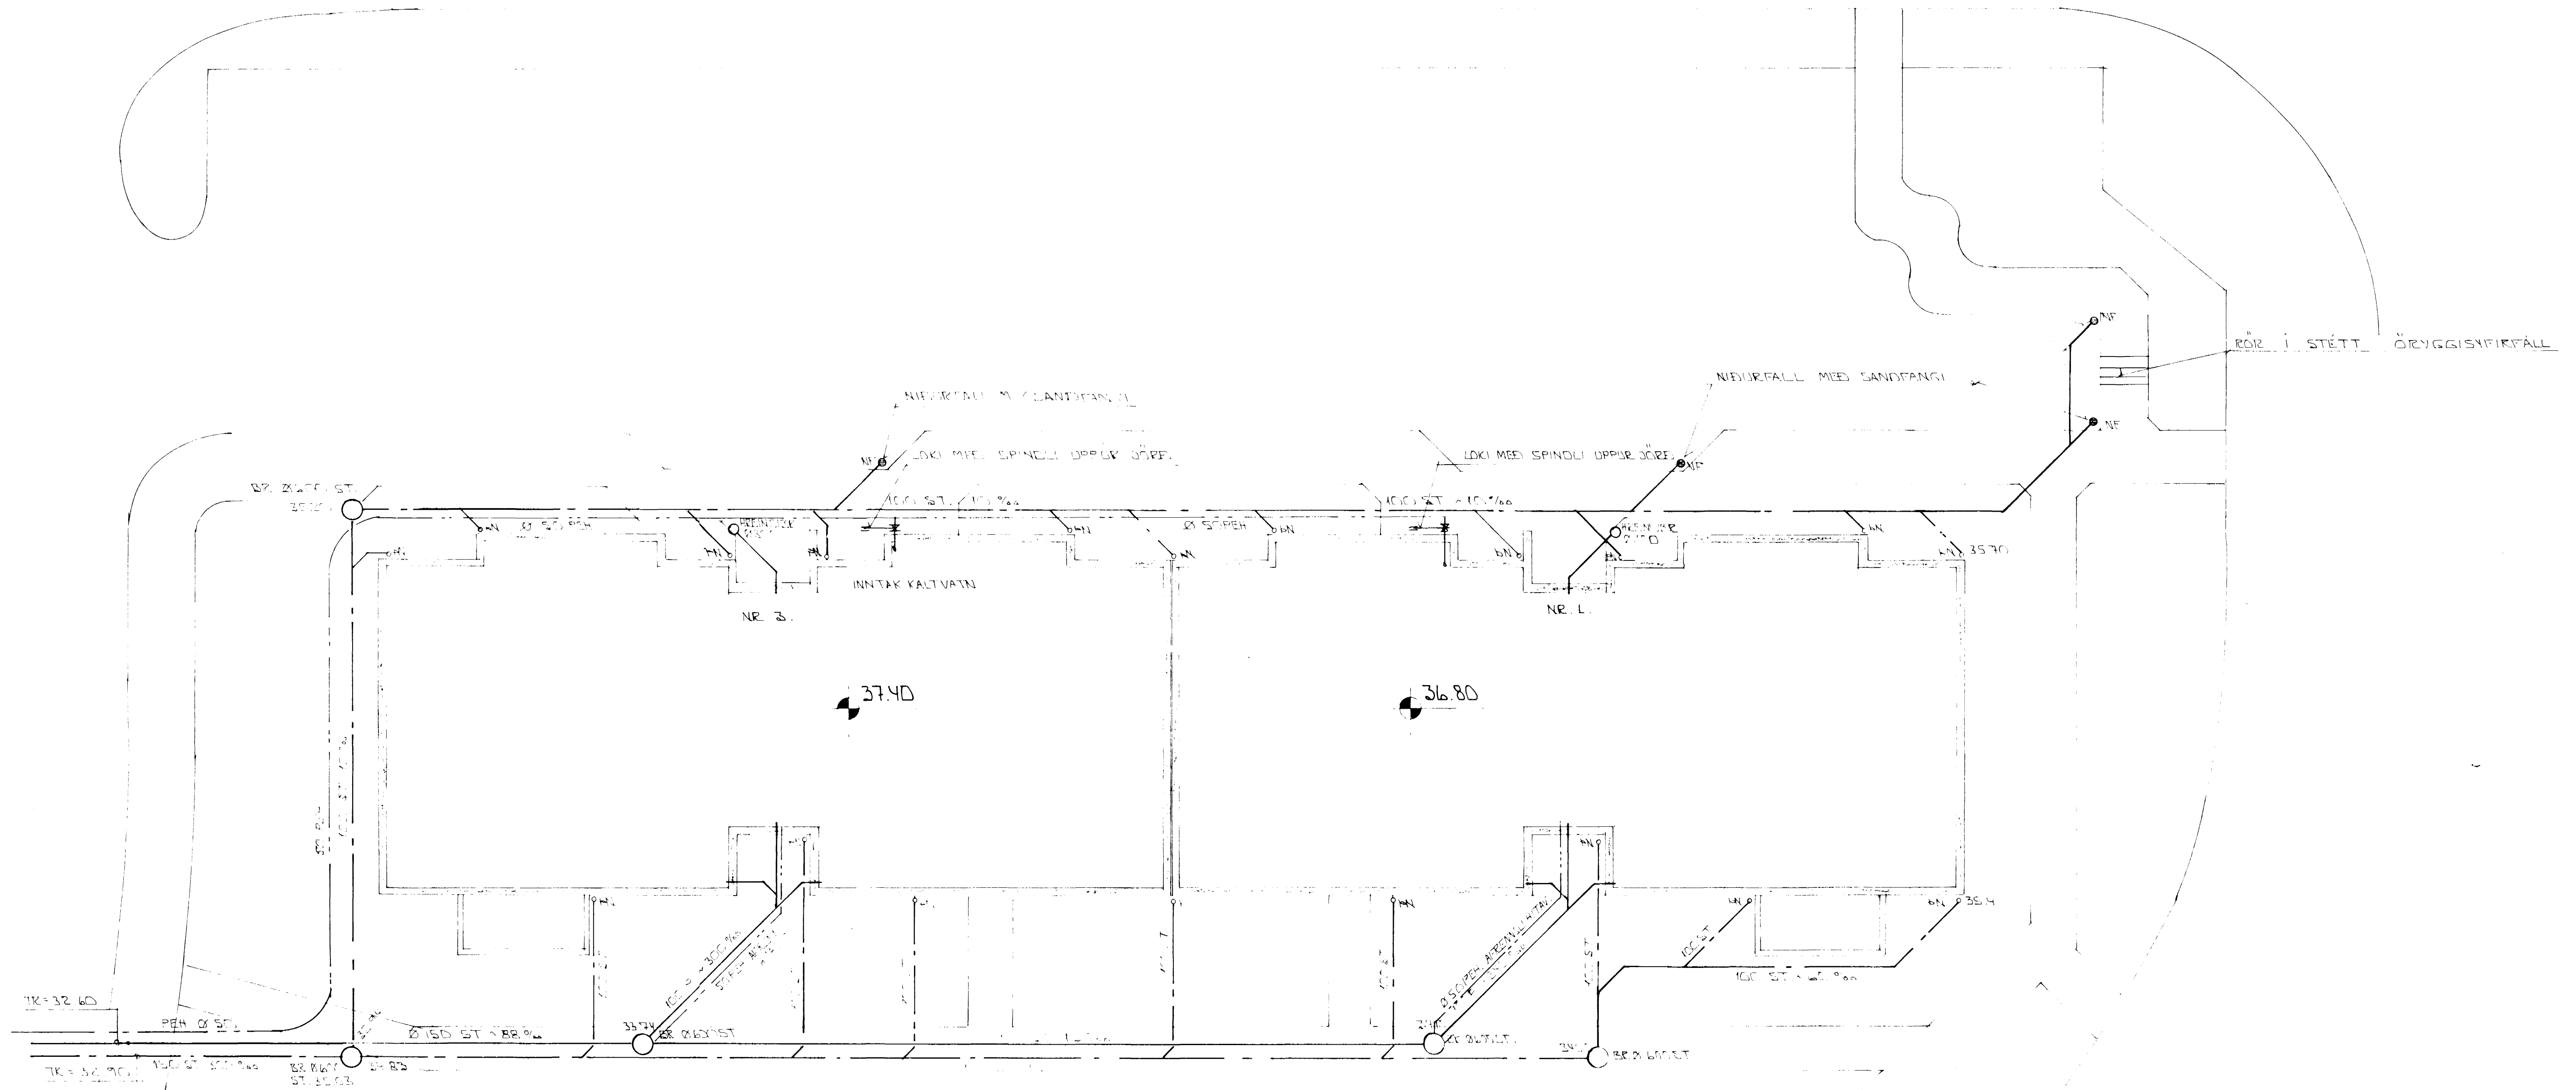

AFSTÖÐUMYND ÚTILAGNA • 1:100

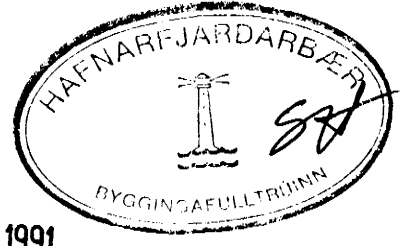

24 OCT 1991

DI	22 10 91	NIEURFÖLL Í STÉTT	
BR NR	DAGS	EDLI BREVTINGAR	SIGN
HÁHOLT 1 OG 3	HAFNARFJÖRÐI		
YFIRLITSMYND GRUNNLAGNA. (ÚTILAGNA)			DAGS MARS '90
MELIKV. 1:100			HAUNAD
SIGURÐUR ÞORLEIFSSON TEKNIFRÆÐINGUR F.T.F.F.I.			TEIKNAD
STRANDGÖTU 11 HAFNARFJÖRÐI SÍMI 54751/54255			VERK NR 9008
			BLAD NR 2-02