


GRUNNMÝND • 1:50

<p>STEYPA: $S > 250$ $VS \leq 0.5$ $LOFT \geq 6\%$ $SEMENT \geq 300 \text{ KG/M}^3$</p>

SKÝRINGAR
 ALMENNAR SKÝRINGAR SJÁ BL.NR. 1-0.
 SNID SJÁ BL.NR. 1-07.

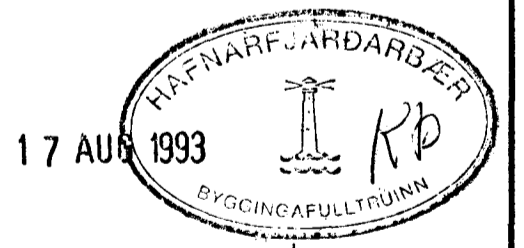

01	13.8.93	GLUGGUM BR. BÆTT VÍÐ VEGGJUM	GH
BR.NR.	DAGS	EBLI BREVTINGAR	SIGN.
HÁHOLT 10 HAFNARFIRÐI			DAGS OKT '90
BENDING VEGGJA 1 HEDAR			HANNAÐ
BENDING VEGGJA YFIR 1 HED			TEIKNAD GH
MELIKV. 1:50			VERK NR. 9042
SIGURÐUR ÞORLEIFSSON TEKNIFRÆÐINGUR F.M.F.			BLADNR. 1-04
STRANDGÖTU 11 HAFNARFIRÐI SÍMI 54751/54255			