




SNID 5-5 1:20

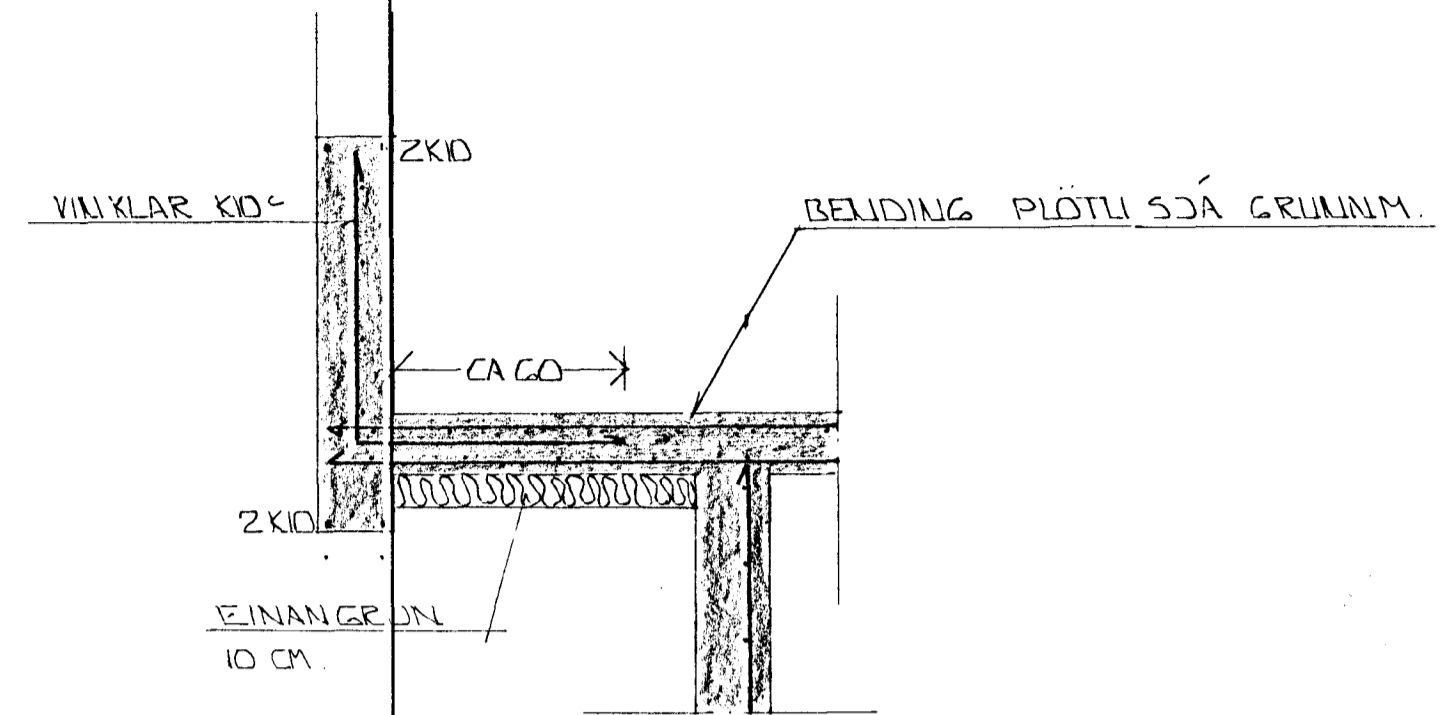


SNID 6-6 1:20

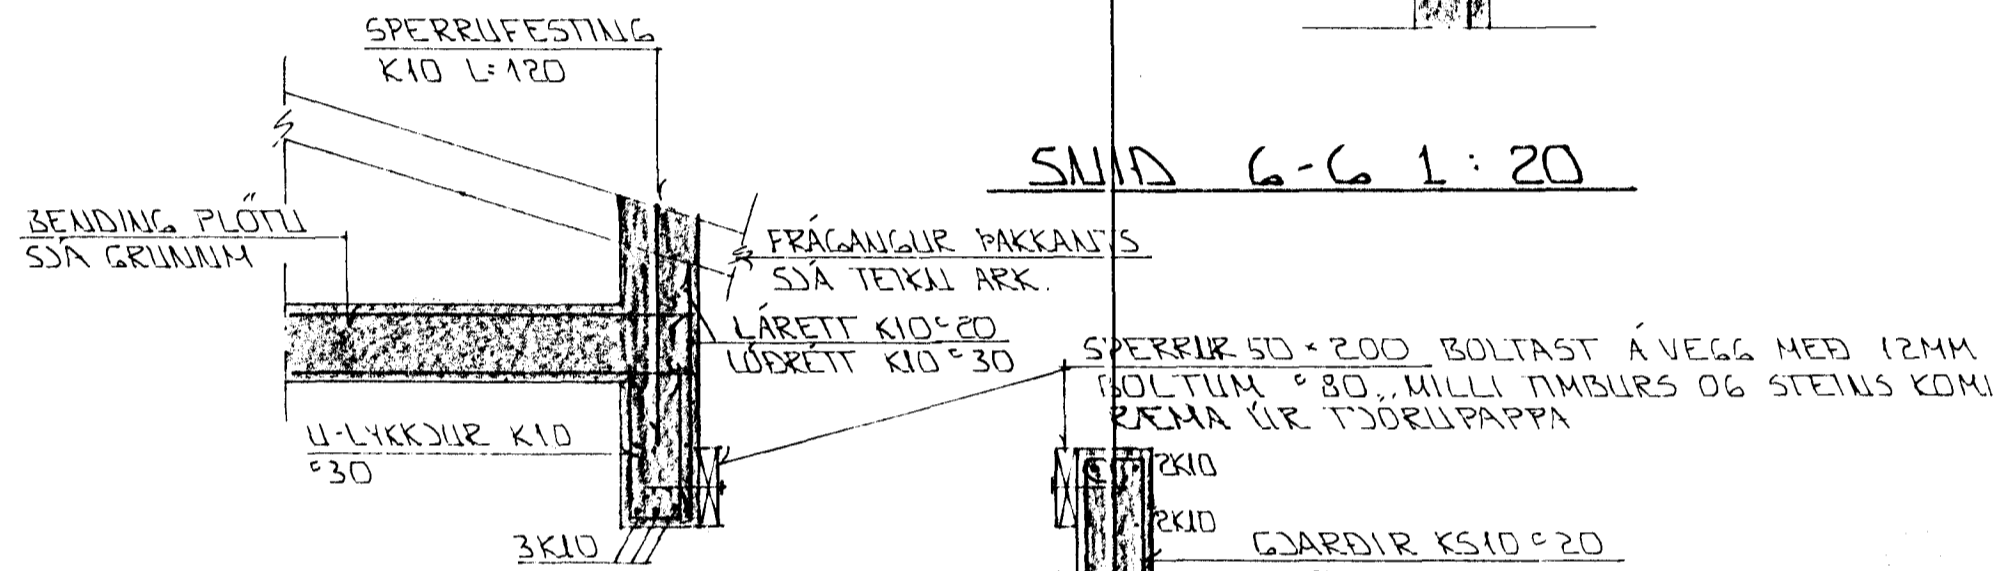

SNID 9-9 1:20

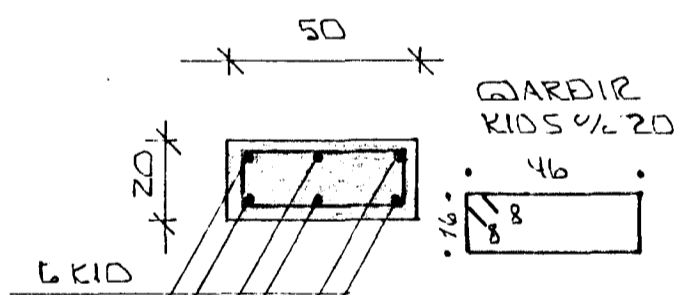

SÚLA S1 1:20

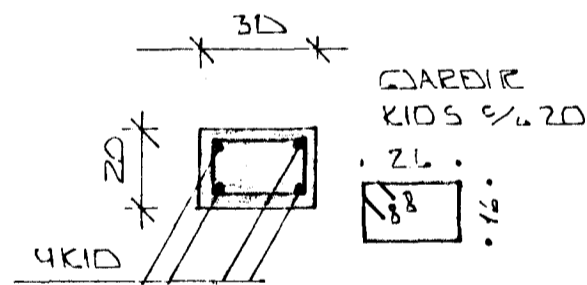

SÚLA S2 1:20

ÁSKILIÐ, ELDRI
TEIKNING ÓGILD

17 AUG 1993



01	13.8.93	BETT VÍÐ SNID 9-9	GH
BR.NR.	DAGS	EDLI BREVINGAR	SIGN.
HÁNDLT 10 HAFNARFIRÐI			DAGS NOV '90
BURÐARVIKI - SNID			HANNAÐ
MÆLIKV. 1:20			TEIKNING
SIGURÐUR ÞORLEIFSSON			VERK NR. 9042
STRANDGÖTU 11 HAFNARFIRÐI SÍMI 54751754255			BLAD NR. 1-07