


GRUNNMYND 3. HÆÐAR 1:50

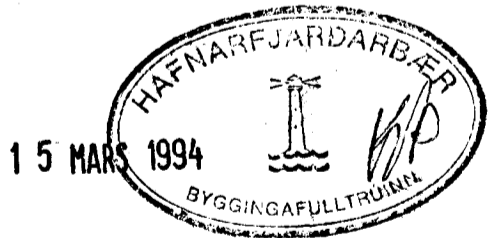

01	MARS '94	OFN NR 308 STEKKADUR	GH
BRUK. DAGS	EDLI BREVTINGAR		SIGN.
HÁHOLT IO HAFNARFIRÐI			DAGS NOV '91
HITA - VATNS OG FRÆNNISLAGNIE			HANNA
3. HÆÐAR			FEIKNÆ
MELIKV. 1:50			VERK NR. 9164
SIGURÐUR ÞORLEIFSSON			BLAD NR. 2-06
STRANDGÖTU 11 HAFNARFIRÐI SÍMI 34731/34253			