
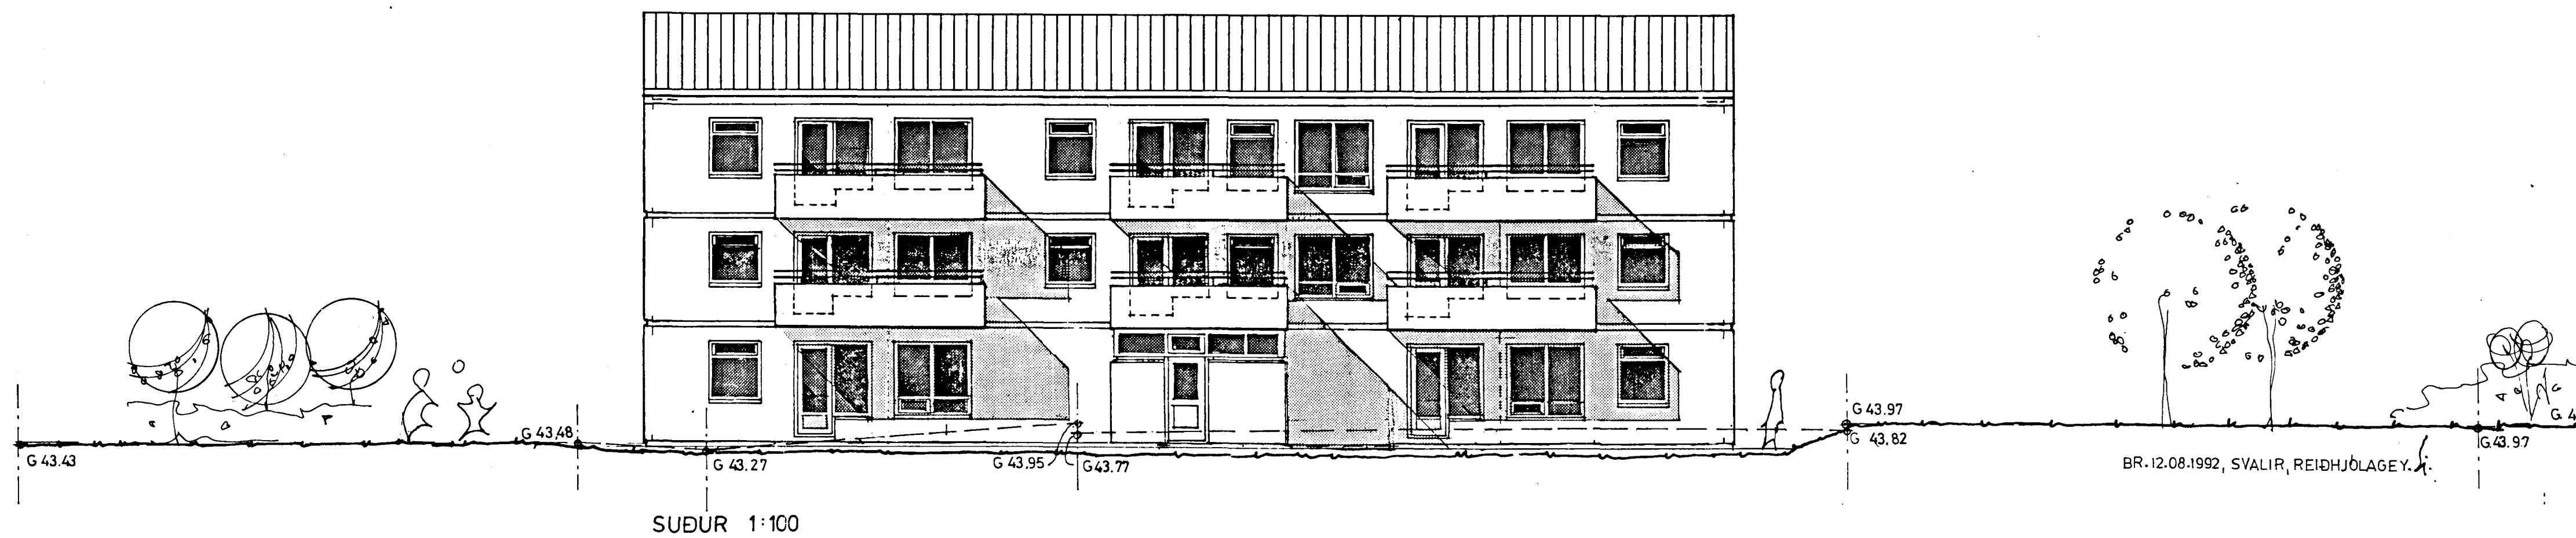


Samþykkt á fundi bygginga-  
nefndar þ. 19. 8. 1992  
BYGGINGAFULLTRÚINN  
Í HAFNARFIRÐI  
2/1992 KEYFID AFFUGIC

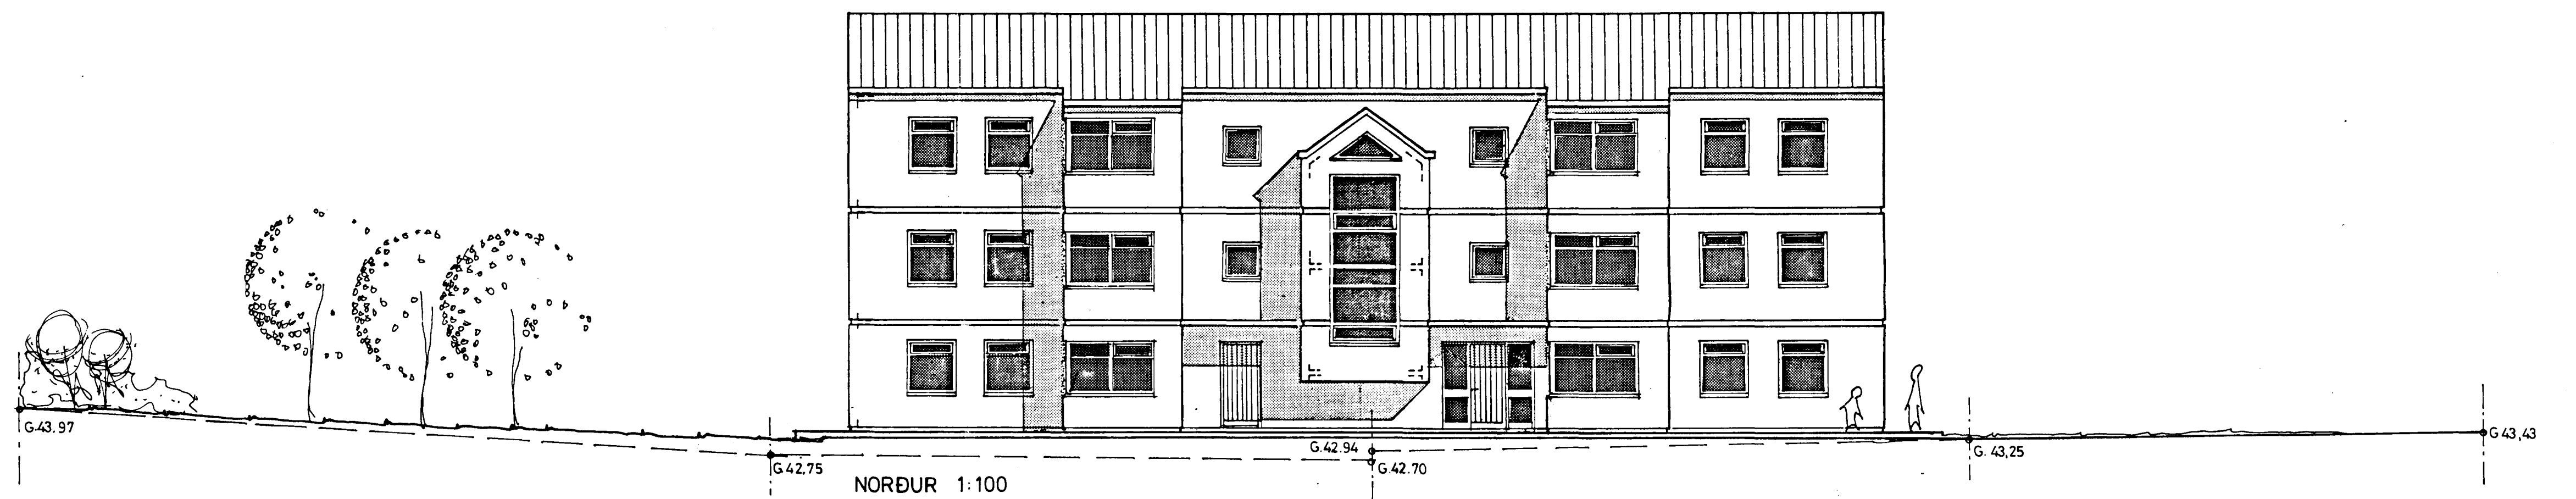

**HAHOLT 10, HAFNARFIRÐI**

ÚTLITSMYNDR 1:100

**04**

DAGS. 28.08.'91 MKV. 1:100 HANNAD SA/PVB/TEKN. G J/AE

FIGURDOR ADALSTEINSSON, ARKITEKT. PALL V. BJARNASON, ARKITEKT

*Guðrún Adalsteinsson, Pall V. Bjarnason*

BR-12.08.1992, SVALIR, REIÐHJÓLAGEY.