
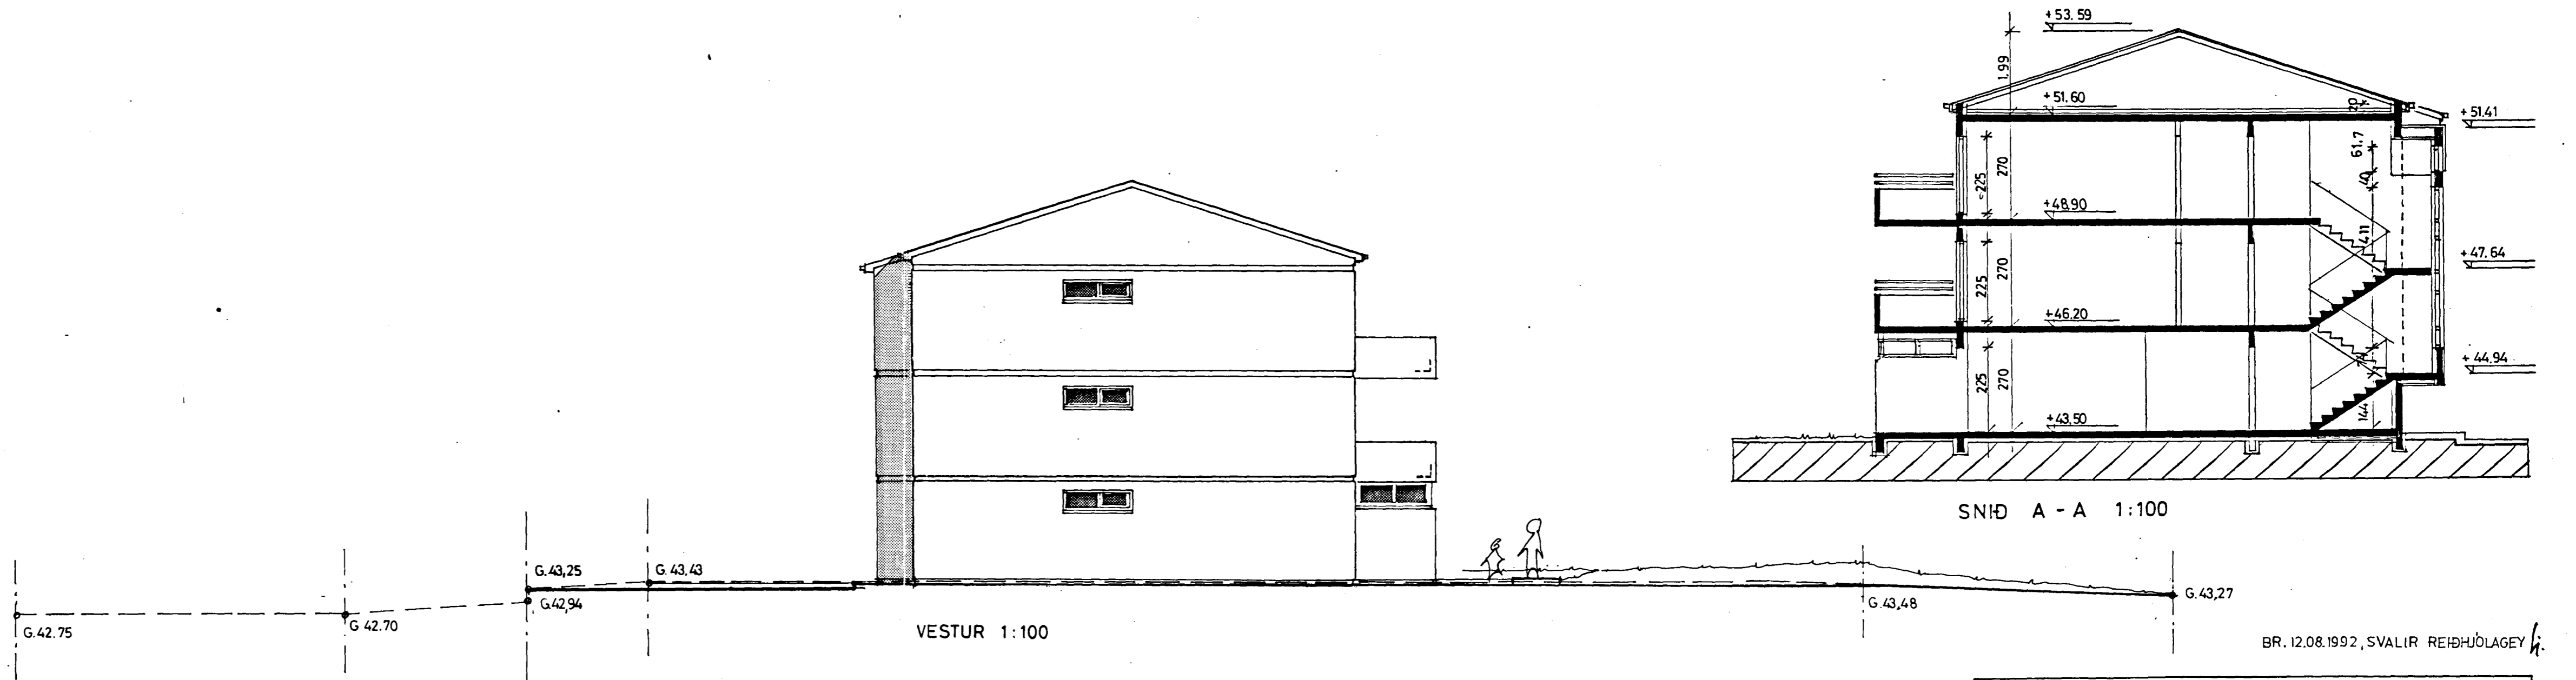


Sambykkt á fundi bygginga-
nefndar þ. 19. 12. 1992

BYGGINGAUFULLTRÚINN
Í HAFNARFIRÐI

1992 LEYFD AFTUR

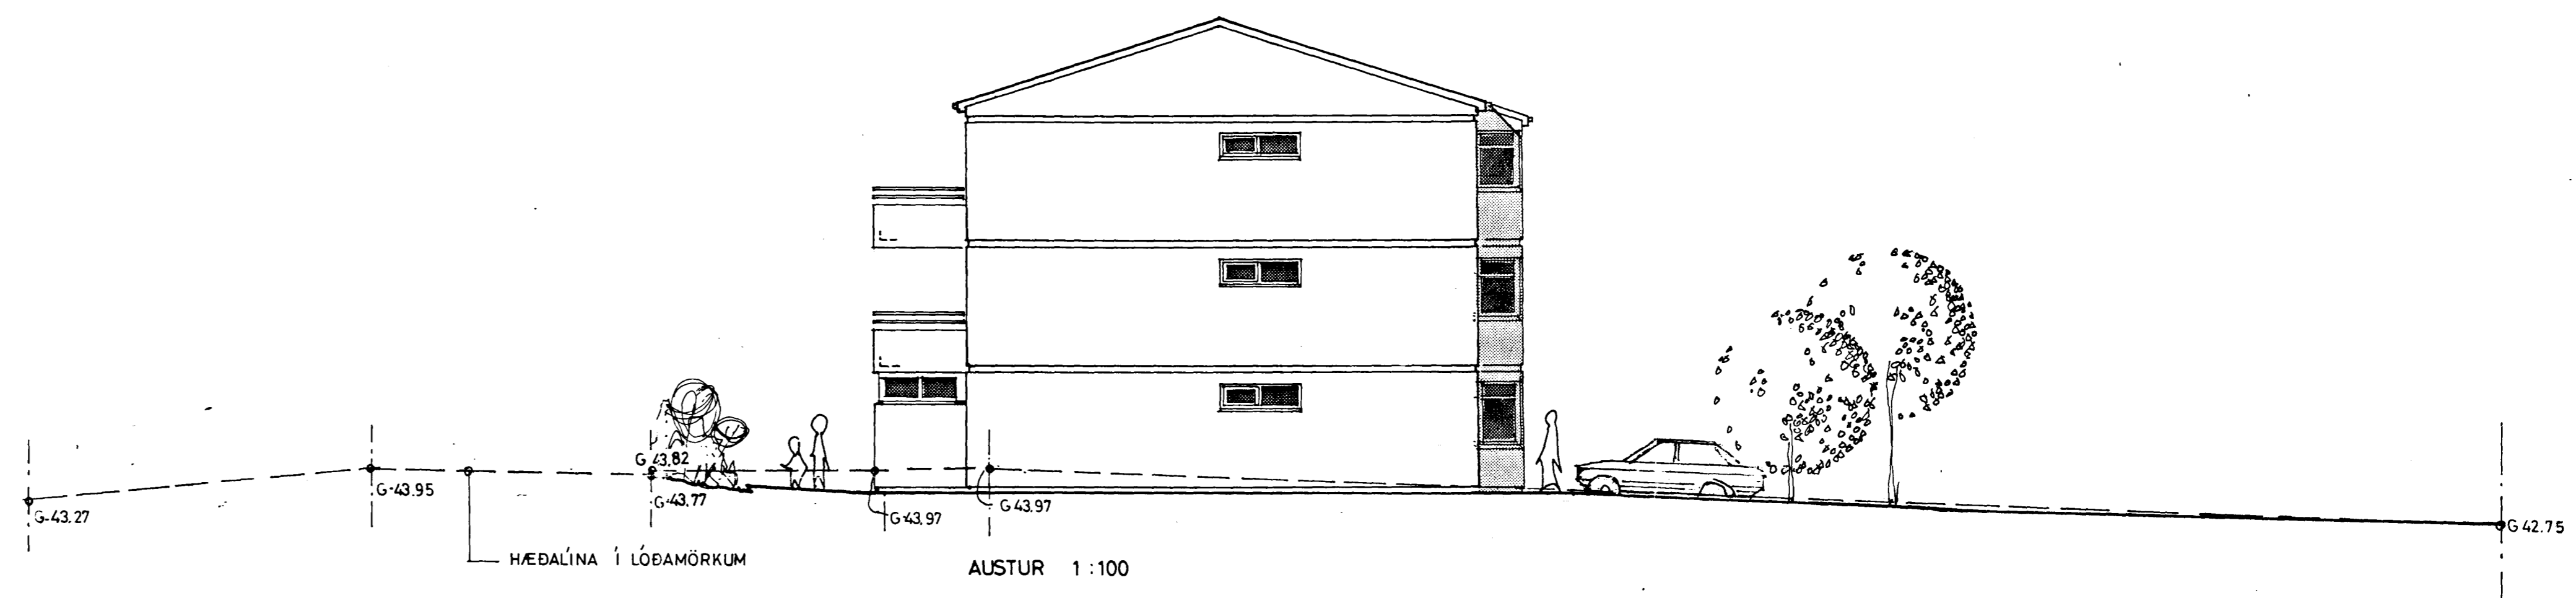

BR. 12.08.1992, SVALIR REIÐHJÚLAGEY

HÁHOLT 10 HAFNARFIRÐI		03
ÚTLITSMYNDIR	1:100	
SNID	1:100	
DAGS. 28.08.'91	MKV. 1:100	HANNAD SA/PVB/TEIKN. A.E
S/GURÞÓR ADALSTEINSSON, ARKITEKT. PÁLL V. BJARNASON, ARKITEKT		
<i>Sigurður Adalsteinsson Páll V. Bjarnason</i>		