


RÚMMYND VATNSLAGNA 1:50

ÁSKILIÐ, ELDRI
TEIKNING ÓGILD

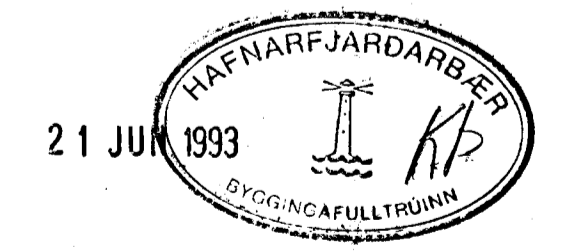

02	11.06.93	LEGLI LAGNA AD BAHN. BE.	GH
01	NÓV '92	LEGLI LAGNA BE.	GH
BR.NR.	DAGS	EDLI BREYTINGAR	SIGN.
HÁNDLT 12 HAFNARFIREI			DAGS NÓV '91
RÚMMYND VATNSLAGNA			HANNAÐ
			TEIKNAD
			VERK NR. 9042
MÆLIKV. 1:50			BLAD NR.
SIGURÐUR ÞORLEIFSSON TEKNIFRÆÐINGUR F.T.F.I.			2-08
STRANDGÖTU 11 HAFNARFIREI SÍMI 54751/54255			