


Afstöðumynd  
1:500

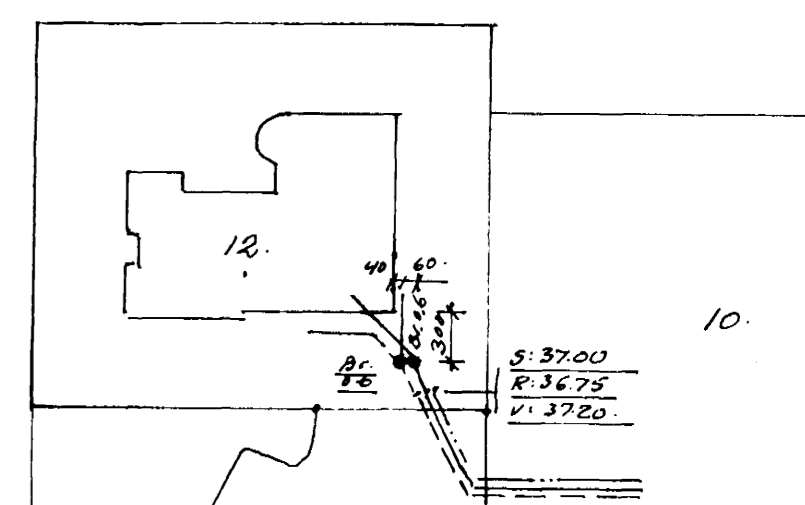


Efni og frágangur vöns-  
og frænnisliagna fylgj-  
i öllum reglum og krötum  
Hafnarh. kaupstæðar.

Benedikt B. Sigrúðsson  
verkfr.

Hafnarmur nr. 12. Hf.

M.	1:50	Frænnisliögn
D.	sept. '80	Grunnloagn.
		Afstöðumynd.
Nr.	1. bl.	Bun. B. Sigrúðsson

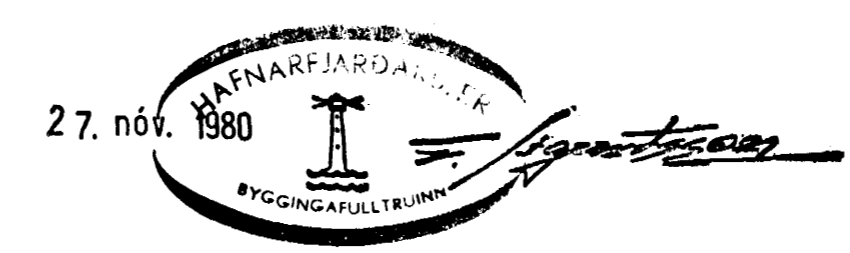

20/10/80  
G.M.