

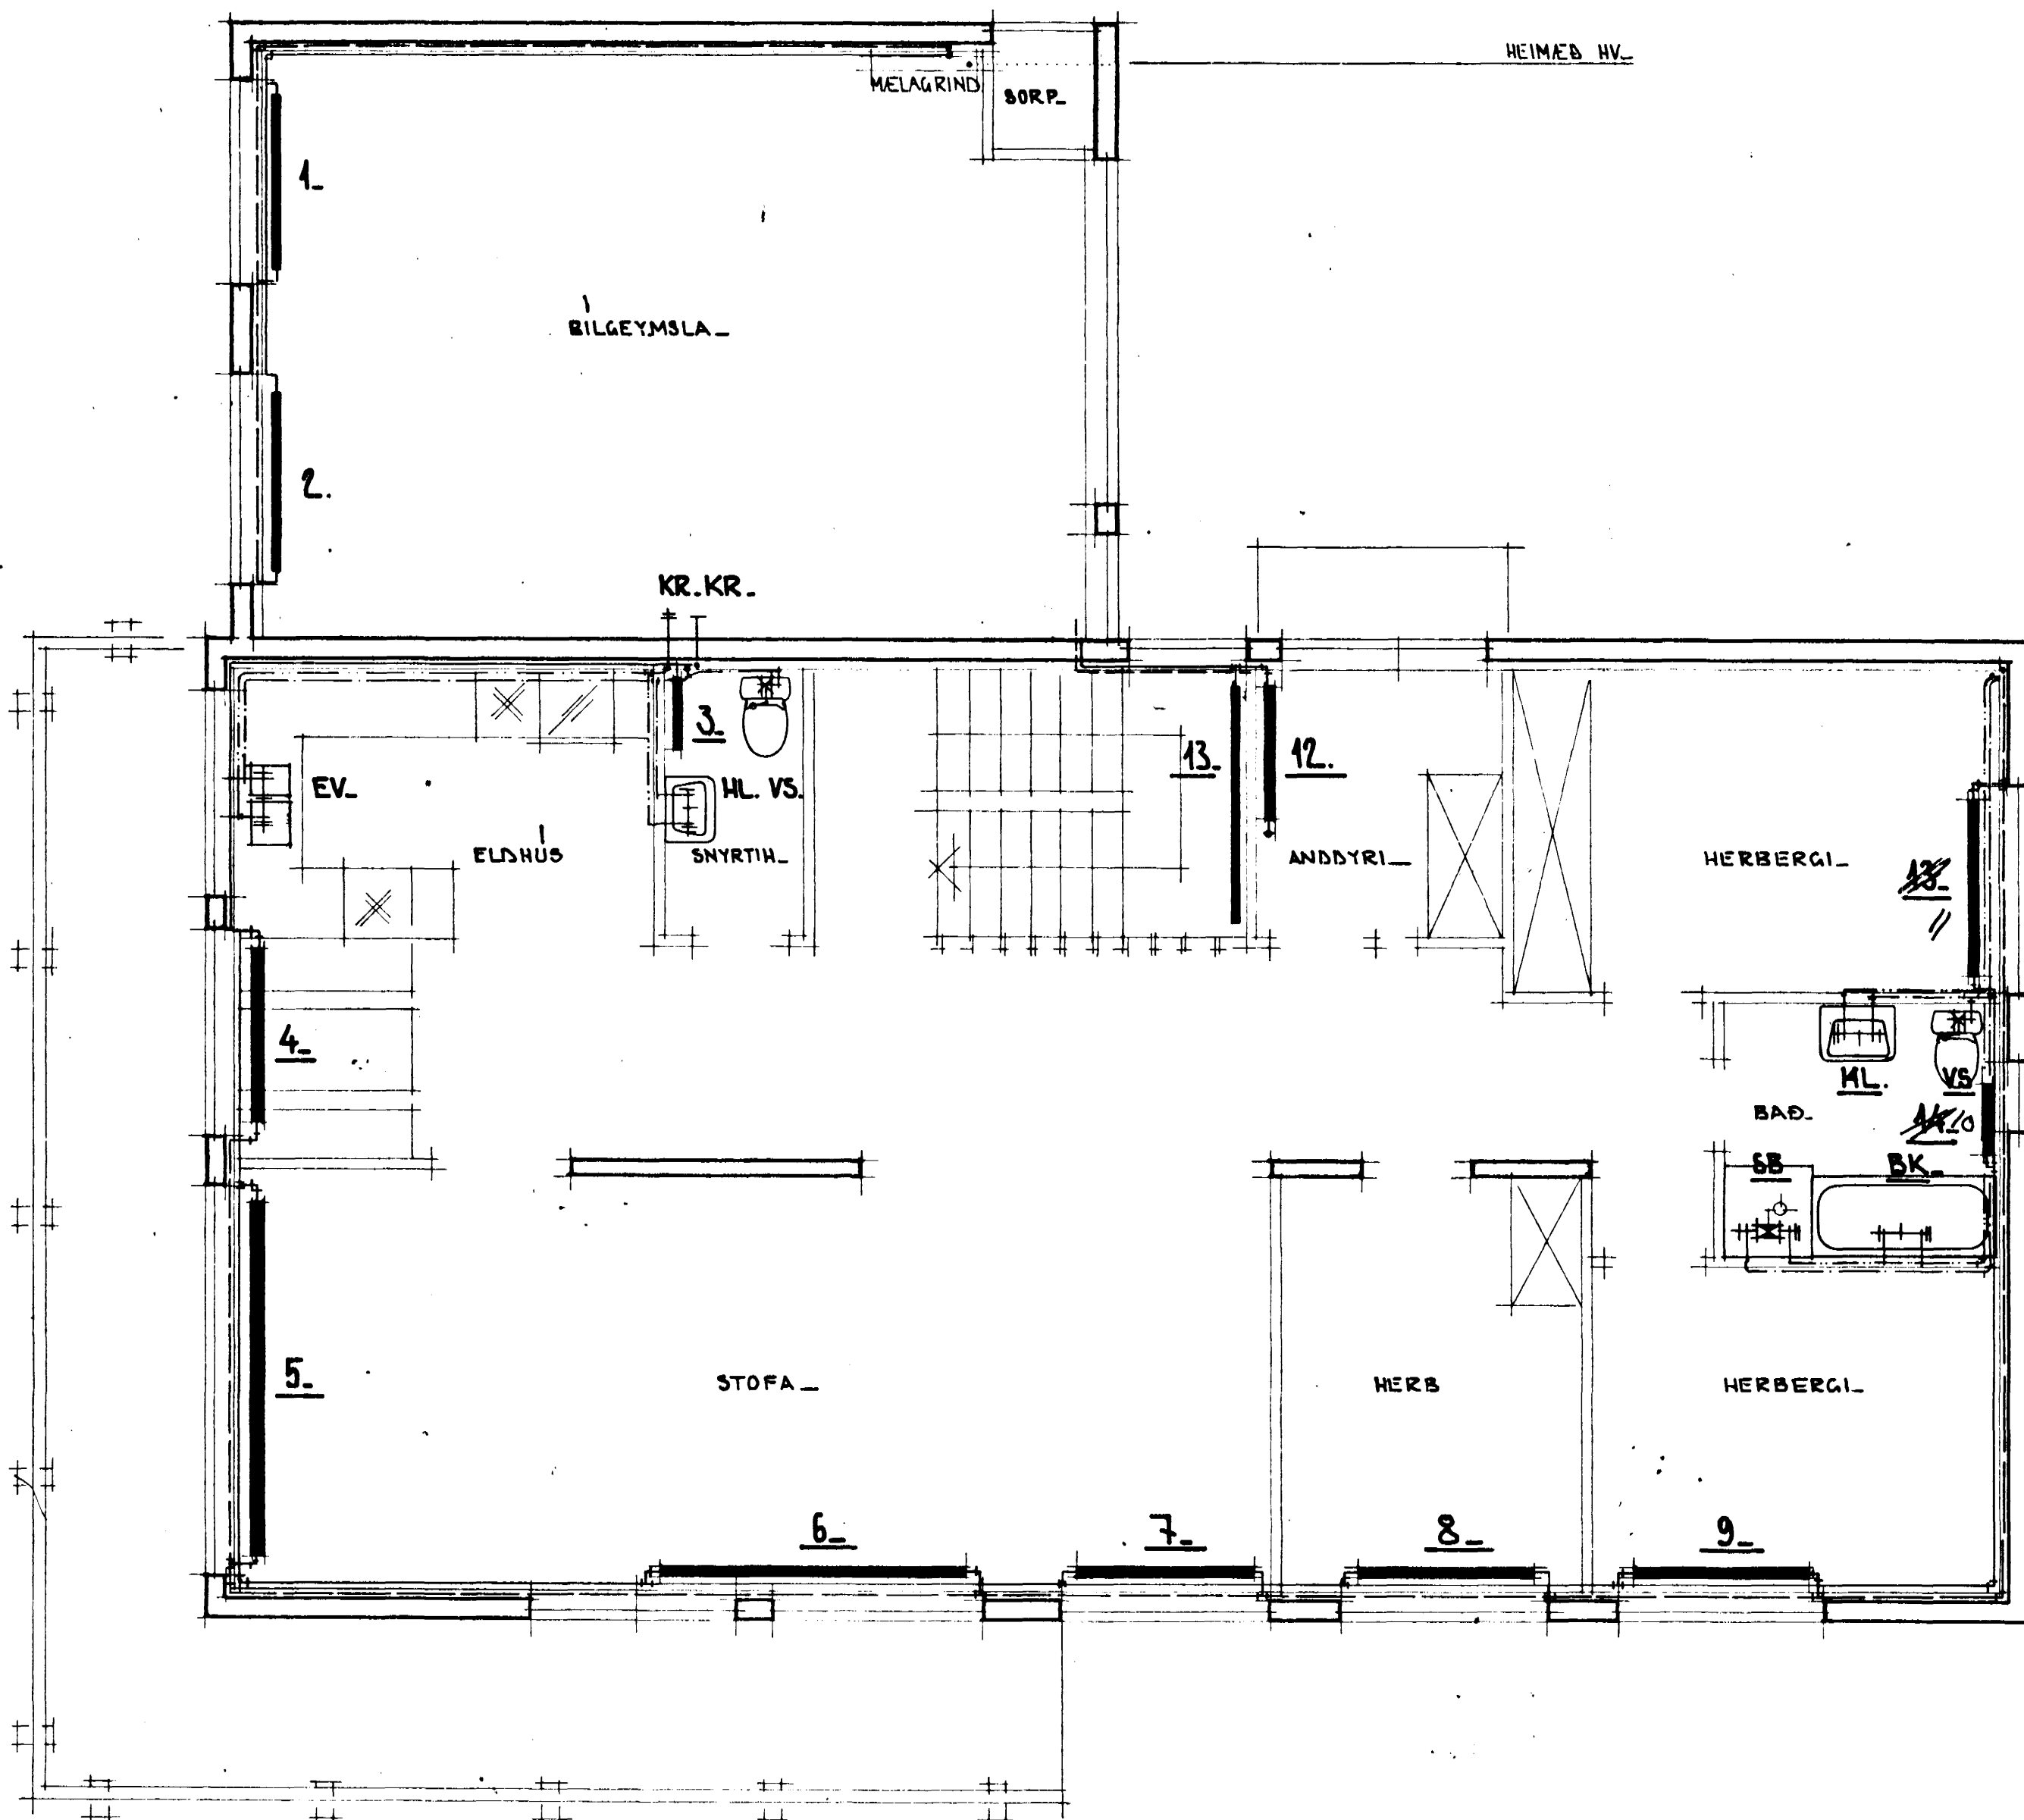


HÁIHVAMMUR 14

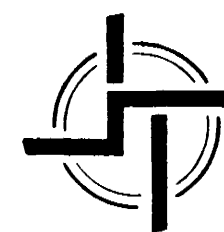

GRUNNMYND EFRÍ HÆÐAR. 1:50.

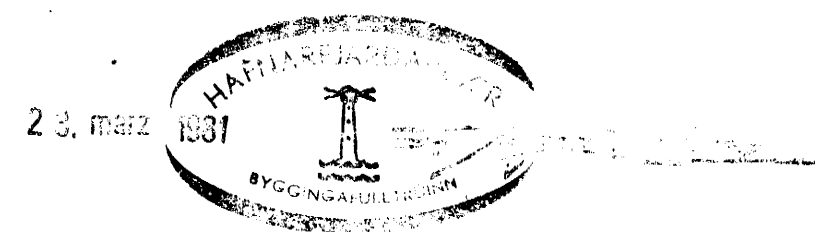

STADALHÚS

TEIKNISTOFA SÍÐUMÚLA 31 SÍMI 83141

VERKEFNI	DAGS.	1980.	VERK NR
HITA OG NEYZZLUVATNSLAGNIR.	MKV.	4:50.	SU 43
HÁIHVAMMUR 14. HAFNARFIRÐI	BR. MARZ 1981. 572.		
	BLAD NR	3.03	

Sigurdur Gudmundsson *Sigurdur P. Kristjánsson*
 SIGURDUR GUDMUNDSSON SIGURDUR P. KRISTJÁNSSON FTFÍ