


GARÐVATN TÖMING

RENNILOKI FÖRIR  
GARÐVATN

RENNILOKI Í JÖRD  
DYPI 120 CM  
RÖR UM SPINDIL


KALT VATN HEIMÆÐ Ø 32

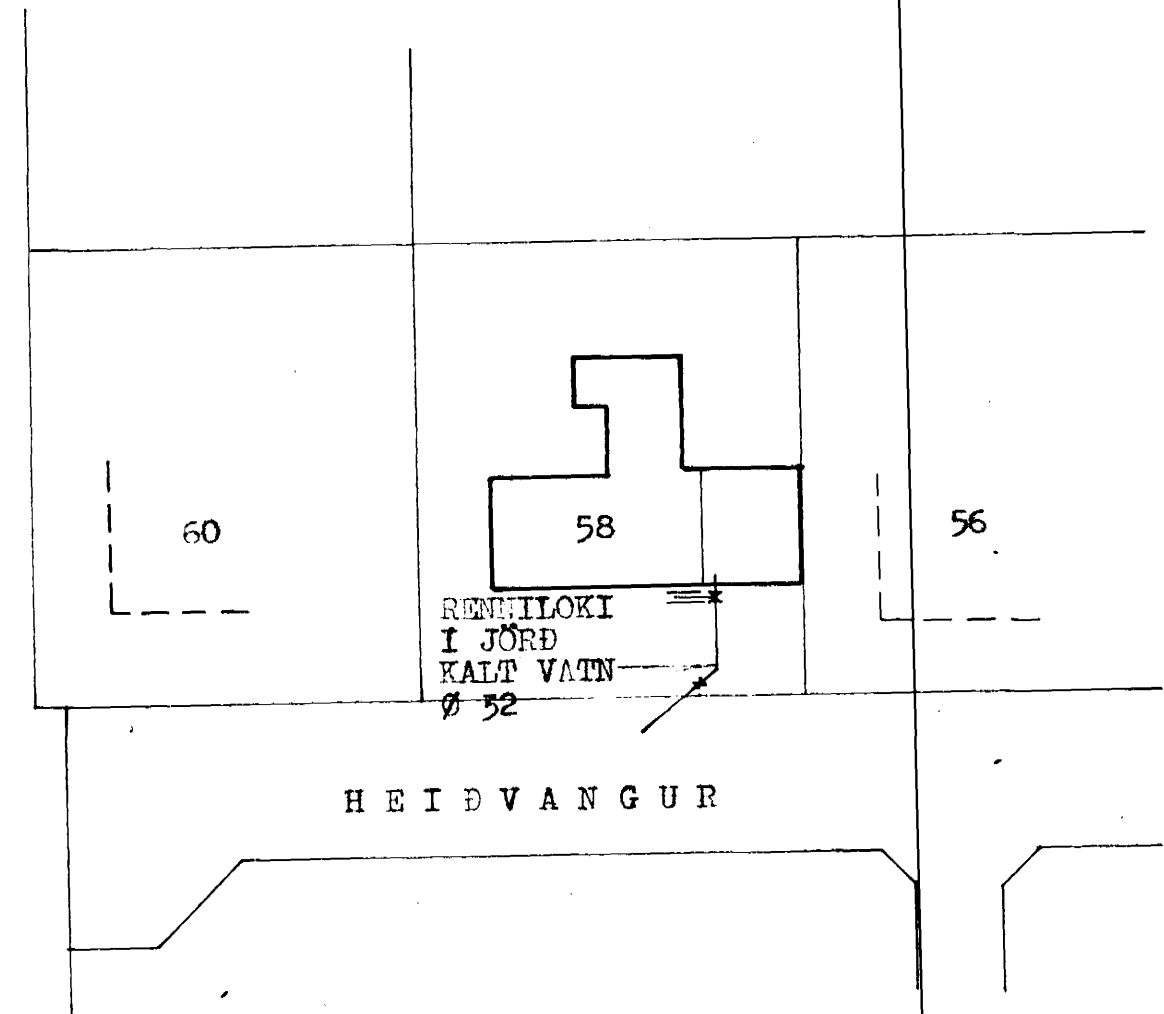

RENNILOKI  
Í JÖRD  
KALT VATN  
Ø 32

HEIÐVANGUR

AFSTADA 1:500

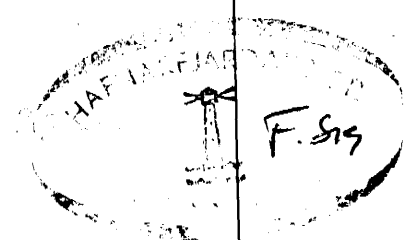

STEINGRIMUR TH. ÞORLEIFSSON MFI		
HEIÐVANGUR NR. 58 HAFNARFIRÐI		
MÁL	1:50	VATNSLAGHIR
DAGS.	OKT. 1973	KJALLARÁ GRUNNMYND