





Samþykkt þann

09 JUNI 1997


Byggingafultrúinn í Hafnarfirði
Erlendur Hjalmarsson

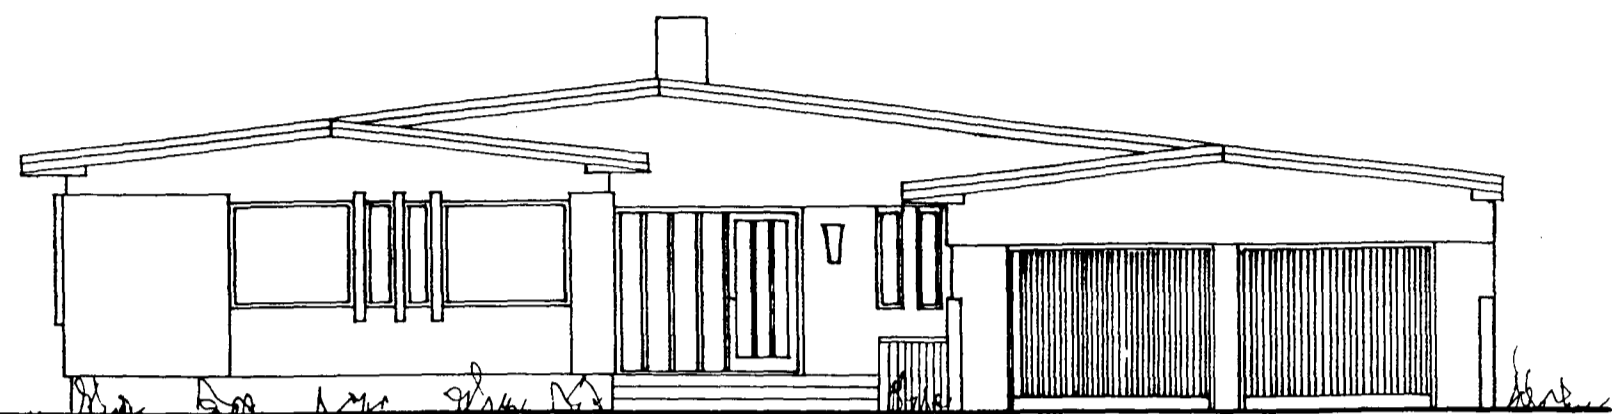


AUSTUR

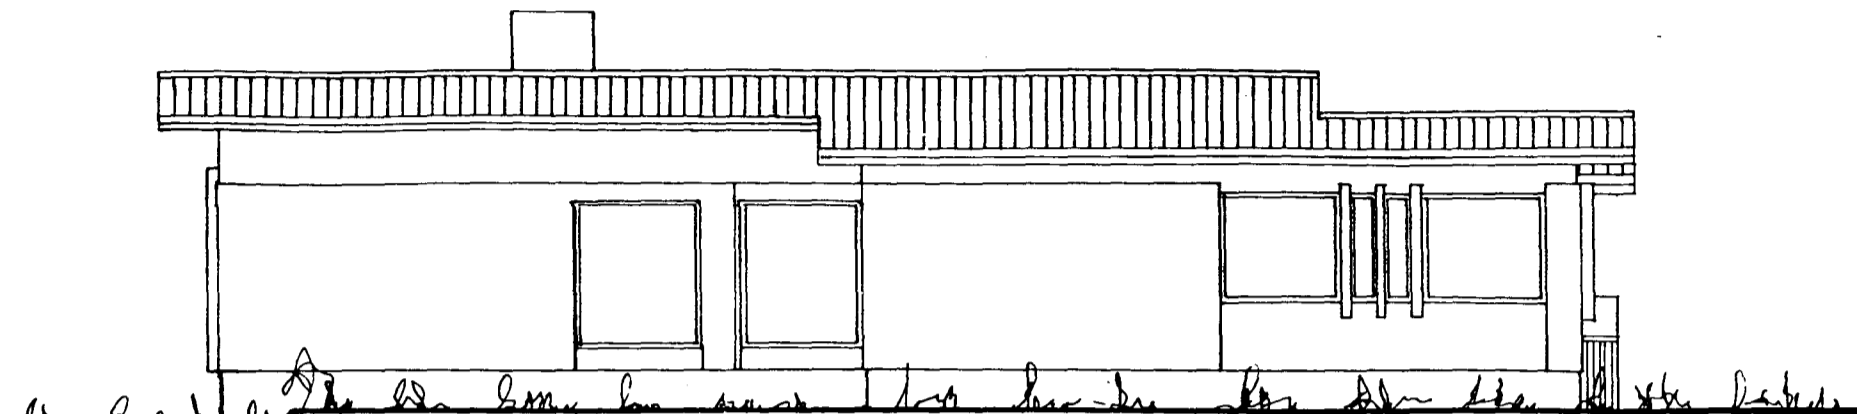


SUÐUR

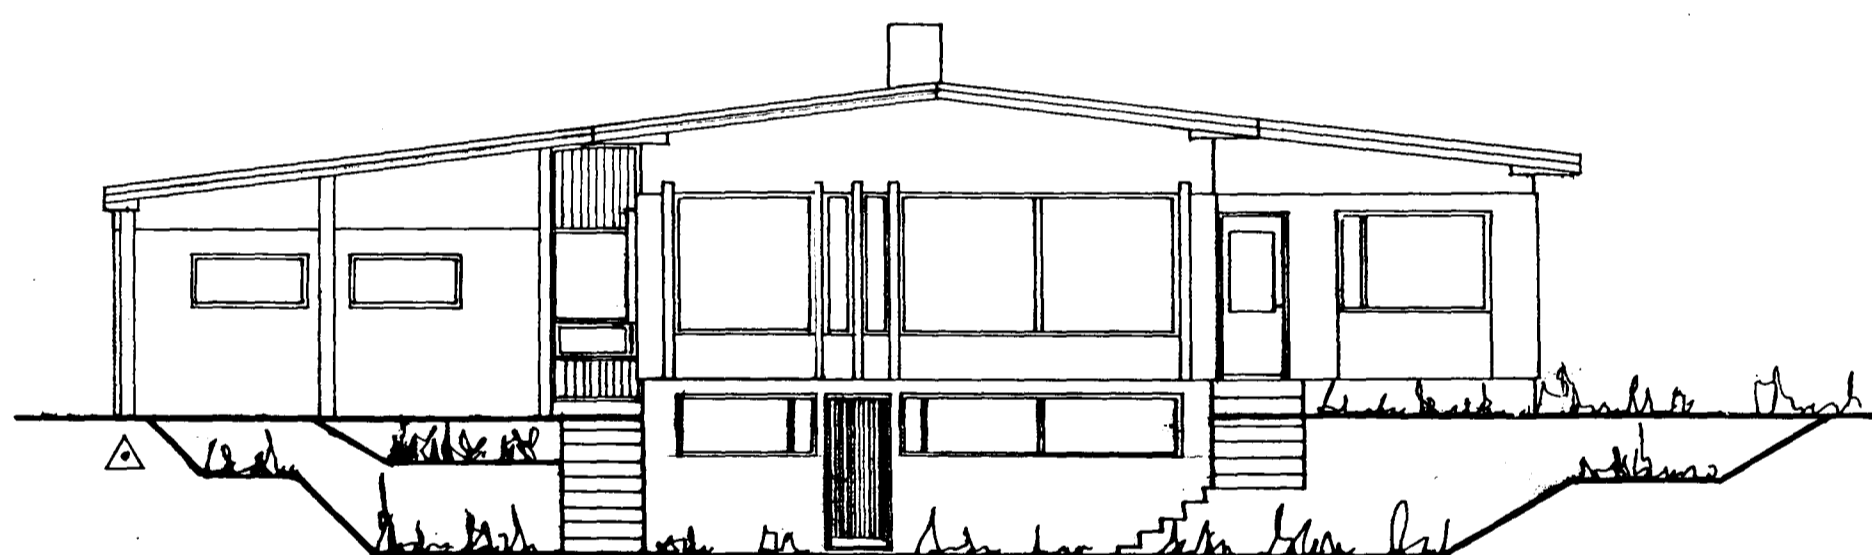

VESTUR

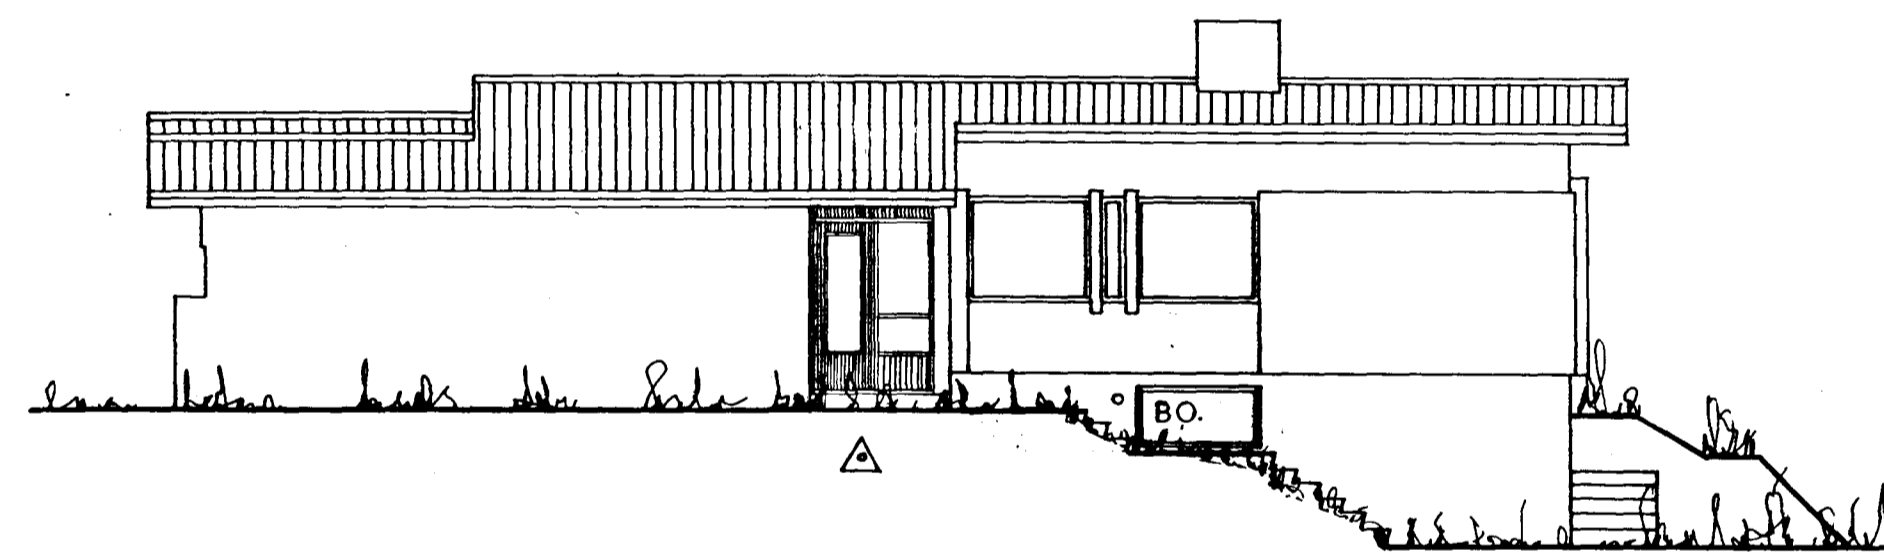

NORDUR

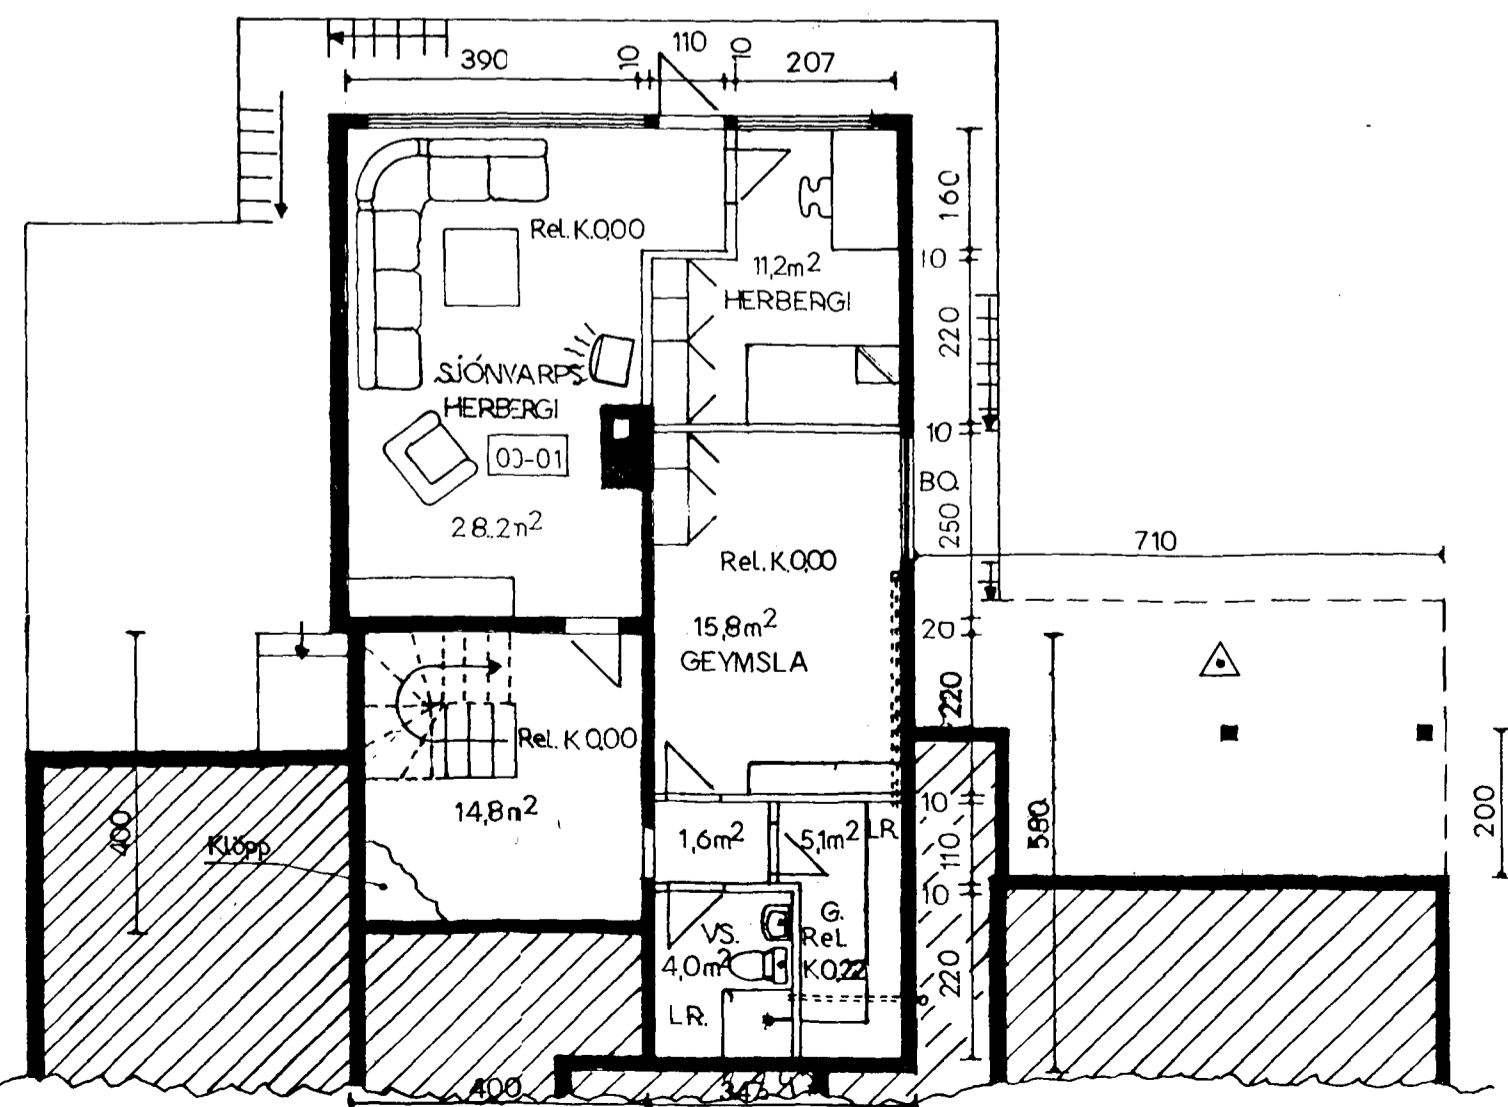

KJALLARI

STÆRDIR EFTIR BREYTINGU:

	FYRIR BR.		STÆKKUN.		EFTIR BR.	
00-01 KJALLARÍ	75,9m ²	191 m ³	16,0m ²	41m ³	91,9m ²	232m ³
01-01 Í HÆÐ ÍBÚÐ	155,0m ²	553m ³	0	0	155,0m ²	553m ³
01-03 BÍLGEYMSLA	53,1m ²	133m ³	0	41m ³ (PAK)	53,1m ²	174m ³
01-02 GANGUR	0	0	6,6 m ²	23 m ³	6,6m ²	23m ³
△ SAMTALS	284,0m ²	877 m ³	22,6 m ²	105 m ³	306,6m ²	982 m ³

△ BREYTING Á ÁÐUR SAMÞYKKTUM
UPPDÆTTI 04 OKT 1995.

BLAD I.

HEIÐVANGUR NR. 6

ÚTLIT 1:100

GRUNNMYND KJALLARA 1:100

HAFNARFIRÐI MAÍ 1997

Erlendur Hjalmarsson / *Árni Þorláksson*