


HEIDVANGUR

AFSTADA 1:500

**SKYRINGAR:**

ALL HERRI OG FRAGANGUR LAGNA SÖ SAMKV.  
 AÐGLUGERD UM MÖRASI I REYKJAVIK OG  
 BYGGINGARSAMM.

BREYTT I OKT. 1973 *S. V. [Signature]*

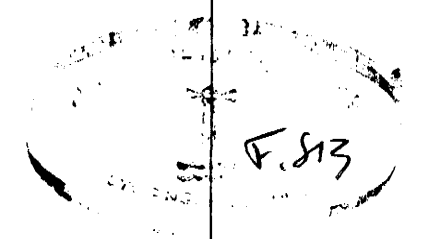

STEINGRINUR TH. ÞORLEIFSSON RTFI		
HEIDVANGUR NR. 74 HANNAFIRÐI		
MÁL	1:50 1:500	FRAMTÍÐSLI GAUMMÖND OG AFSTADA
DAGS.	JULI 1973	
BLAD	5	<i>S. V. [Signature]</i>