


AFSTADA 1:500

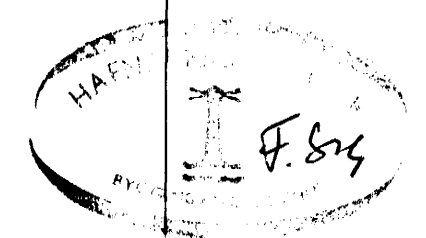

BREYTT Í OKT. 1973 *S. Th. for min*

STEING INUR TH. ÞORGEIRSSON AFI		
HEIDVANGUR Nr. 74 HAFNARFIRÐI		
MÁL	1:50 1:500	VAENSLAGHIR GAUNNLYND OG AFSTFA
DAGS.	JUNI 1973	
BLAÐ	6	<i>S. Th. for min</i>