
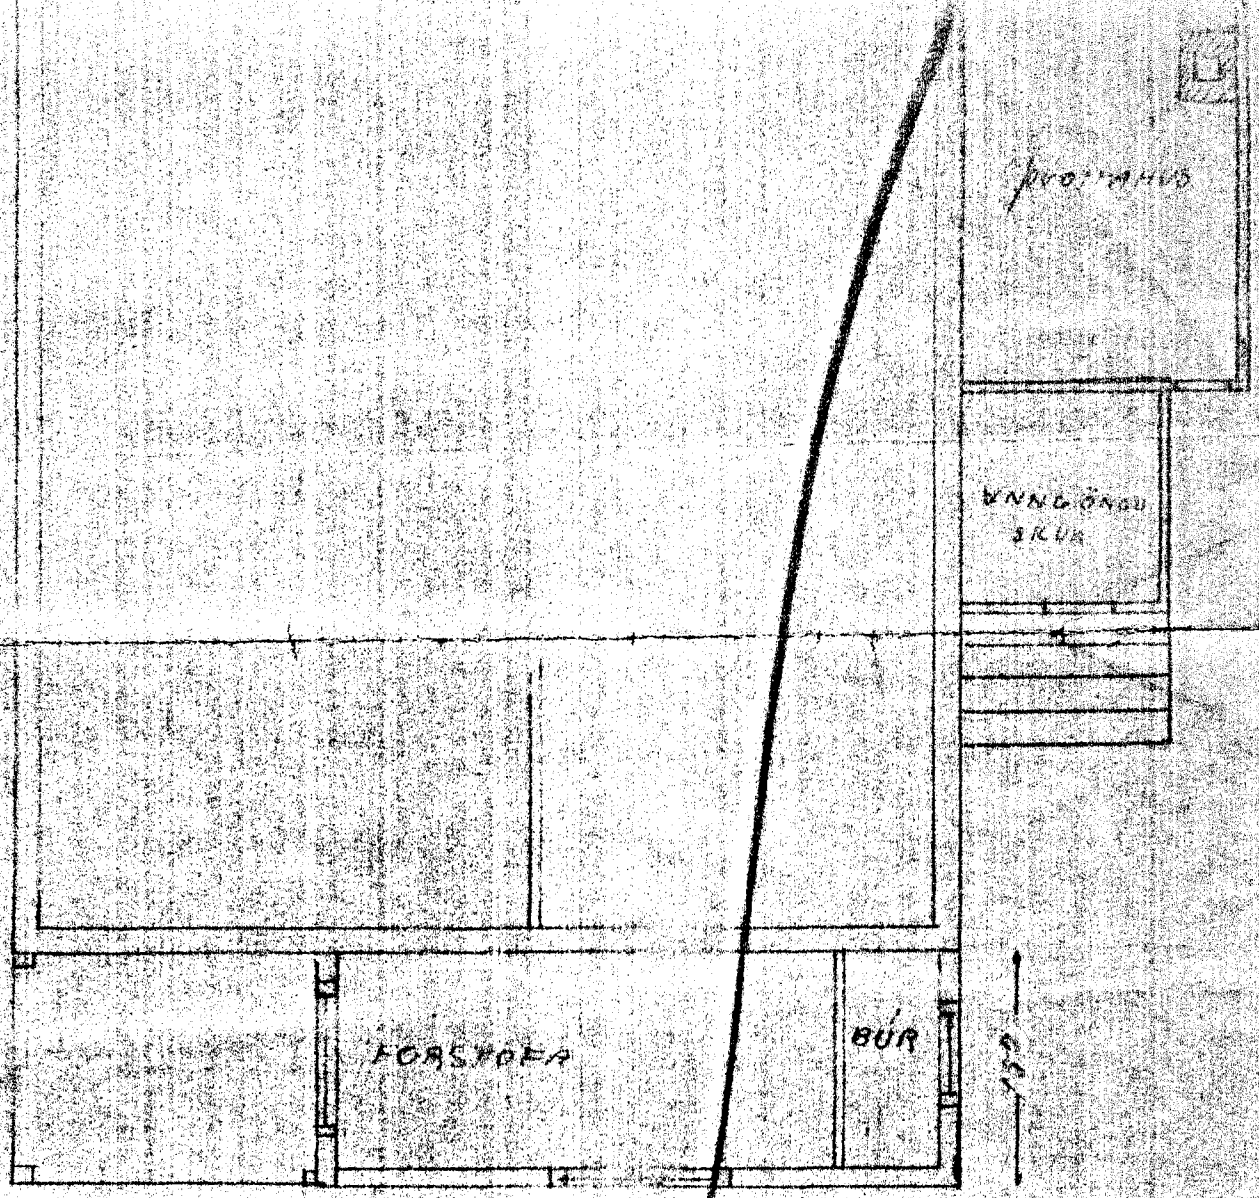


HUS SIGFUSAR ÞÓRPARSONAR KIRKJUVEG


HAFNARFIADL

SUÐURHLÍÐ

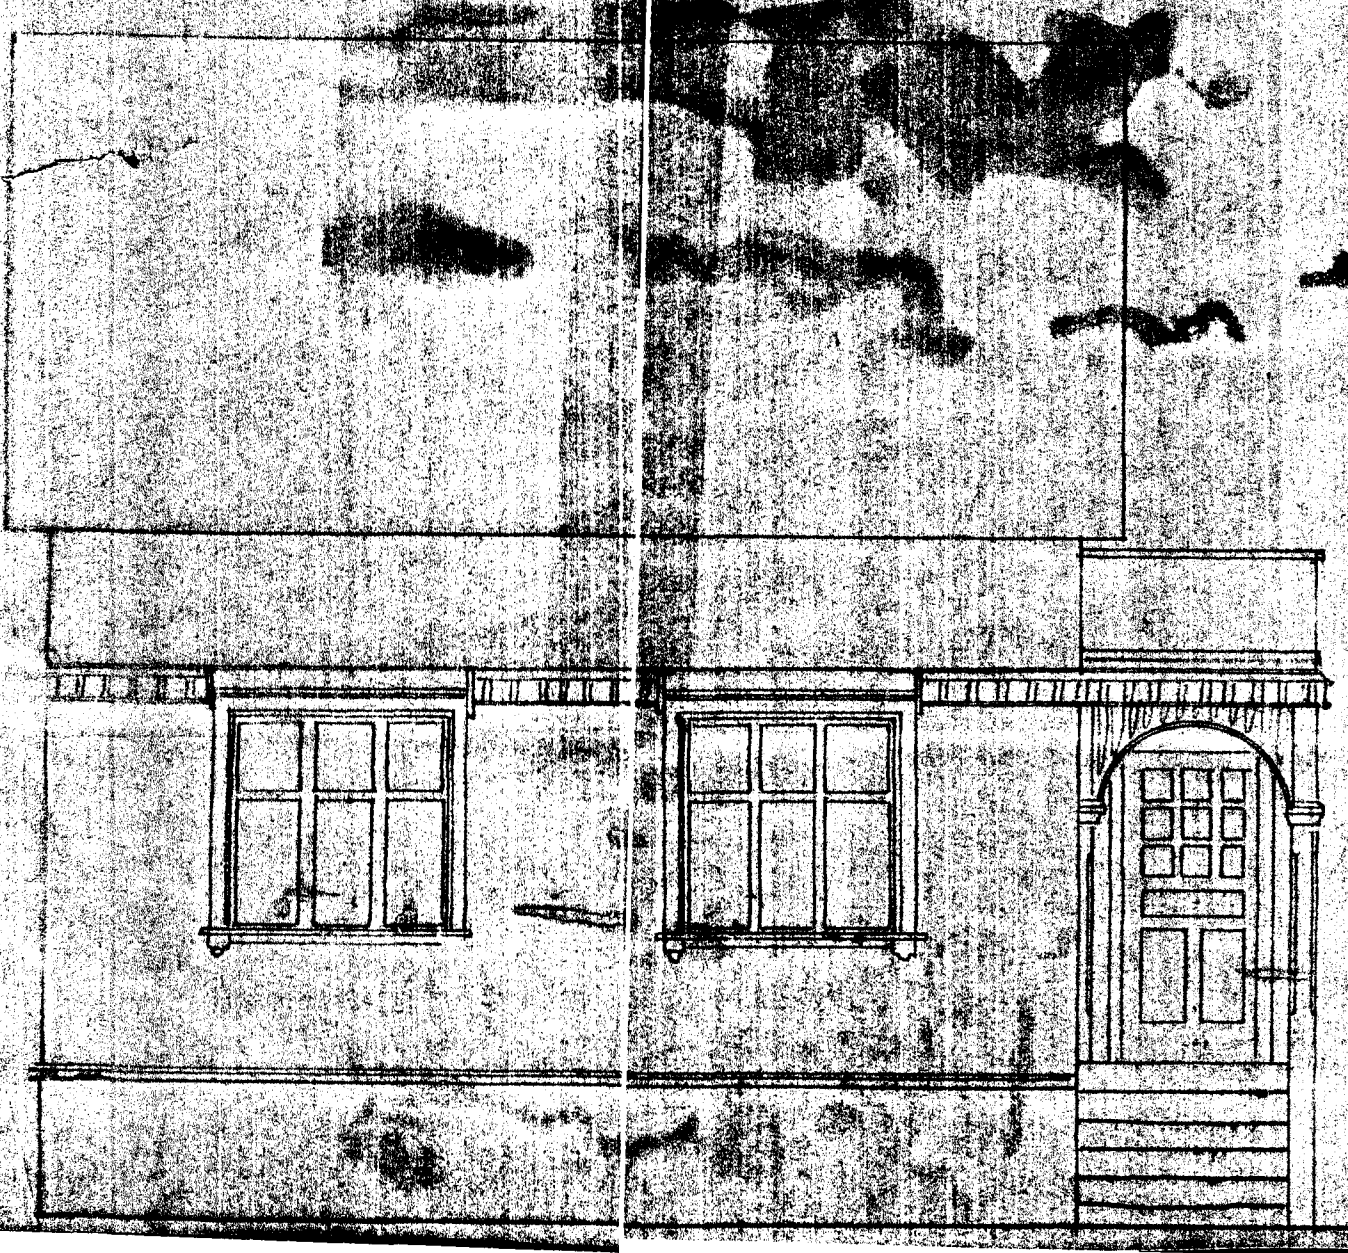

AUSTURGAFL

KIRKJUV. 12

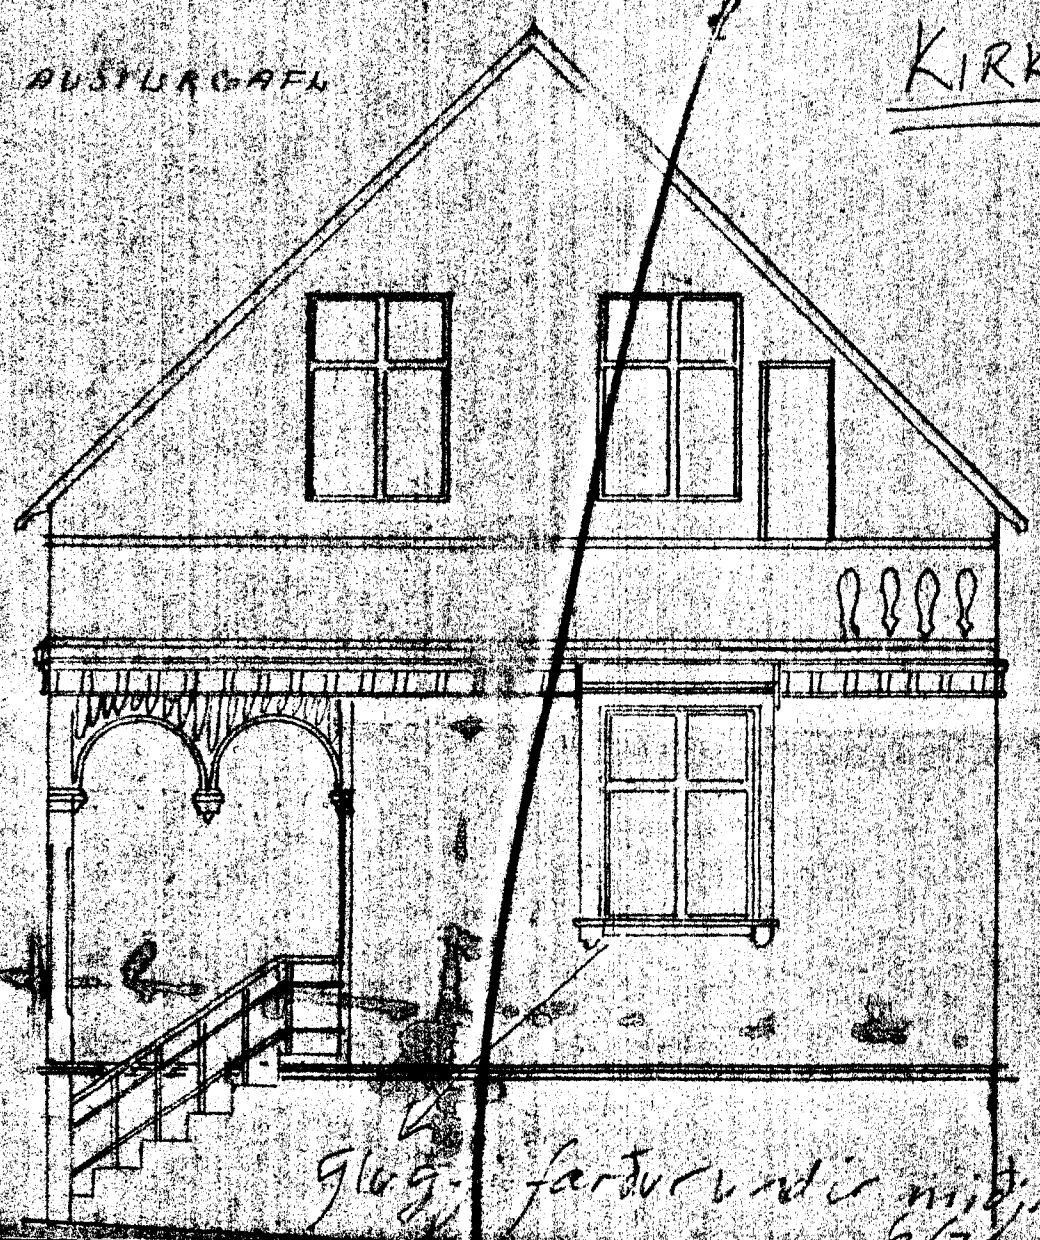

Kv. 150
Hf. 5 j. 1814
246

Glag. fartur er midjan gaff
6/7 Ertol. Havn.